


PUMPING PLAN


SCALE $\frac{1}{8}'' = 1 \text{ FOOT}$

No 25 SHIP

Equip. U.O.T. = 2070

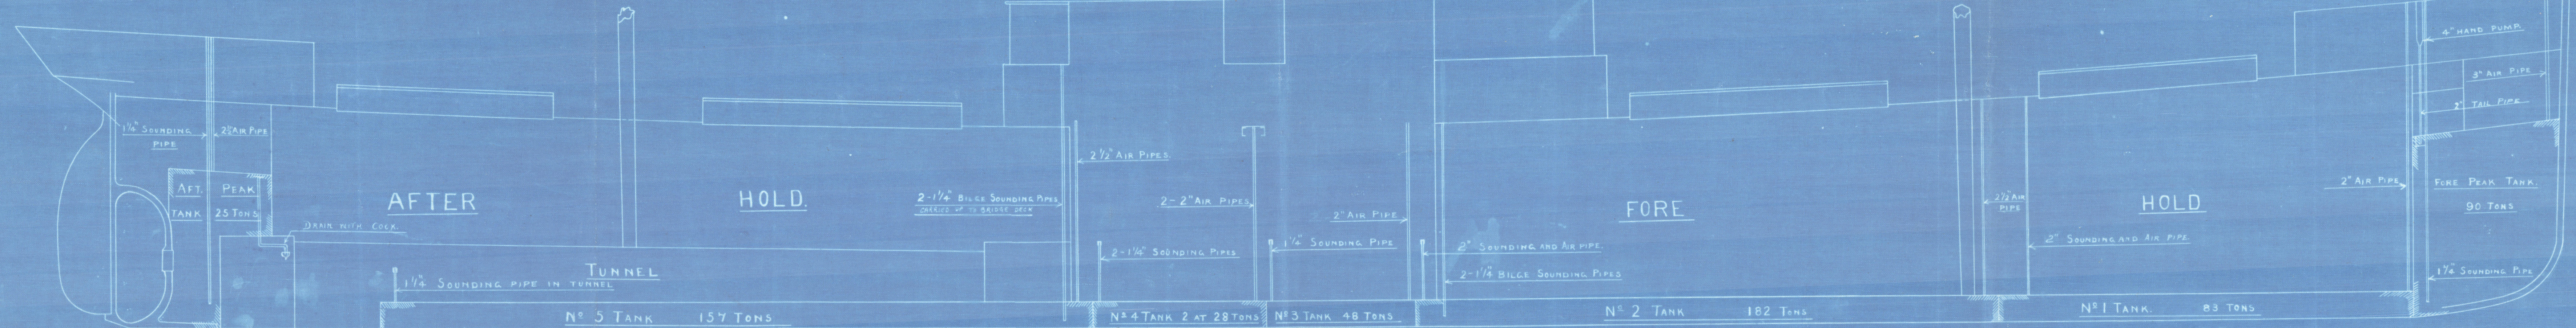

DOWNKON PUMP TO BE FITTED.
4 1/2\" fitted on strong beam in engine casing

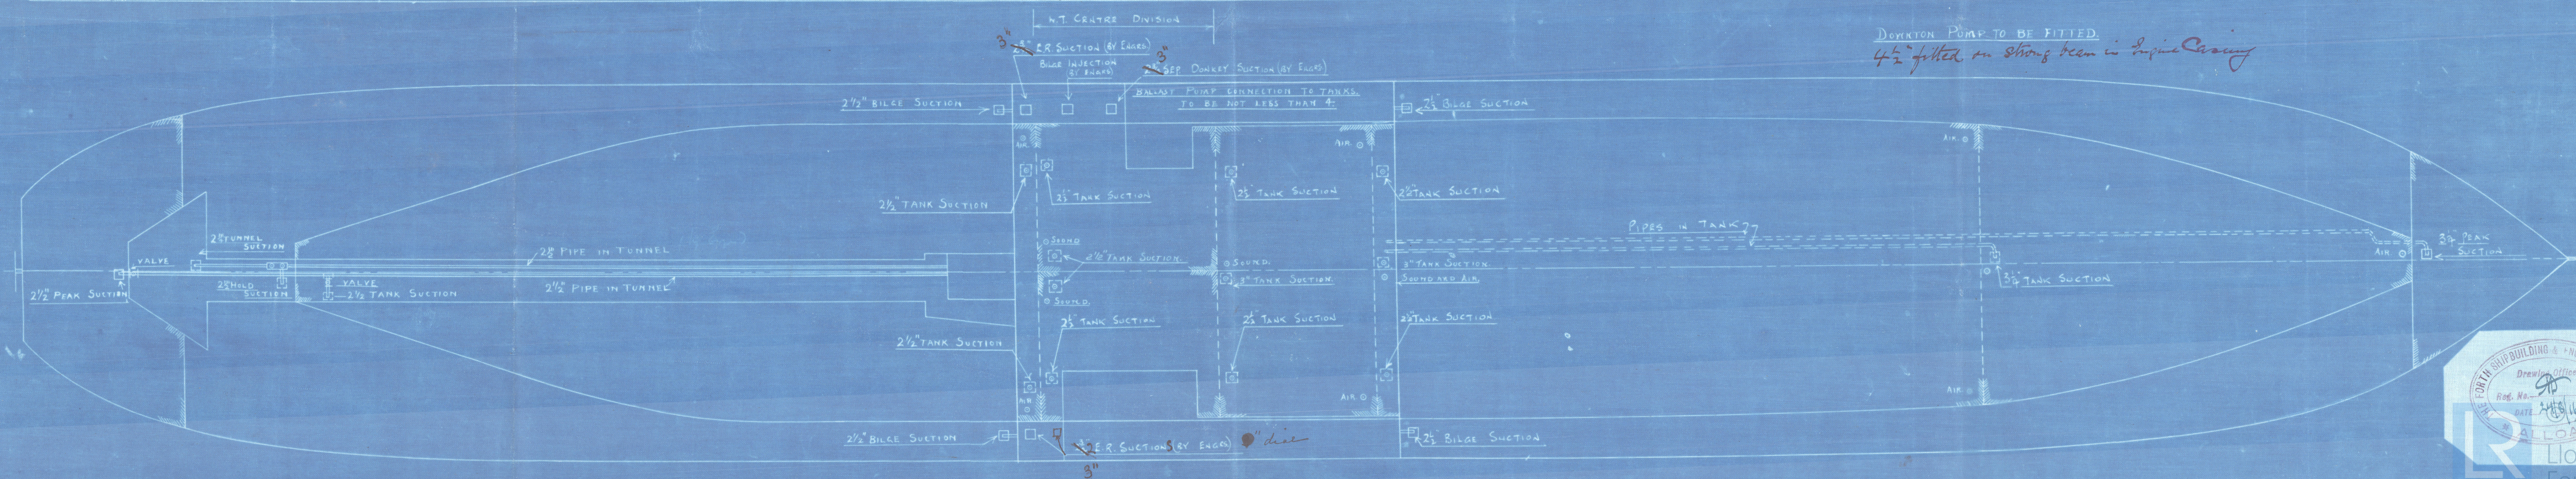

W941-0163


S.S. N° 25

Pumping Arrangements

Forth Ship - G. Co. L^r.

Alloa

s/s. "Countess of Mar"

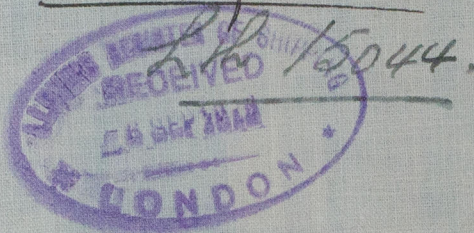

SS COUNTESS OF MAR
NEWCASTLE ON TYNE.

Report No. 69255



W941-0163



© 2020

Lloyd's Register
Foundation