



Vessel building at the
 Sheer plan Works of Messrs J. M. Lane & Sons Scale $\frac{3}{16}'' = 1'$
 for the D.H. & P. Co "Samoa"

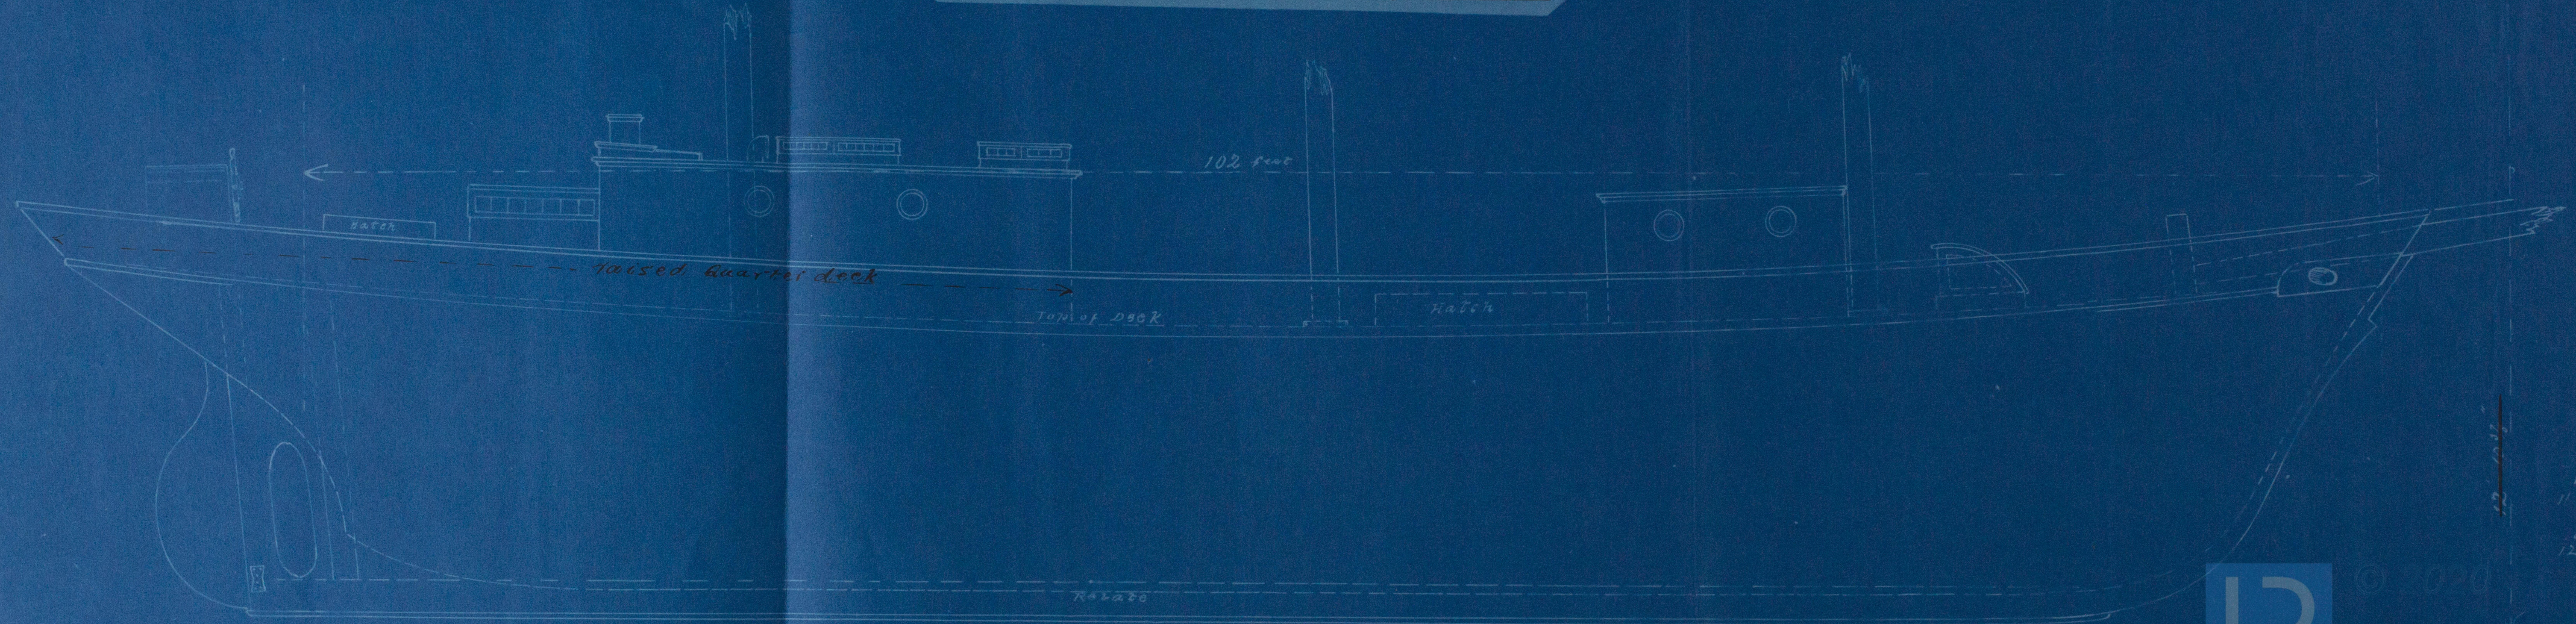

W 441-0227

 J. M. Lane & Sons
 78 x 12
 12 x 12

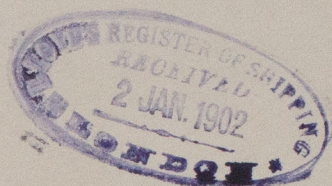

W941-0227

RECEIVED



© 2020

Lloyd's Register
Foundation