


# No 534 MIDSHIP SECTION

355'-0" x 49'-0" M<sup>LD</sup> x 26'-6" M<sup>LD</sup>

SCALE 1/2" = 1 FOOT

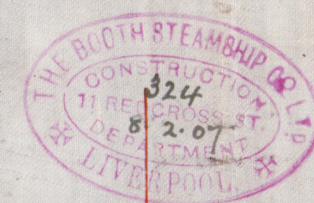


18.2.07  
22.4.07.  
1.5.07  
25.5.07  
31.5.07  
11.6.07  
20.6.07  
15.7.07  
SHEERSTRAKE 40x 1/20 TO 7/20  
OVERLAPPED BUTTS QUADRUPLE  
RIVETED FOR 1/2 LENGTH

49  
SHEERSTRAKE 60x 12-9/20  
OVERLAPPED BUTTS QUADRUPLE  
RIVETED FOR 1/2 LENGTH  
TREBLE AT ENDS.

69 x 12-9/20  
57 x 12-9/20  
69 x 12-9/20

14-7/8 rivets in each flange  
with full nut and washers  
ALTERNATIVE SKETCH  
MARGIN PLATE.  
FLOOR.  
KNEE  
3/2 x 3/2 x 1/20 AT ENDS  
64 x 13-10/20  
3/2 x 3/2 x 1/20

14-7/8 rivets in each flange  
with full nut and washers  
AT ENDS  
FLOOR  
KNEE  
3/2 x 3/2 x 1/20 FOR 1/2 L  
64 x 13-10/20

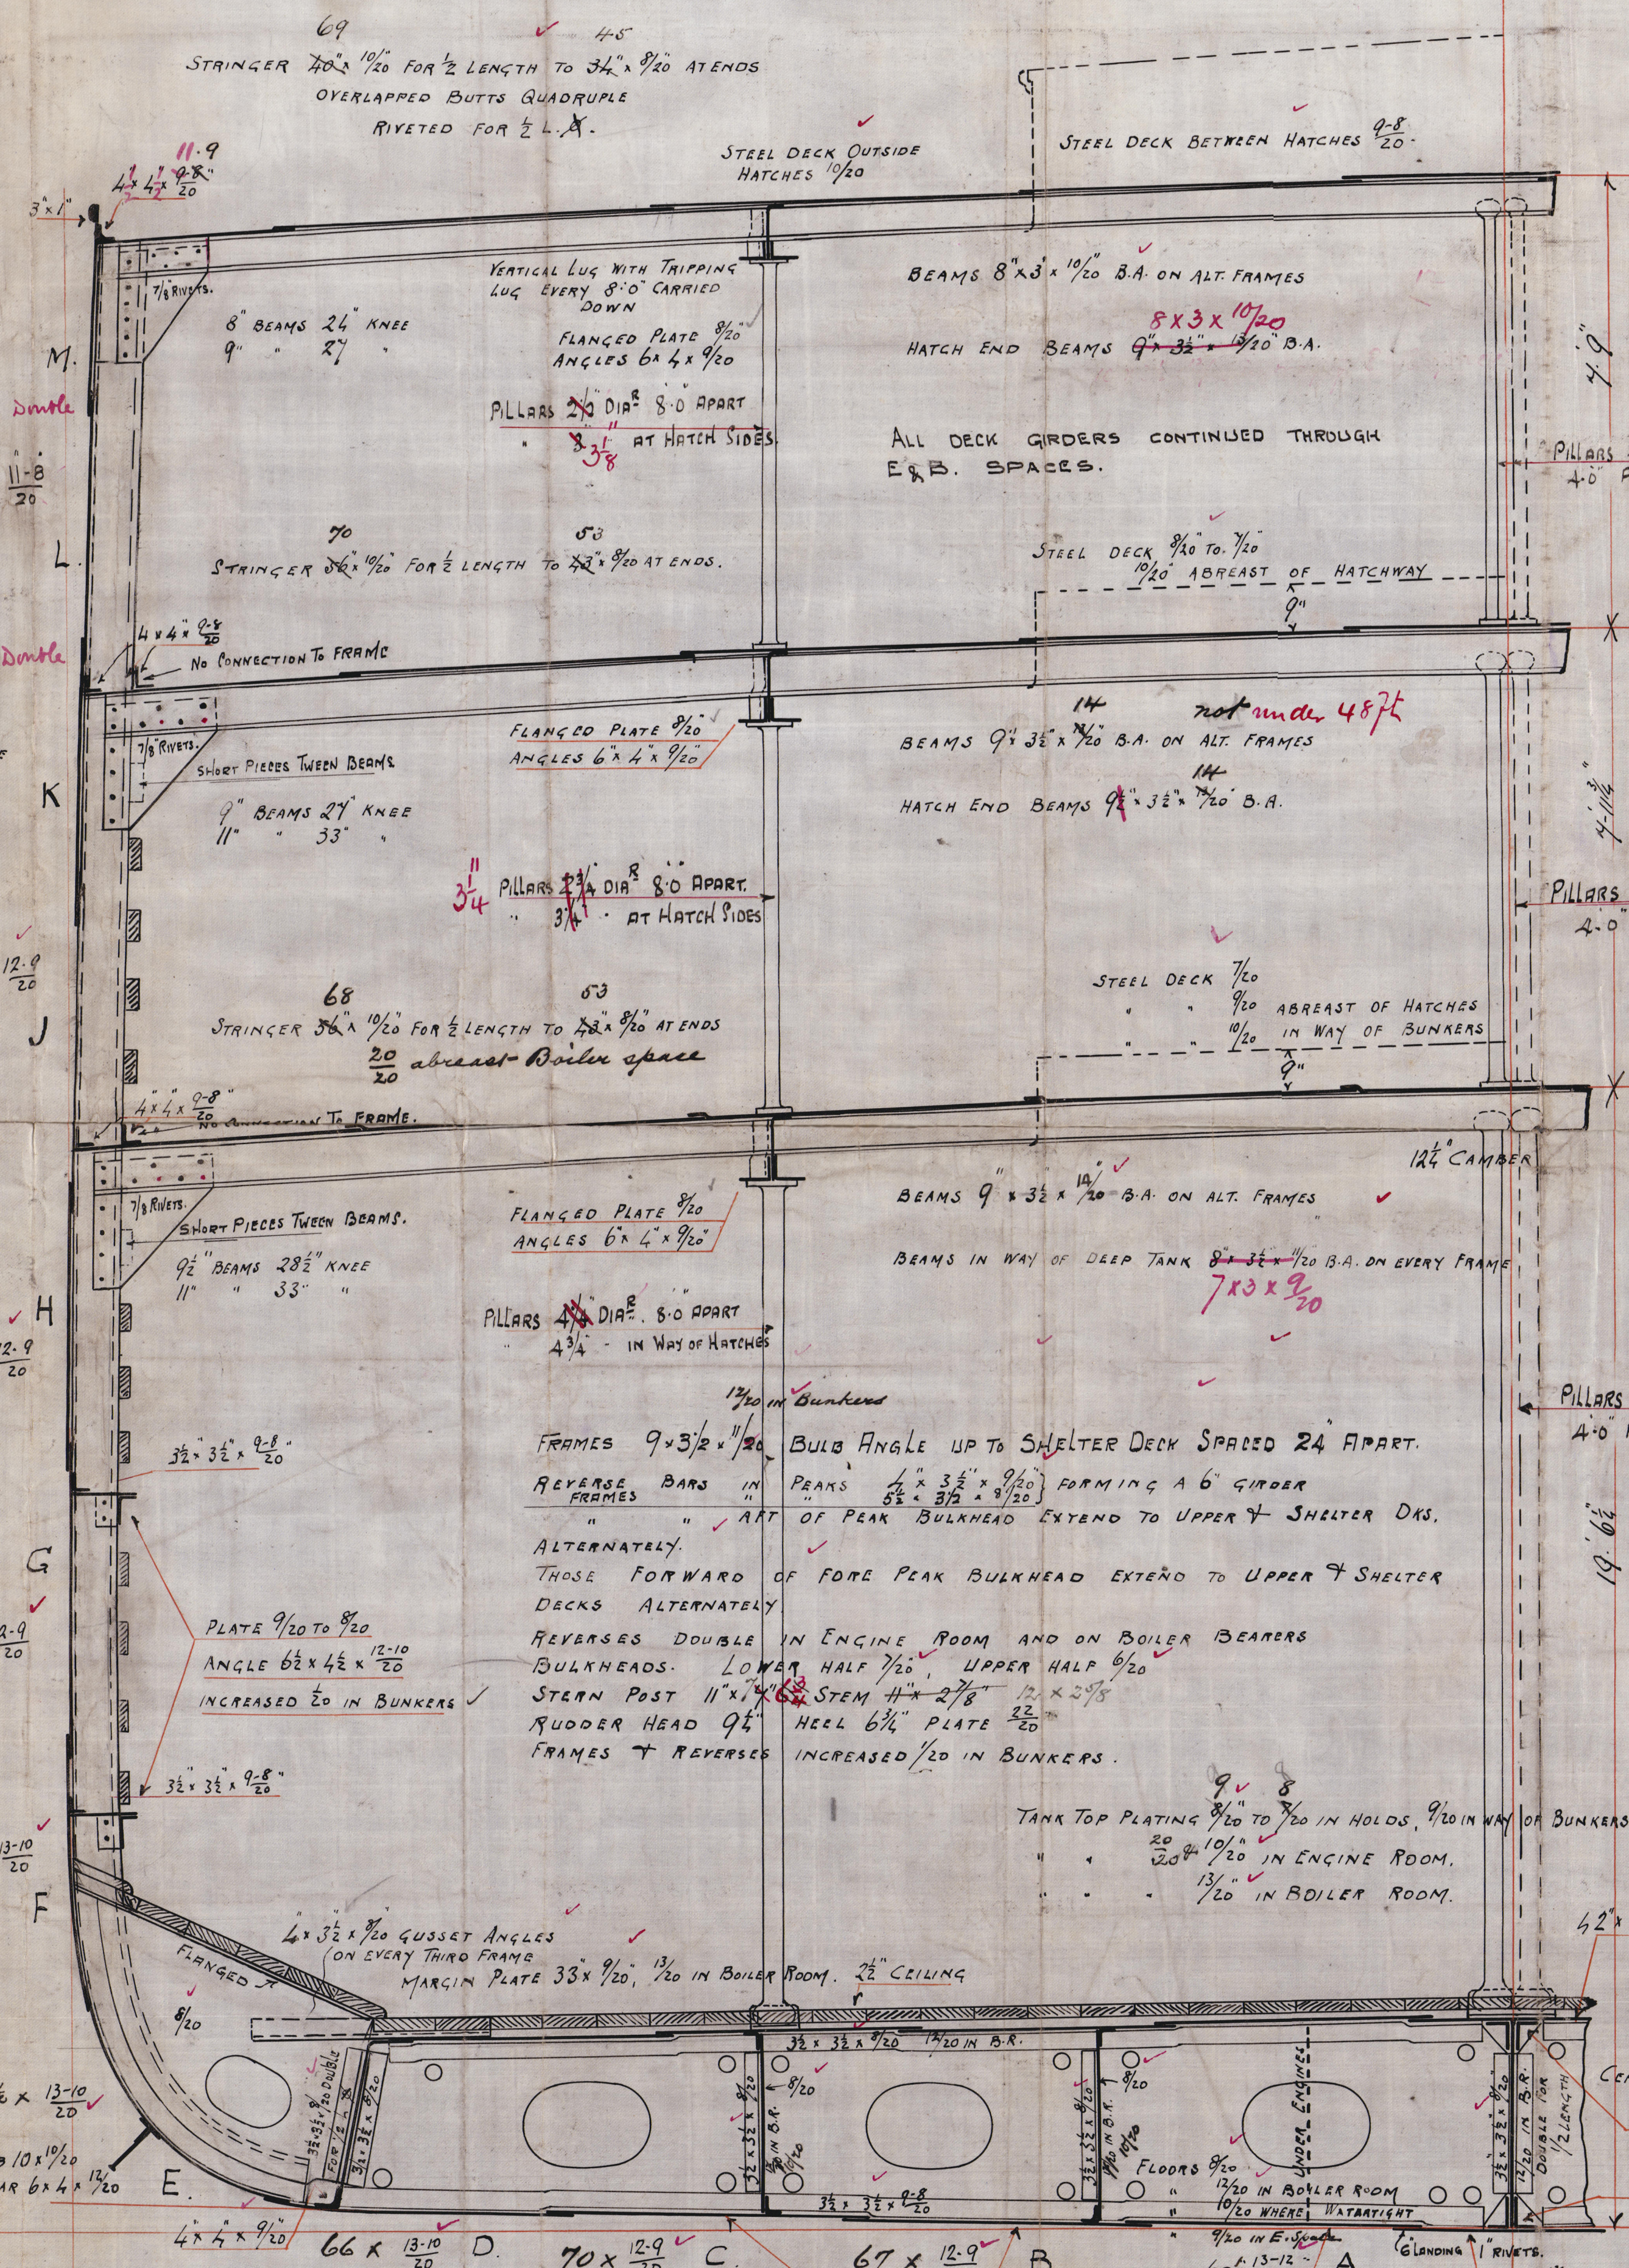

Equipment to be increased two grades  
above Lloyd's requirements

EQUIPMENT		355.51	355.51
100-62 x 353.16		355.51	9592
SHELTER DK 353.16 x 775 x 1.5		4105	4850
DECKHOUSE 66 x 7.5		495	0
		40436	4442 - Equipment No.
		40251	
2 BOWER ANCHORS STOCKLESS	60 CWTs	170 1/2	CWTs.
1 STREAM " EX STOCK	16 1/2		
1 KEDGE	7		
270 FATHOMS 2 1/2" STUD CHAIN CABLE			
90 4 1/2" STEEL WIRE (STREAM)			
120 4 1/2" " (TOWLINE)			
2-90 7 WARP			
2-90 7 HAWSER			
NUMERALS			
1/2 BEAM	24.5	24.50	
1/2 GIRTH	48.62	48.79	
DEPTH	27.5	27.55	
	100-62		
	7.00		
	93.62	1ST NO	93.95
	353.16		
	33062-8892	2ND NO	33179.38
DEPTHS TO LENGTH			12.84
BREADTHS "			7.20

**RIVETING**  
KEEL QUADRUPLE OVERLAPS TO TREBLE AT ENDS.  
BUTTS OF SHELL OVERLAPPED AND TREBLE RIVETED  
A TO K. QUADRUPLE RIVETED WHERE OVER RULE  
WIDTH FOR 1/2 LENGTH  
UPPER & MAIN DECK STRINGER PLATES LAPPED &  
TREBLE RIVETED ALL AROUND 4 FT  
RIVETS THRO PLATING & FRAMES IN DEEP TANK  
ALSO IN PEAK TANKS SPACED 6 DIAM. APART  
BEFORE THE 3/6 L. THE RIVETS IN THE LANDING EDGES  
OF THE STRAKES FORMING THE PLAT OF BOTTOM TO BE  
SPACED NOT MORE THAN 4 DIAM. APART.  
RIVETS IN THE PLATING & FRAMES IN WAY OF SAME  
SPACED NOT MORE THAN 5 1/2 DIAM. APART.

1 RIVETS THROUGH CENTRE LONGITUDINAL BOTTOM BARS & KEEL PLATES  
SPACED 5 DIAM. APART. C. TO C.

NOTE: ALL PARTS OF DOUBLE BOTTOM IN BOILER ROOM  
TO BE INCREASED AS PER SPECIFICATION  
3/20 ABOVE LLOYD'S RULES. & IN ACCORDANCE  
WITH ARRANGEMENTS MADE WITH OWNERS  
REPRESENTATIVE IN LONDON. 12-2-07.




Sir R. Dixon & Co

No 534

Midships Section


Crispin  
Mar 53/8

W942-0145

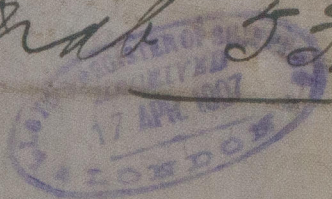

W.B. 11 TOP

Handwritten notes and numbers in red and black ink, including "1705", "1706", "1707", "1799", "1800".

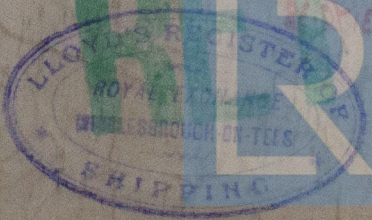

© 2020

Lloyd's Register  
Foundation