
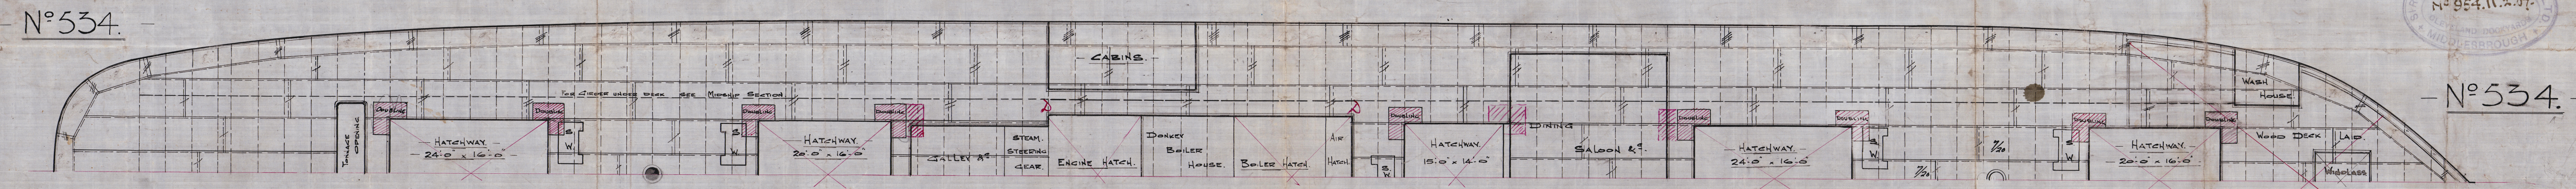


DRAWN BY
11.2.07

18.2.07
22.4.07
1.5.07
15.5.07
31.5.07
11.6.07
20.6.07
15.7.07
9.8.07

PROFILE & DECK PLAN.

DIMENSIONS.
355'-0" x 49'-0" M² x 26'-6" M²
SCALE 8"=1'

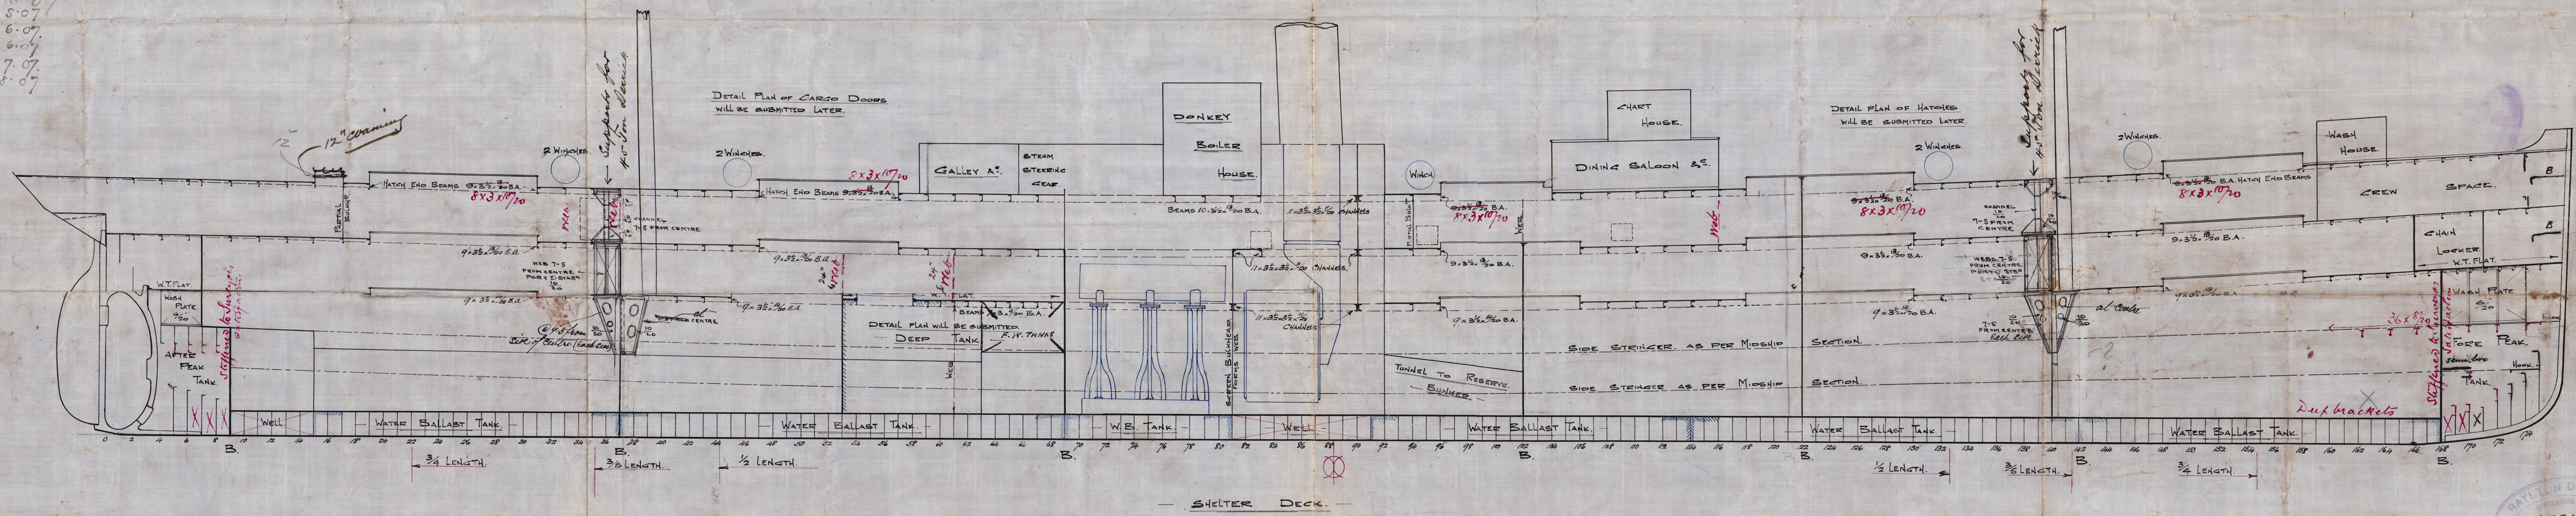

SIR RAYLTON DIXON & CO. LTD.
No 954.11.2.07.
& MIDDLESBROUGH

No 534.

15.2.07

- Sir R Dixon & Co

W942-0150

No 534

Profile & deck plan

1/2 brick

Order report No 5315

W.B. II Top

W942-0150



2020

Lloyd's Register
Foundation