

- N<sup>os</sup> 512, 13, & 14 -

# MIDSHIP SECTION.

DIMS. 130' B.P. x 22'-1" M<sup>LD</sup> x 12'-10" M<sup>LD</sup> - 12'-0" HOLD.

STEEL CLASS 100 A.I. (FOR FISHING PURPOSES.)

SCALE 1/2" = 1 FOOT.

1/2 GIRTH. 20.16 ✓  
1/2 BREADTH. 11.04 ✓  
DEPTH. 13.33 ✓ 1<sup>st</sup> N<sup>o</sup>  
44.53 ✓ 1<sup>st</sup> N<sup>o</sup>

128.792 LENGTH PER RULE.

8906

40077

31171

35624

8906

4453

5735.10776 / 2<sup>nd</sup> N<sup>o</sup>

L/B = 5.83 L/D = 9.64

## EQUIPMENT.

ONE ANCHOR 5 3/8" CENTS EX. STOCK



--- 5 1/4" --- ---

--- 3" --- ---

105 FTHMS 1 1/2" CHAIN.

60 --- 6" HANSE.

60 --- 5" WARP.

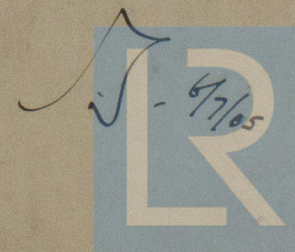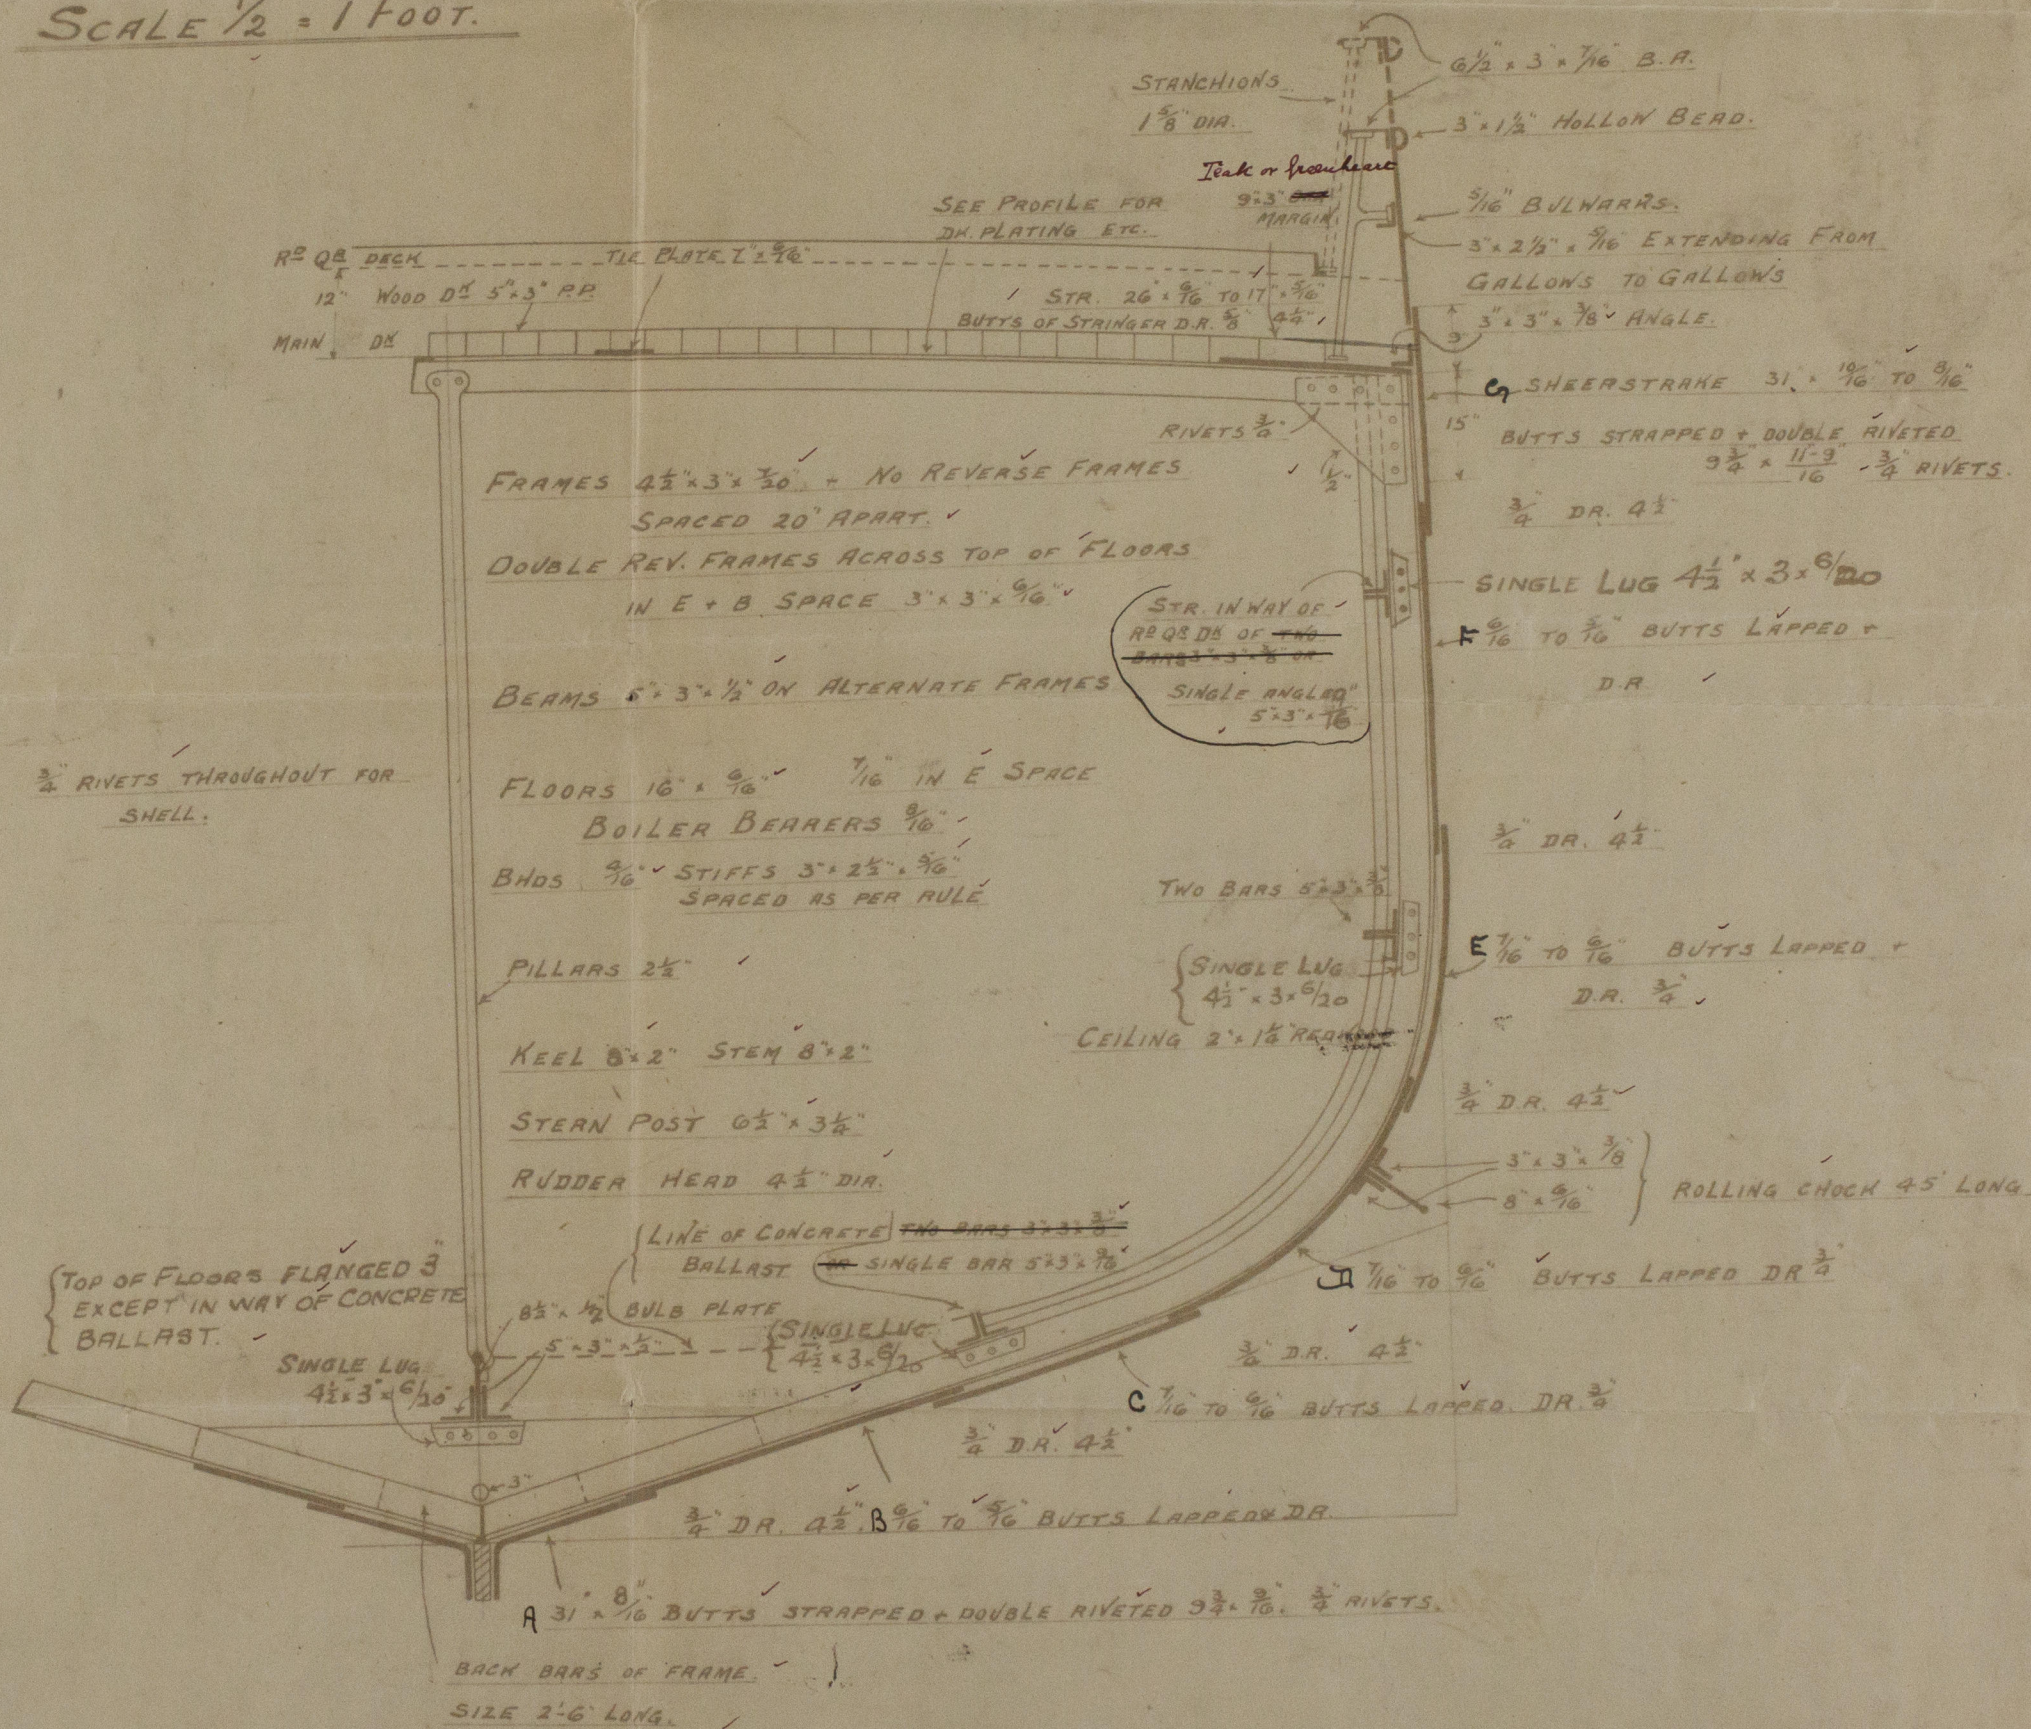


© 2020


Lloyd's Register  
Foundation



Earles S. & E. Co.  
Nos 512. 513. 514  
Midship Section.

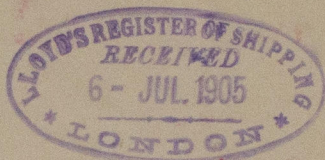

512 s/crown Hull Rph No. 17558.  
513 s/c Thrustle " " " 17571  
514 s/c Gladys " - - 17708

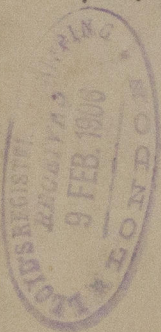

RETAIN  
© 2020  
Lloyd's Register  
Foundation