



6. 7. 05



- N^{OS} 512, 13, & 14 -

- PROFILE & DECK PLAN -

130'-0" BP x 22'-1" MLD x 12'-10" MLD

TO CLASS 100 A1 STEEL
FOR FISHING PURPOSES


SCALE 1/4" = ONE FOOT

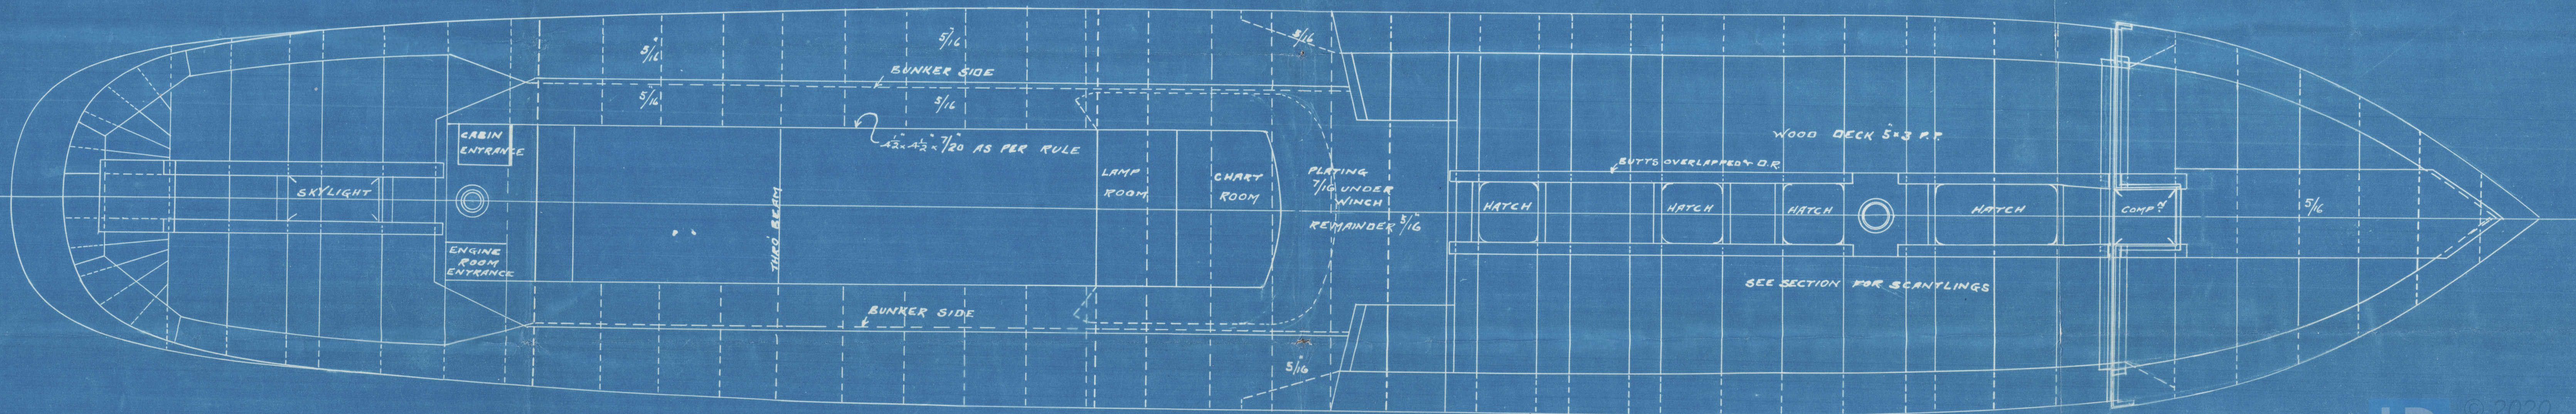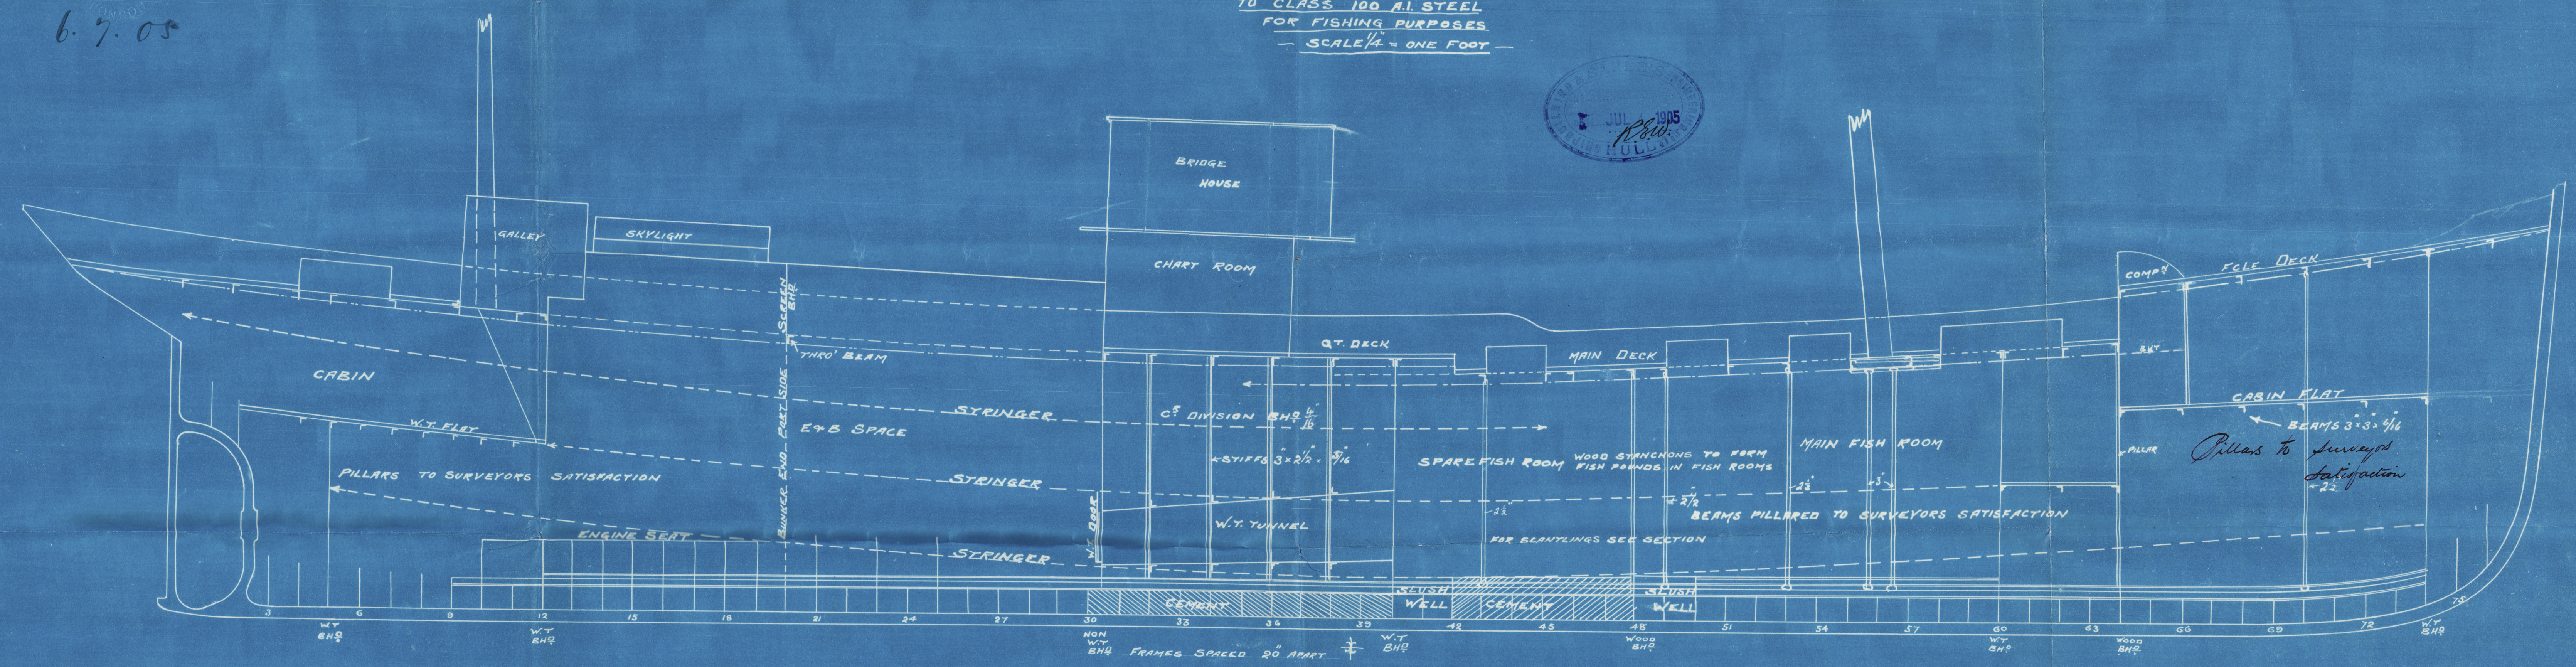

Carlin's S. & E. Co.

No 512, 513, 514.

Profiles & Decks

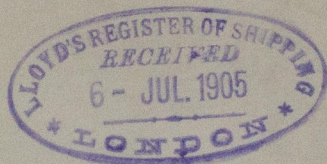

s/s Crown

Hull Report No. 17558.

s/s Thrush. Hull No. 17571

s/s Glarry - 12-17708



Carlin's

RETAIN



© 2020

Lloyd's Register
Foundation