


Class 100 AI Lloyds

23. 1. 06

Profile.

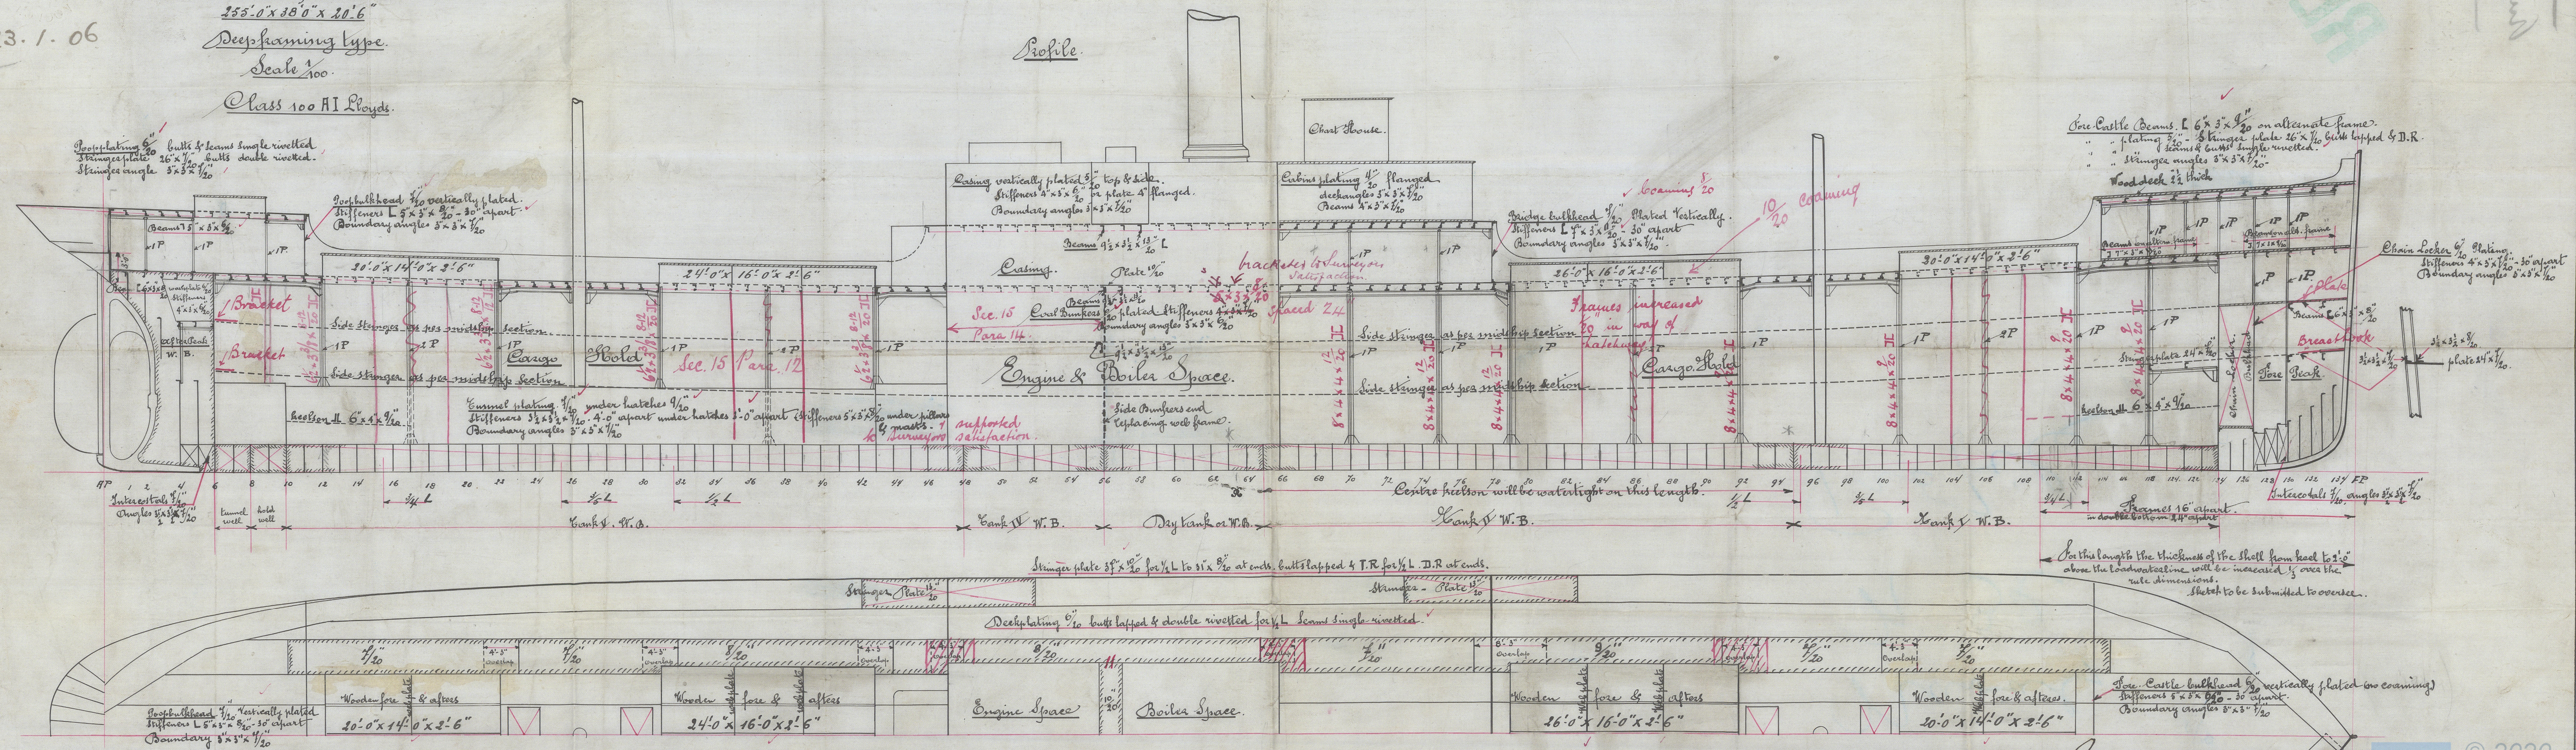

C.B.
23.1.86

Is Djerv

Ant. 7249

REMAINDER



© 2020

Lloyd's Register
Foundation

W943-0129