
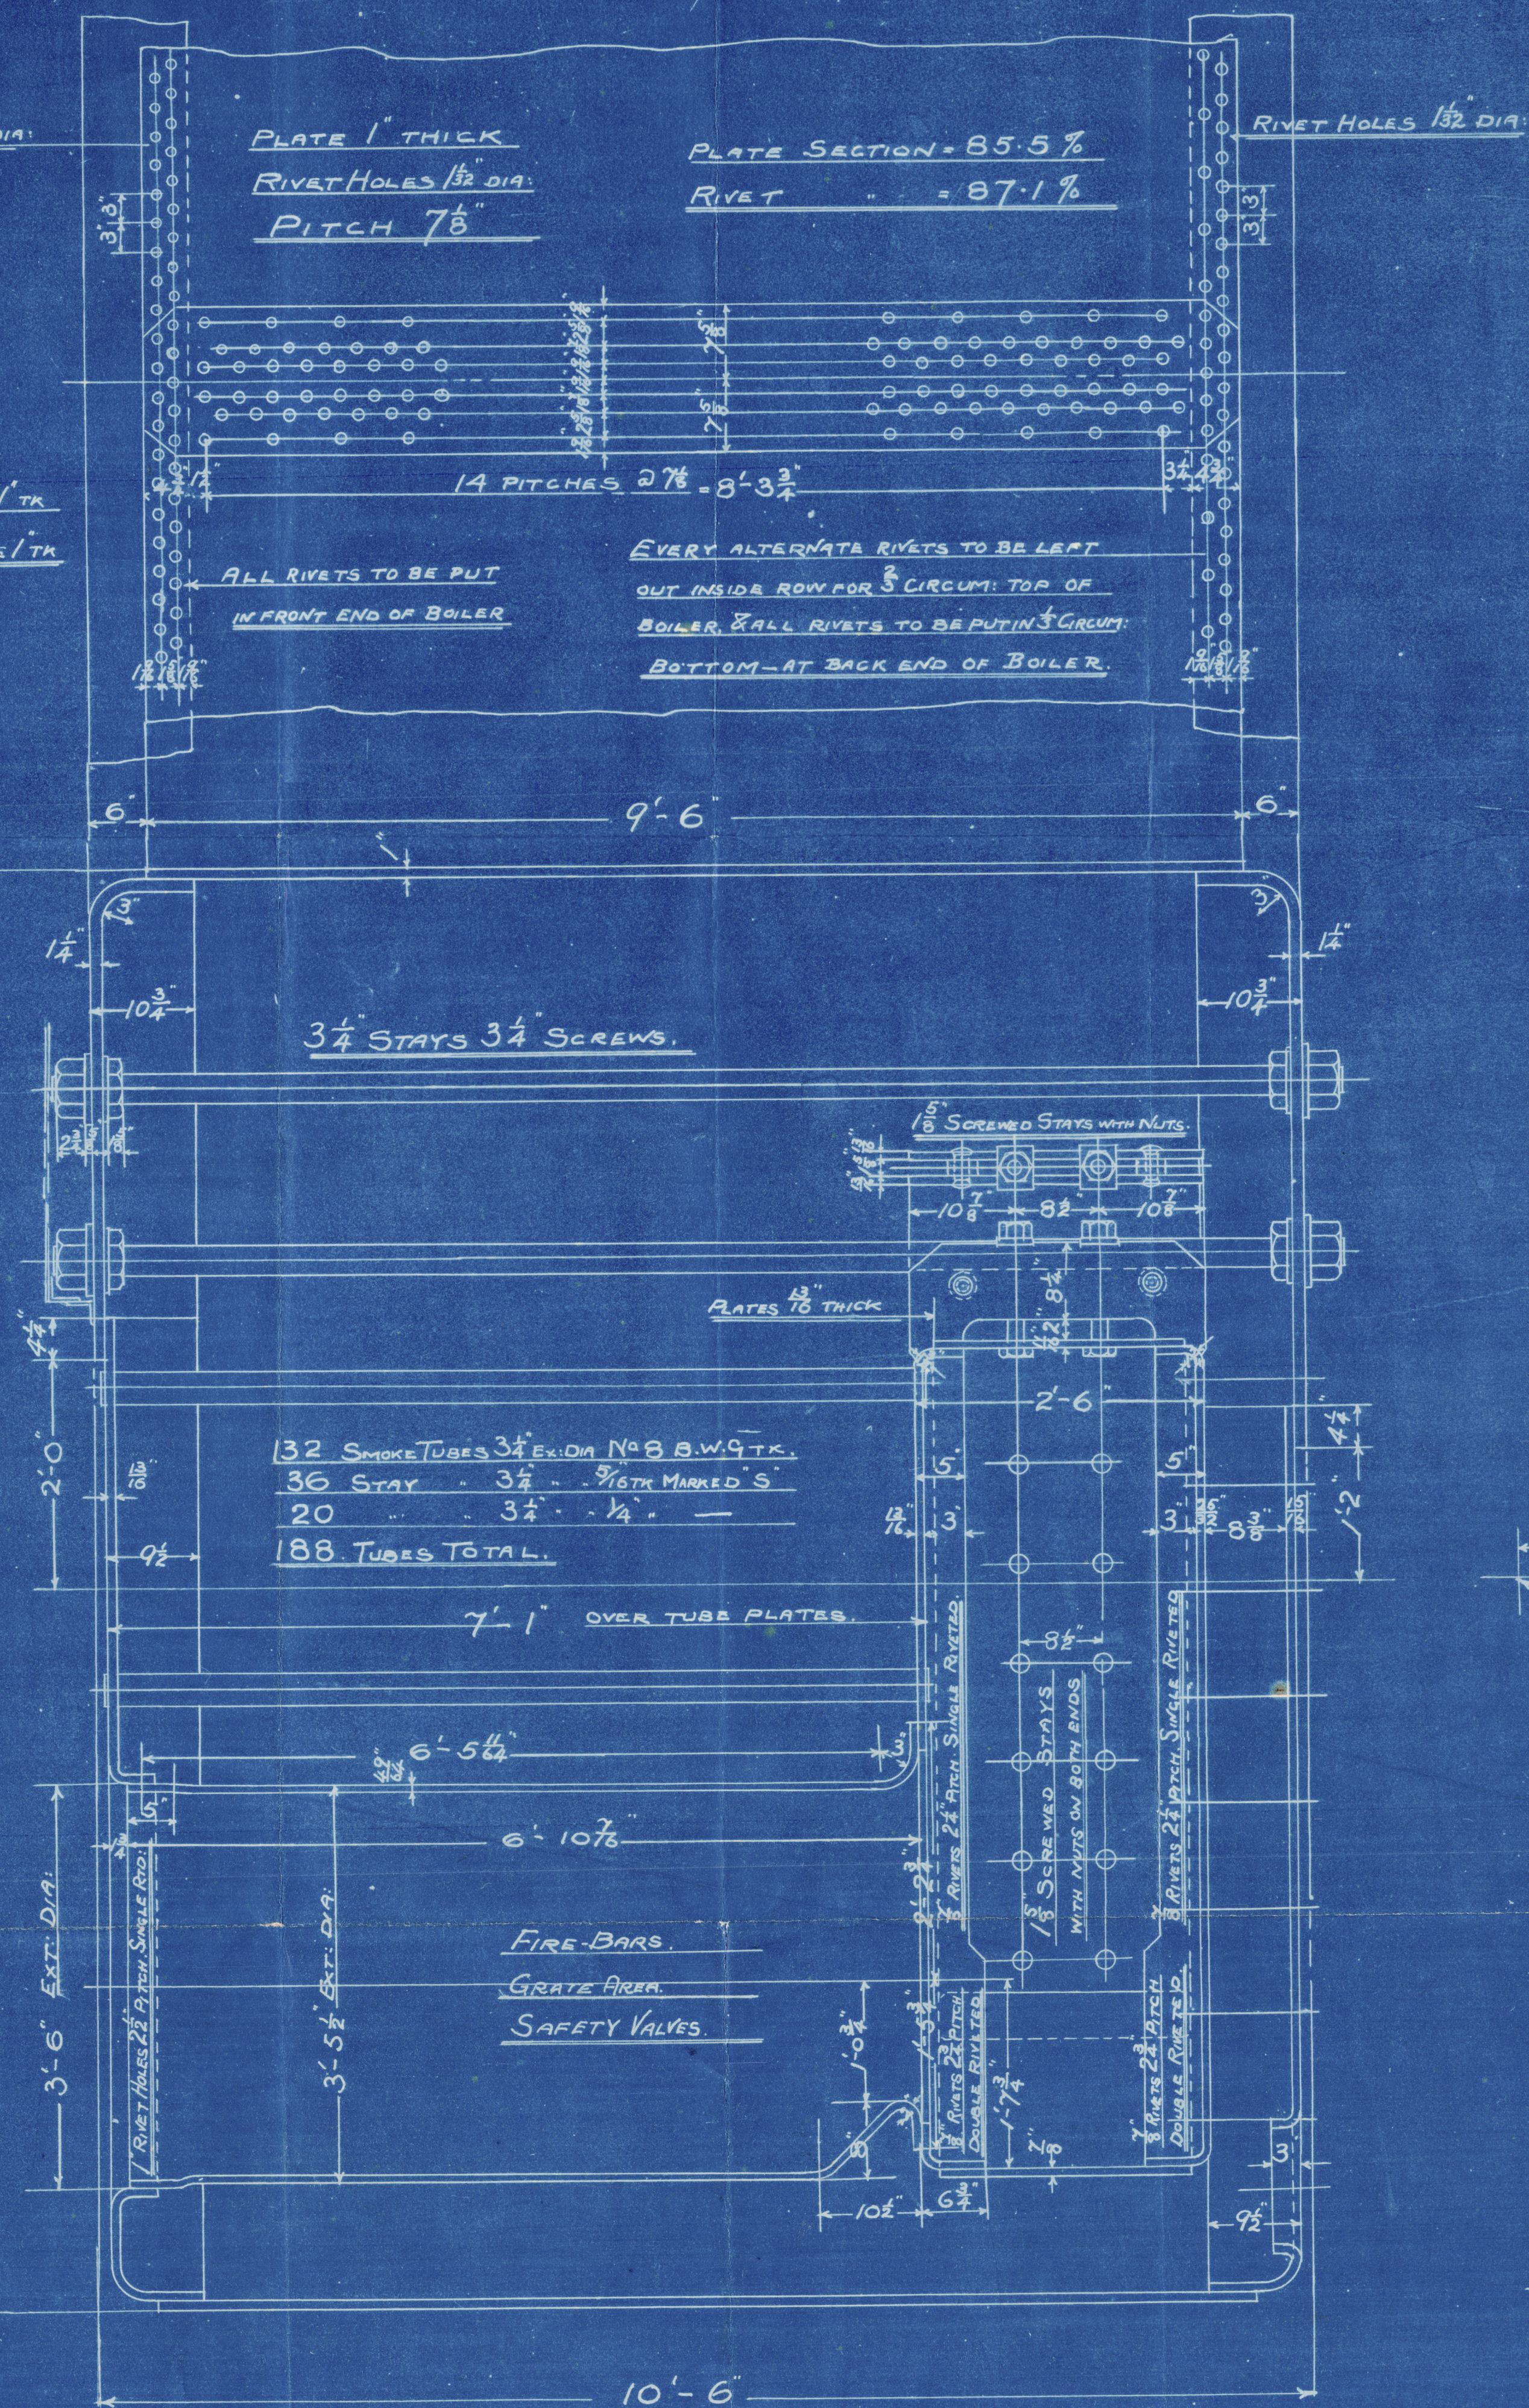



## BOILER

**TRACING 1619** SCALE—1 INCH TO A FOOT **SCHEDULE L**

**WRITTEN DIMENSIONS ONLY TO BE TAKEN**

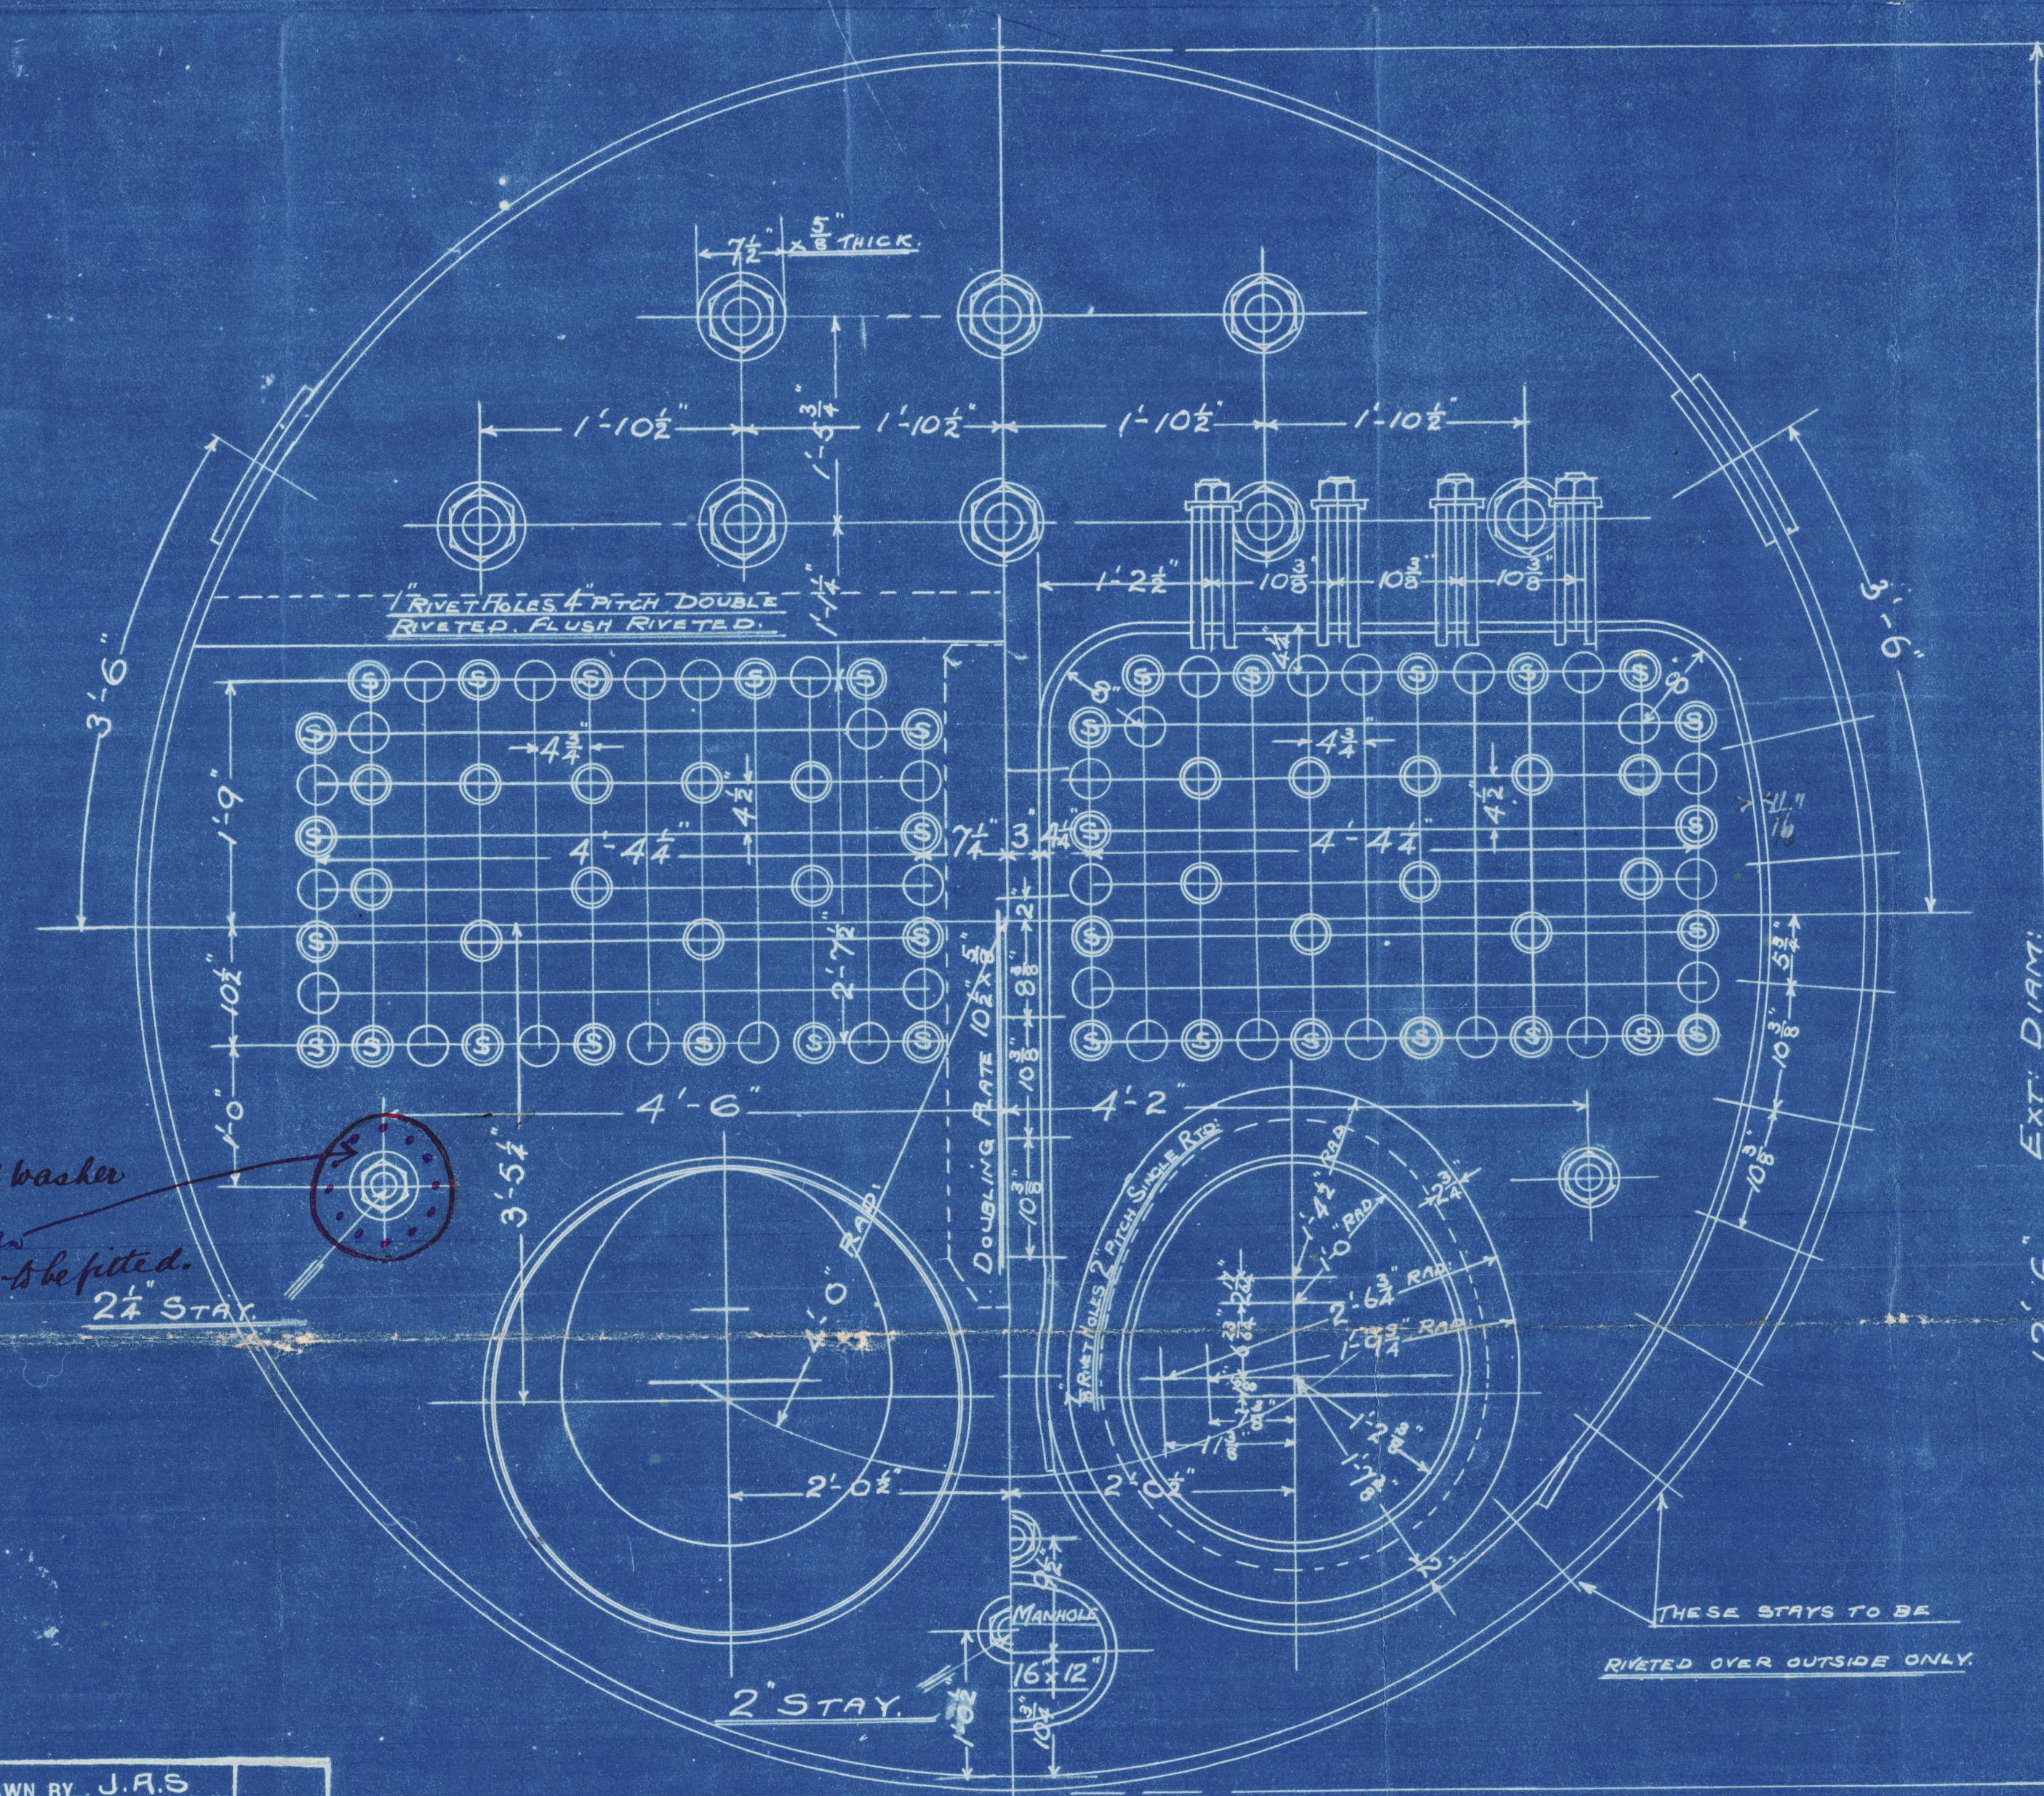

" LLOYD'S & NORSKE VERITAS " SURVEY.	
= 22.36 <sup>(16-2) BS. 5</sup> 148	180-8 LBS PER. <sup>2</sup>
WORKING PRESSURE =	180 LBS " "
TEST " =	360 " "
HEATING SURFACE ON TUBES.	1133 SQ. FEET.
" " OTHER PARTS	292 " "
" " TOTAL.	1425 " "
EX. FRONT TUBE PLATE =	1396 " "
EFFECTIVE AREA OF STAYS	
3 1/4" STAY TUBES 5/16" T. 9 THREADS PER IN.	2.17 SQ. IN.
3 1/4" " " 4" 9 " " "	1.64 " "
3 1/4" MAIN STAYS 6 " " "	7.24 " "
2 1/2" " " 6 " " "	3.26 " "
2" " " 6 " " "	2.51 " "
2" SCREWED " " "	2.79 " "
1 1/2" " " 11 " " "	2.43 " "
1 1/2" " " 11 " " "	1.79 " "
ALL PLATES, RIVETS & STAYS - STEEL	
TUBES - WROUGHT IRON -	
HOLES TO BE DRILLED IN PLATE AFTER BENDING.	
TENSILE STRENGTH OF SHELL PLATES NOT LESS THAN 20,000 LBS. <sup>20,000</sup> <sup>20</sup> TONS	
" " MAIN STAYS	27 " "

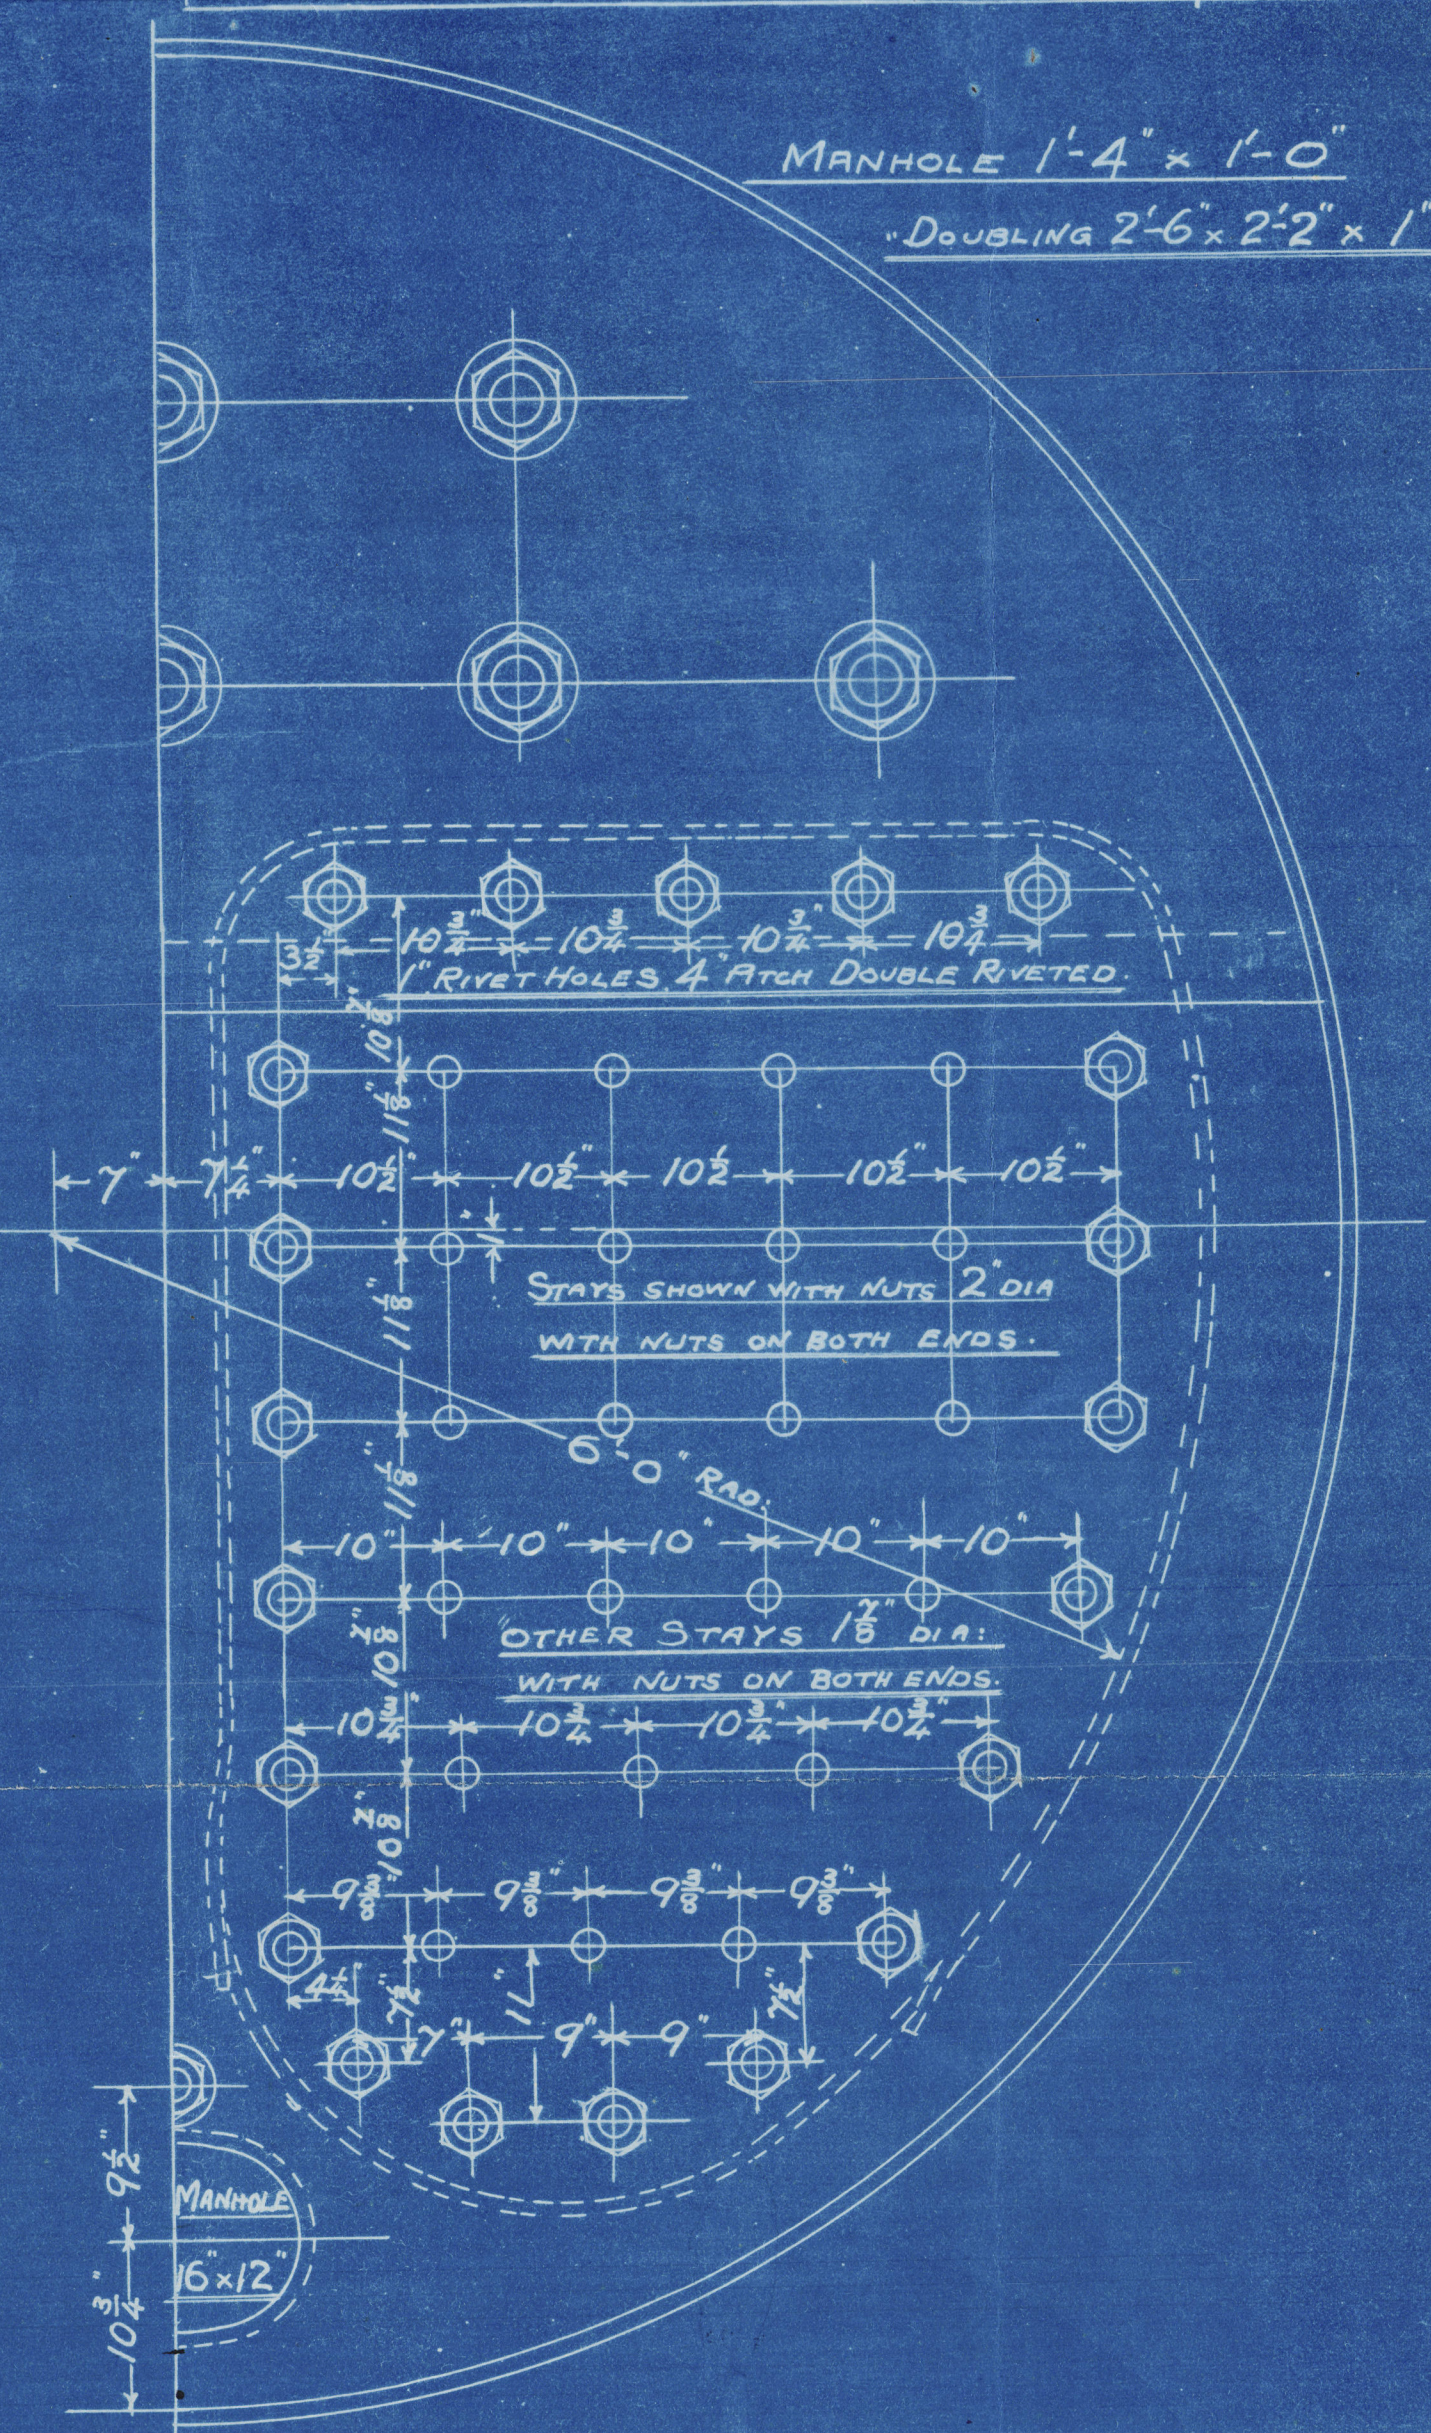

DRAWN BY J.A.S.  
CHECKED BY  
TRACED BY R.N.M.  
CHECKED BY J.A.S.  
TRACING No 1619.

CONTRACT 1705 2 OFF.



Antwerp S.B.C. No 32

Nrme. C1405

2 Bm

No 2532  
Lloyd's Test  
360. lbs.  
10/10/06 A.B.



Sta Rpt No 23023.

RETAIN

RETAIN



© 2020

Lloyd's Register  
Foundation

W943-0131