

all. made & unaltered  
 1152-91  
 watered & galvanized  
 0.21  
 82-5510-081


PLAN No. 2761  
 FOR ENCLOSURE TO  
 Messrs Lloyd's Surveyors  
 Hull FROM  
 COCHRANE & SONS, LTD.  
 SHIPBUILDERS, GLEBE  
 DATE 18/4/13. RR

# MIDSHIP SECTION N° 574

STEEL SCREW TRAWLER  
 DIMS 130'-0" B.P. x 23'-0" E.T. x 12'-9" M.L.D.  
 SCALE 1/2 INCH 13'-0" M.L.D.

TO CLASS 100A1 STEAM TRAWLER  
 DECK PLATED OVER IN WAY OF ENGINE & BOILER SPACE  
 E. & B. CASING AS PREVIOUSLY APPROVED

23.4.13.

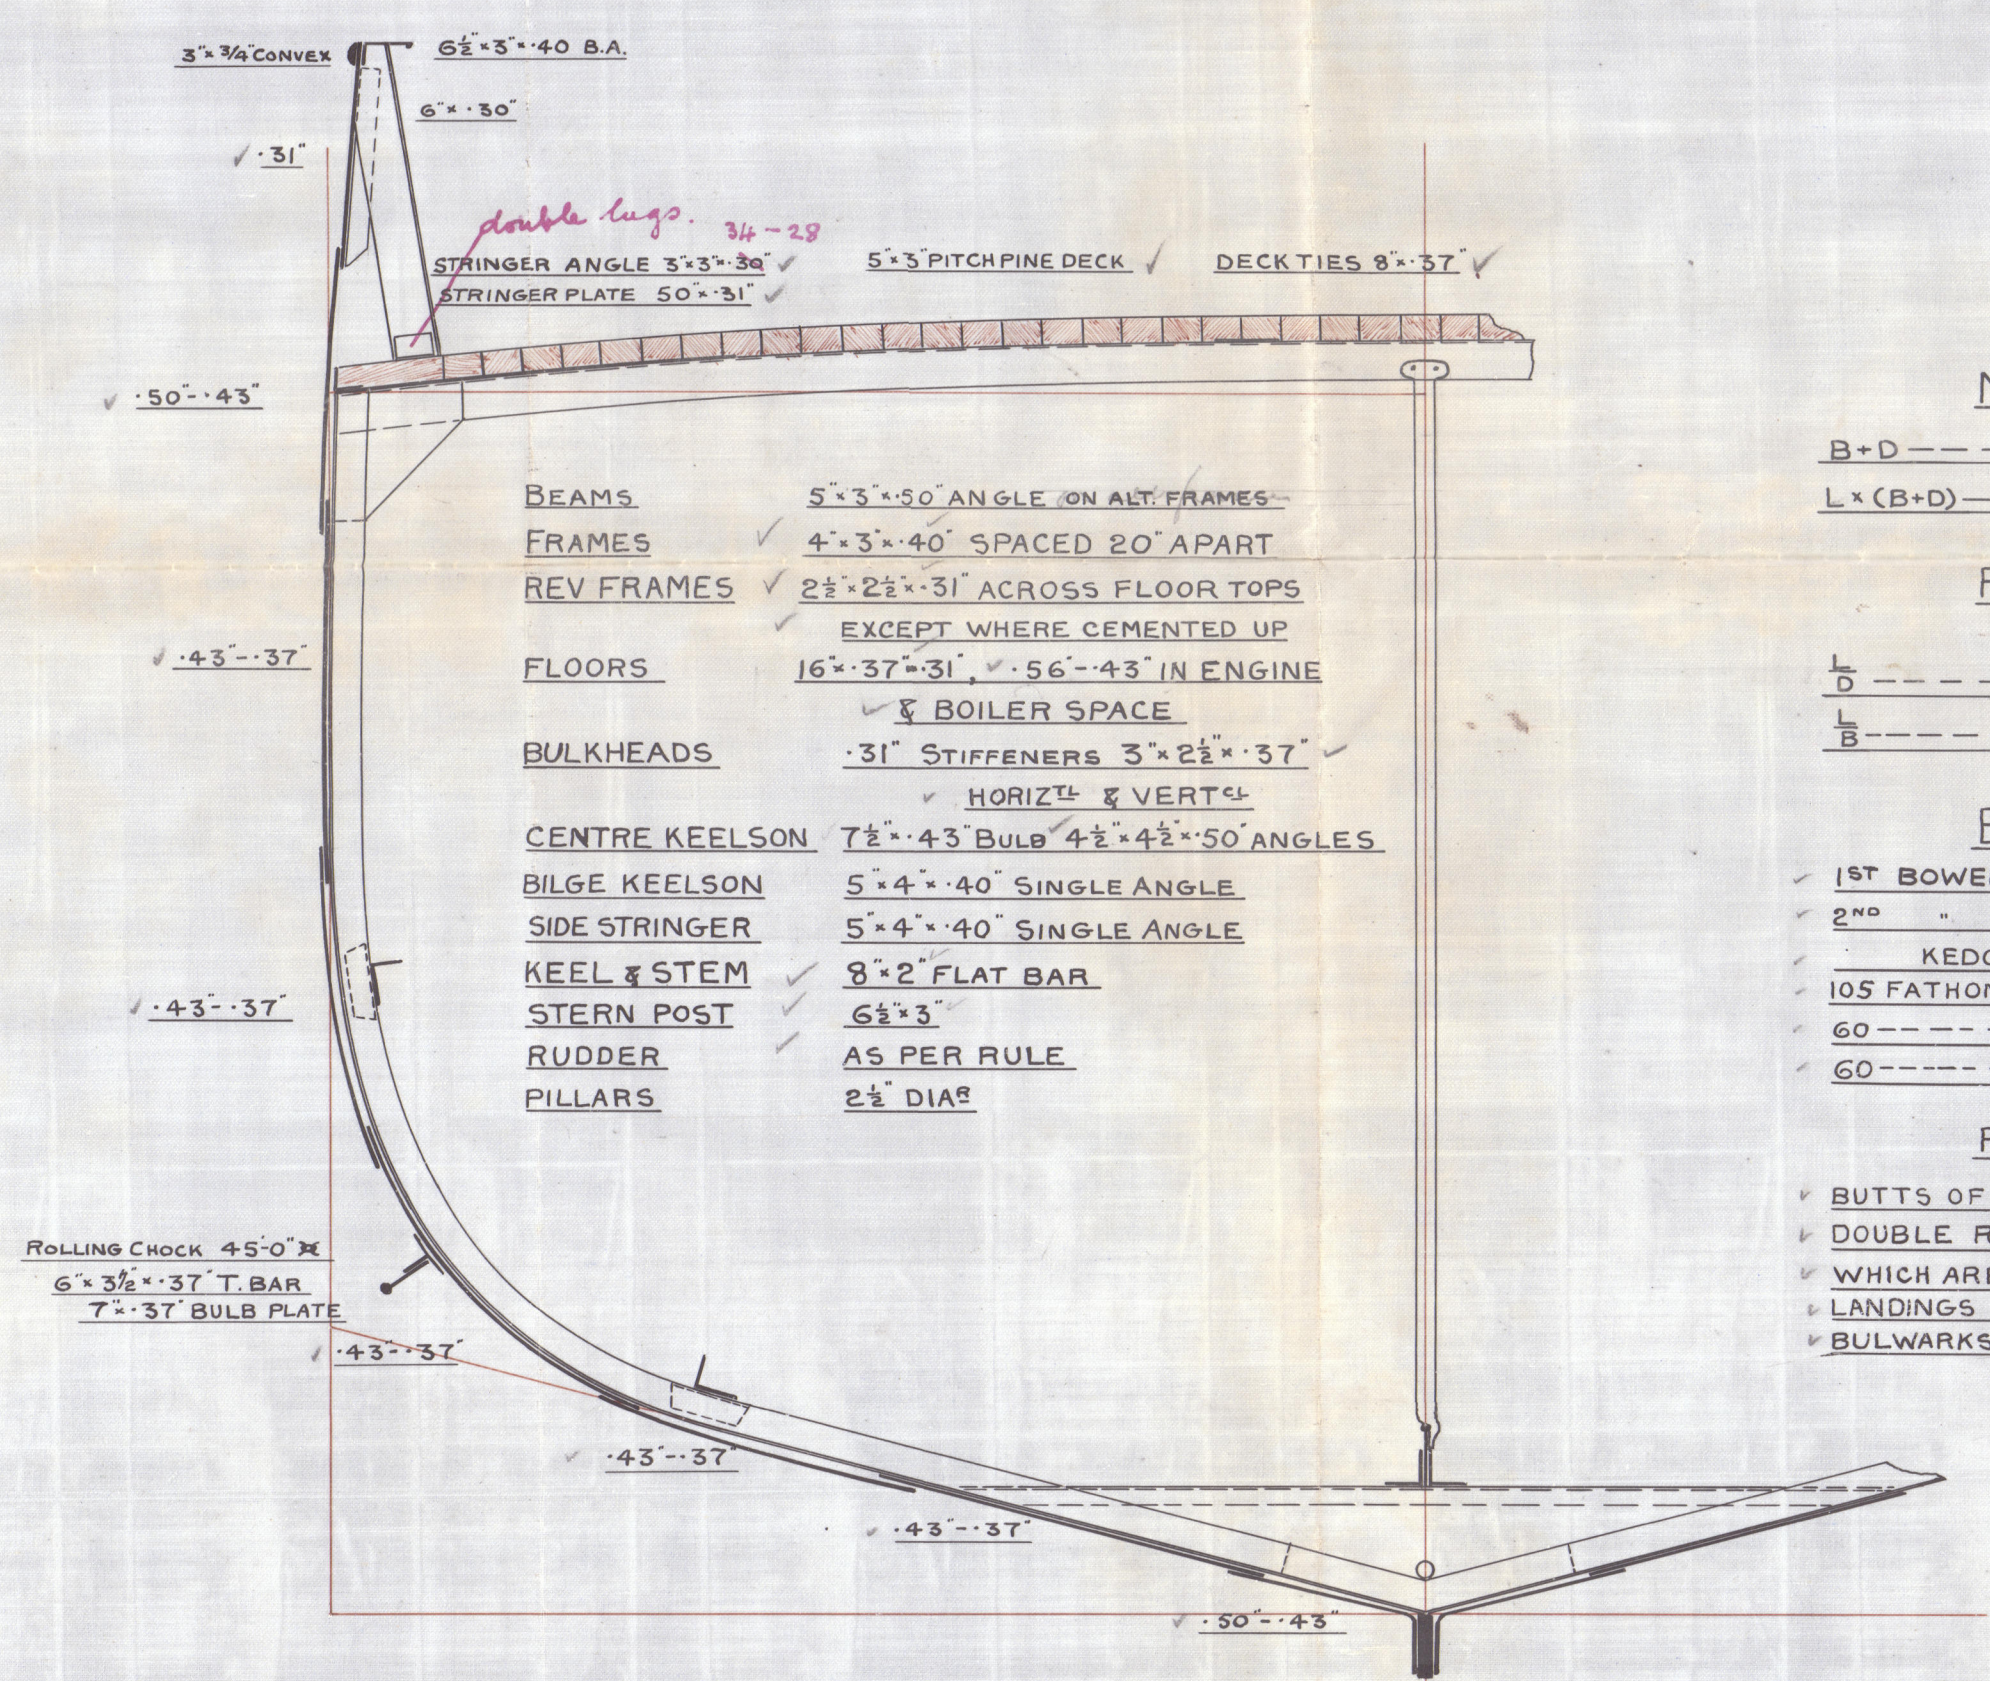

## NUMERALS

B+D ----- 35.63 35.88  
 L x (B+D) ----- 4631.90 4664.4

## PROPORTIONS

L/D ----- 10.19 10  
 L/B ----- 5.68

## EQUIPMENT

1ST BOWER ANCHOR 7 1/2 CWTs STOCKLESS  
 2ND " " 6 1/2 " "  
 KEDGE 3" x 3" x 14" STOCKLESS. Supplied  
 105 FATHOMS 1 1/2" CABLE  
 60 " 6" HAWSER  
 60 " 5" WARP

## RIVETING

BUTTS OF SHELL PLATING TO BE LAPPED &  
 DOUBLE RIVETED EXCEPT GARBOARD & SHEERSTRAKE  
 WHICH ARE TO BE STRAPPED & DOUBLE RIVETED  
 LANDINGS DOUBLE RIVETED  
 BULWARKS SINGLE RIVETED

JW  
 13.4.13  
 19.5.13

w945-0086




Cochrane & Sons. Ltd.

No. 574:

Midship Section

Dimensions 130.0 x 22.88 x ~~12.75~~ 13.0.

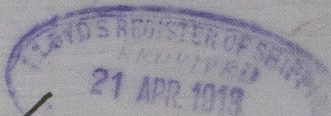

/s/ Dane Hull No. 2688

W945-0086

PLAN No. 2561  
FOR ENCLOSURE TO  
COCHRANE & SONS, LTD.  
SHIREBUILDERS, CELBY  
DATE 18/4/13

SECTION

574

CREW TRAWLER

53-0 ft x 12-0 ft

13-0 m.p.

inch

STEAM TRAWLER

WAY OF ENGINE & BOILER SPACE

PREVIOUSLY APPROVED

RIVETING

60--- 5. WARP

60--- 6. HAMMER

105 FATHOMS 1/2 CABLE

KEDGE

600

1st BOWEN ANCHOR

EQUIPMENT

NUMERALS

60--- 1/2 (B-D)






RETAIN

R

© 2021

Lloyd's Register  
Foundation