



DIMS 130'-0" B.P. x 23'-0" EXT. x 18'-9" M.L.D. 13-0  
SCALE 1/4" INCH

PLAN No. 2763  
FOR ENCLOSURE TO  
Messrs Lloyd's Surveyors.  
Hull FROM  
COCHRANE & SONS, LTD.  
SHIPBUILDERS, SELBY.  
DATE 18/4/13. RR

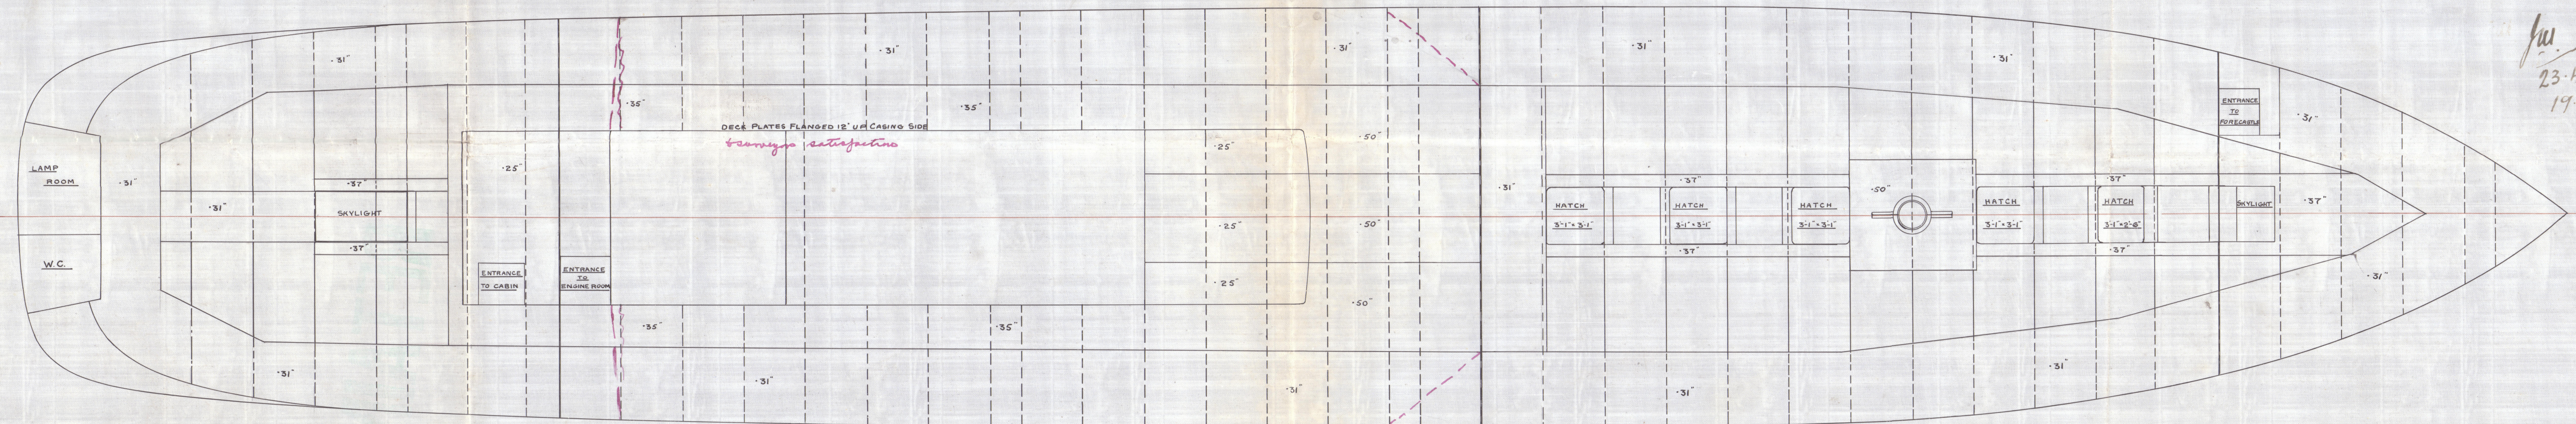

Jan.  
 23.4.13  
 19.5.13

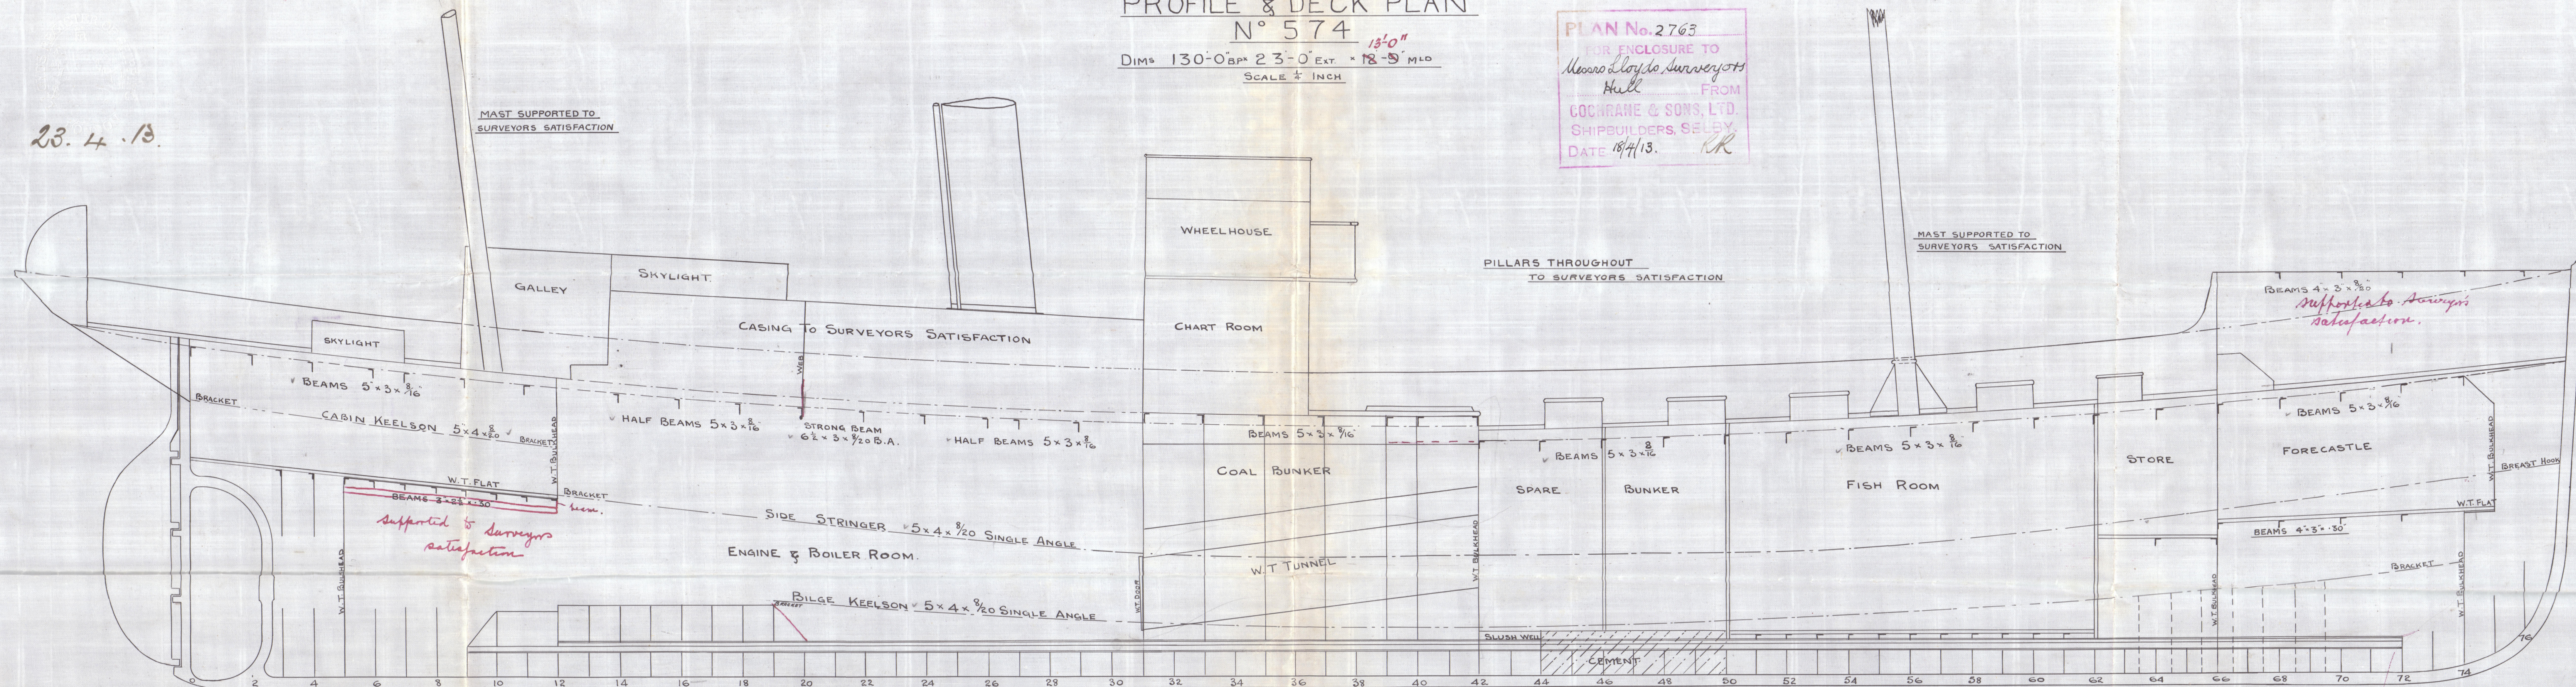

