


Care to be taken that
C.C. stays at the back
are kept sufficiently
clear of the round that
full nuts can be got
upon the flat plate

10413

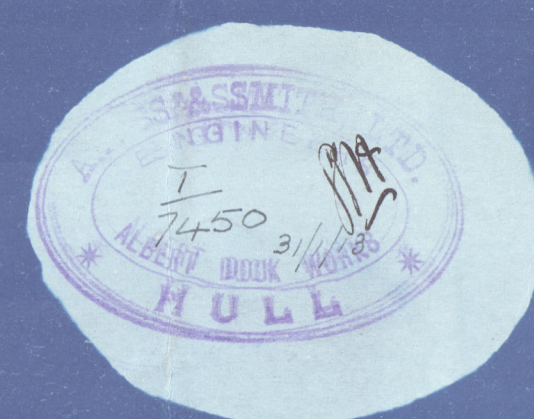

STEEL BOILER N^o 2324

FOR WHOM *D SFC & LTP*
DATE *28/1/13*
ORDER NO *2324*
IF MADE *2*
SCALE *16 1/4* Registered
Foundation

T
7450

W945-0088 1/2

From AMOS & SMITH, Ltd., HULL.

Enclosure for

Messrs Lloyds Surveyors

Lloyd's Register

Hull
Foundation


Amos Smith Boiler

Nº 2324

W945-0088

W P = 200 LBS


Amended plan.

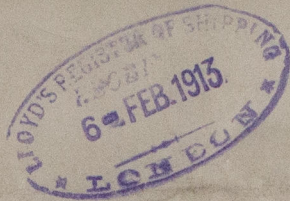

J. Dane

Hull Rpt No. 26884

W945-0088

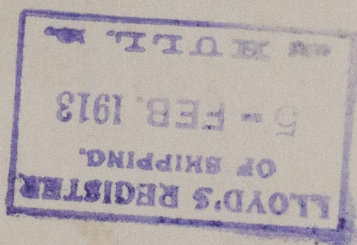

RETAIN



© 2021

Lloyd's Register
Foundation