


# Single decked steel crew steamer N° 417.

Midship section.









Scale  $1/2" = 1'$ .

Class 100 Hs at Ployds.

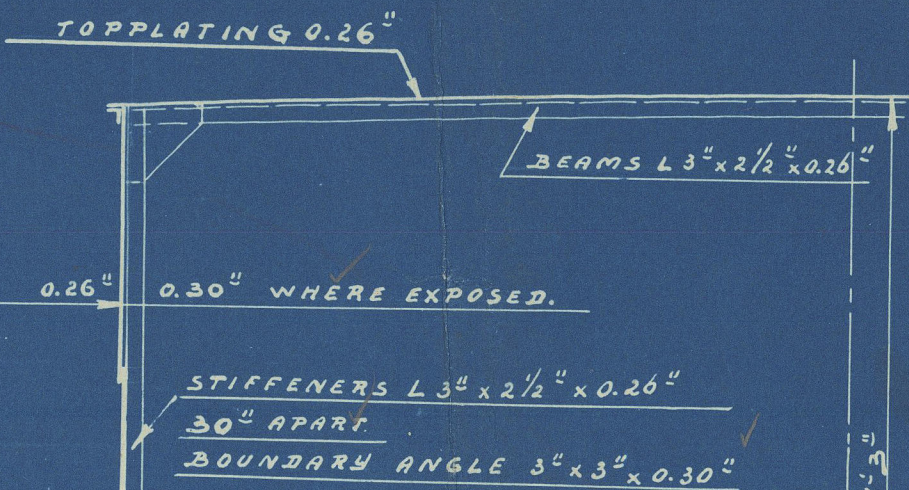

EQUIPMENT N° 9850.	
1 BOWER ANCHOR	2 1/4 C.W.T. STOCKLESS.
1 " "	2 1/4 C.W.T. " "
1 " "	18 C.W.T. " "
1 STREAM	5 3/4 C.W.T. EXCL. STOCK.
1 KEDGE	2 1/4 C.W.T. " "
10 FATHOMS	1 1/8" STUD CHAIN CABLE.
60 " "	3 1/4" STREAM STEEL WIRE
90 " "	3" TOWLINE " "
90 " "	2 1/4" HAWSER " "
90 " "	1 1/4" " " " "

*Owner's consent to be obtained to steel wire*

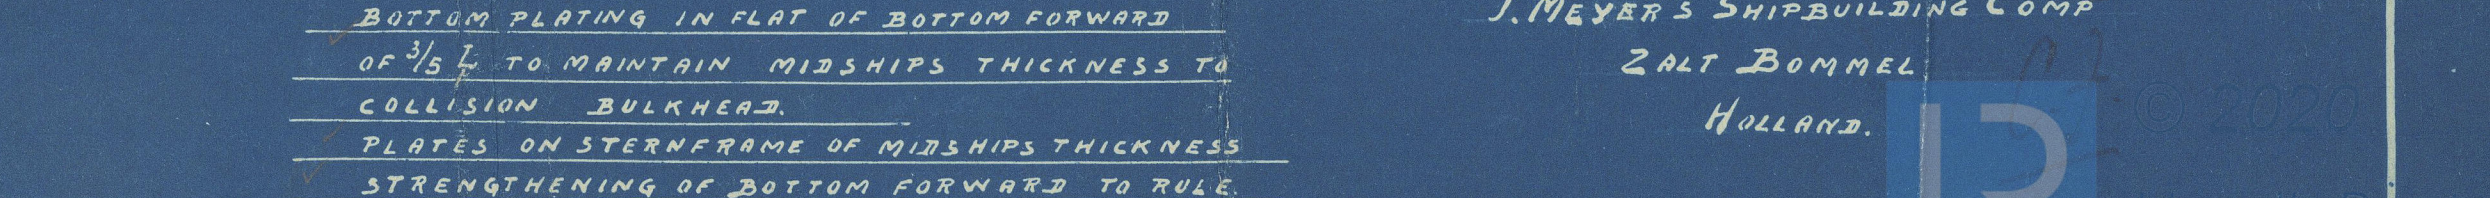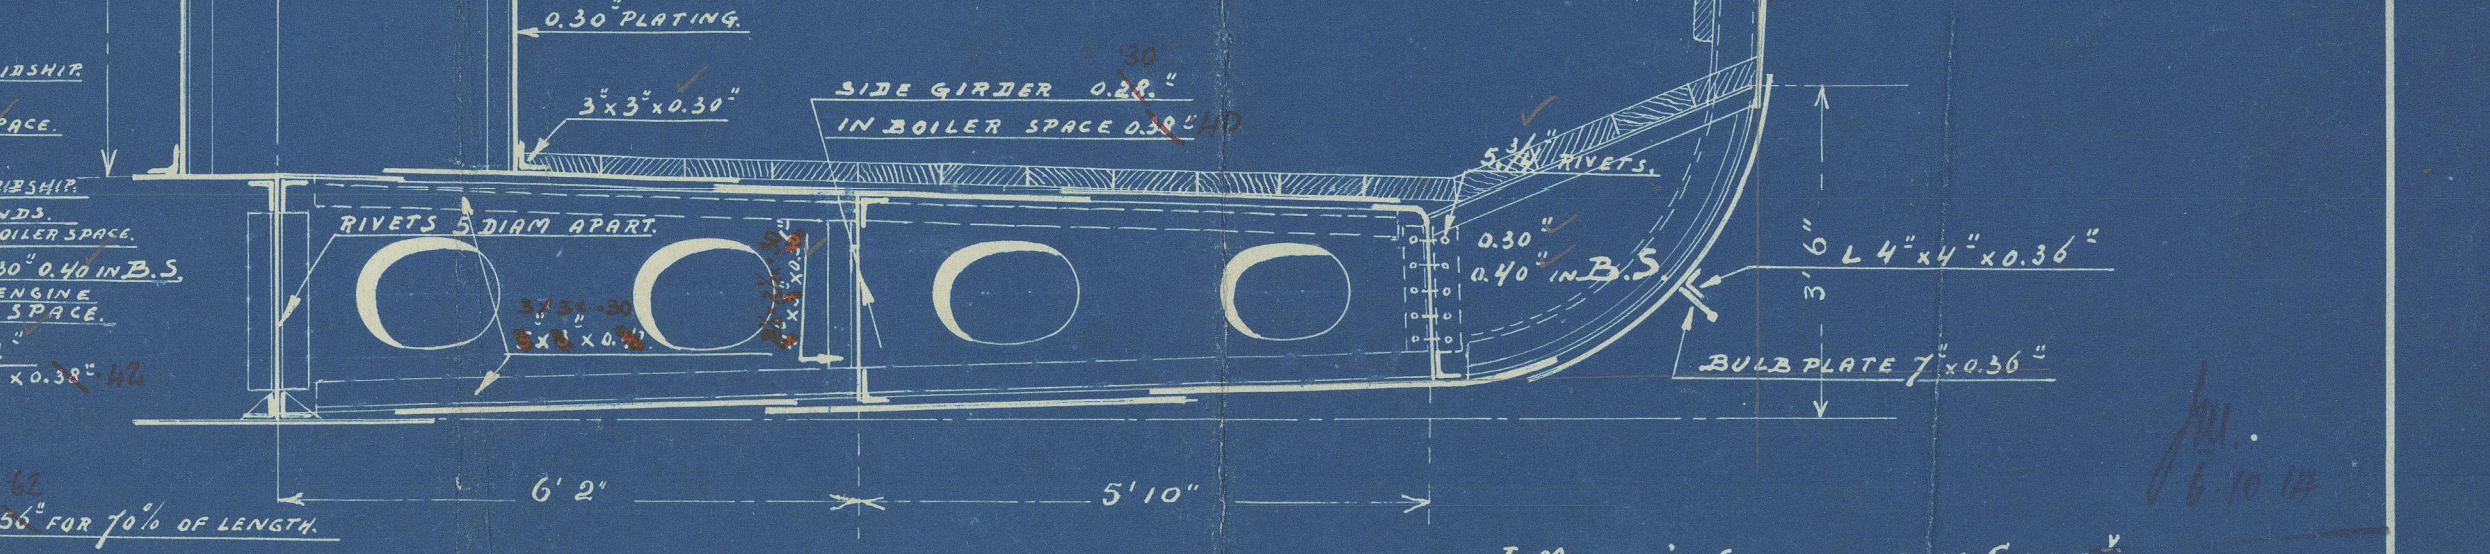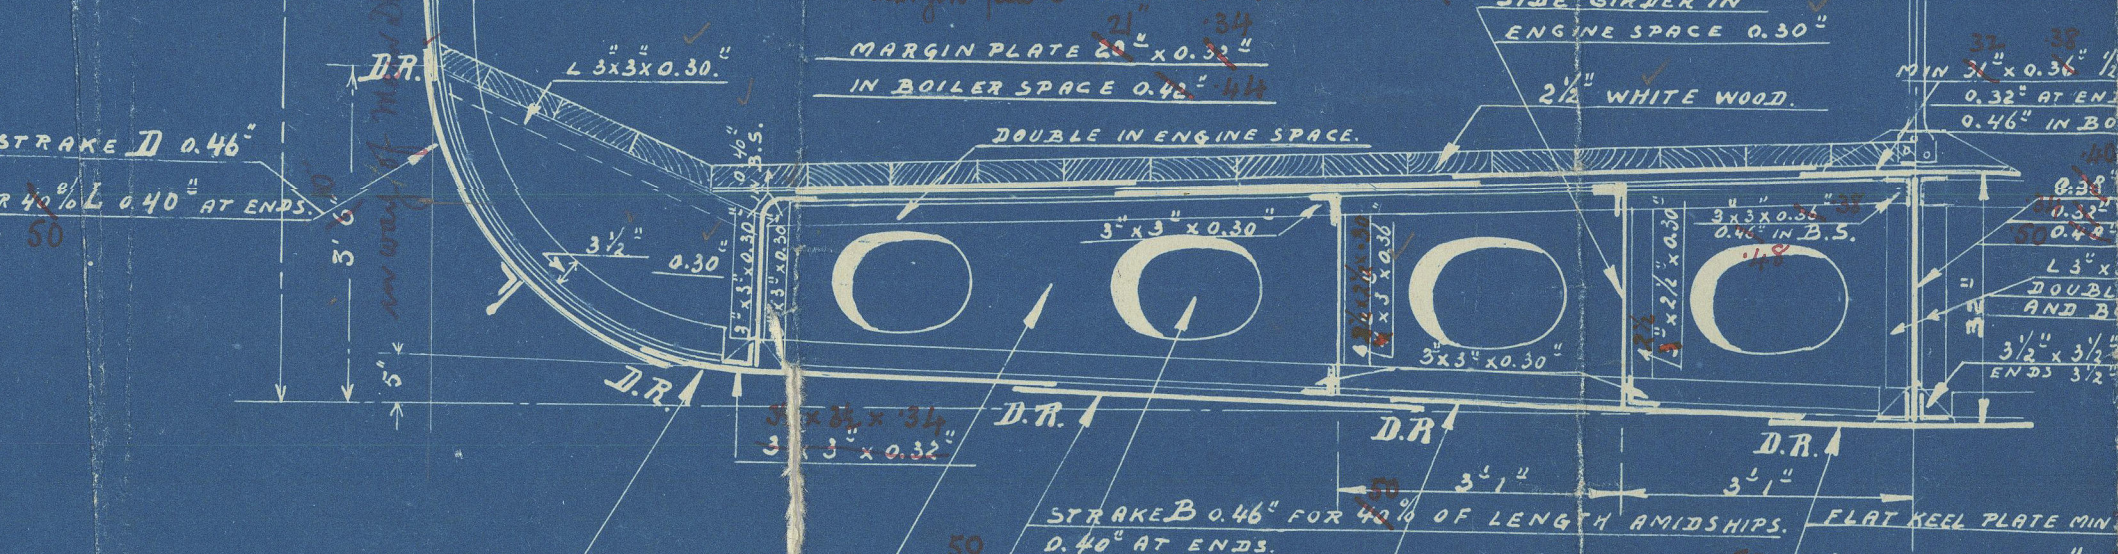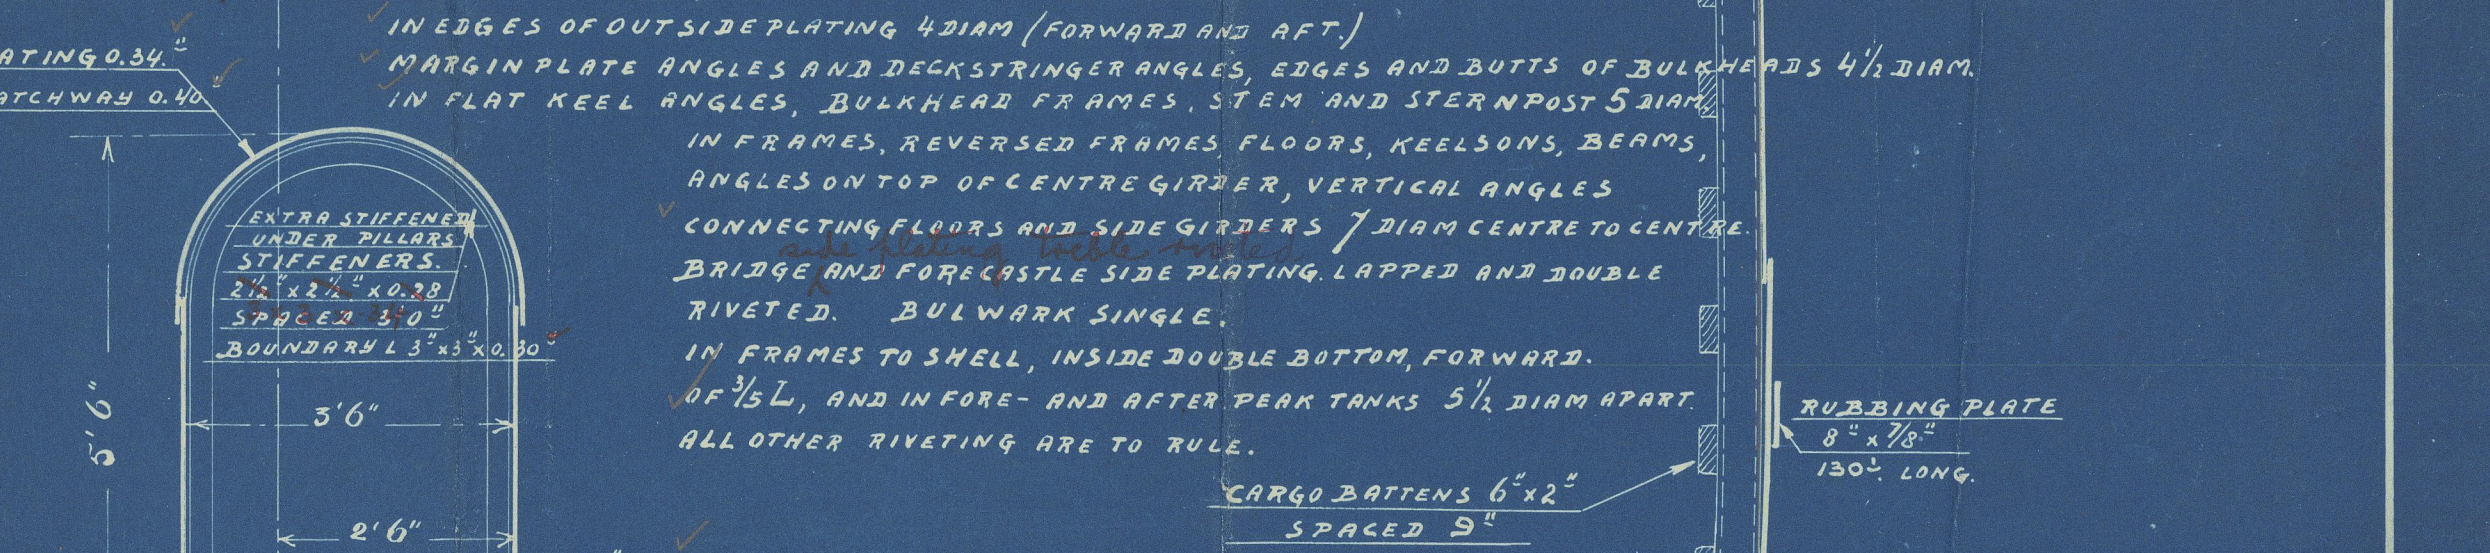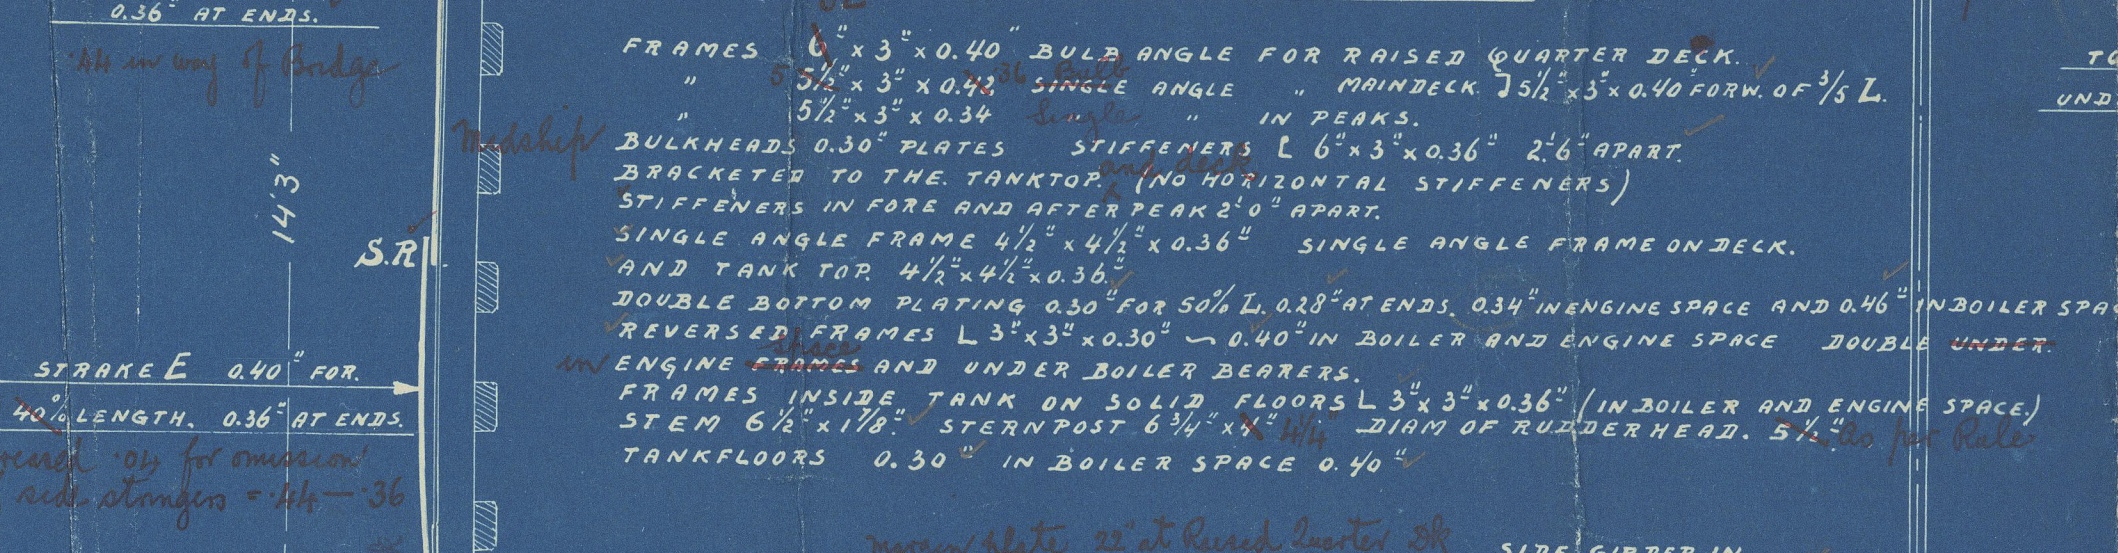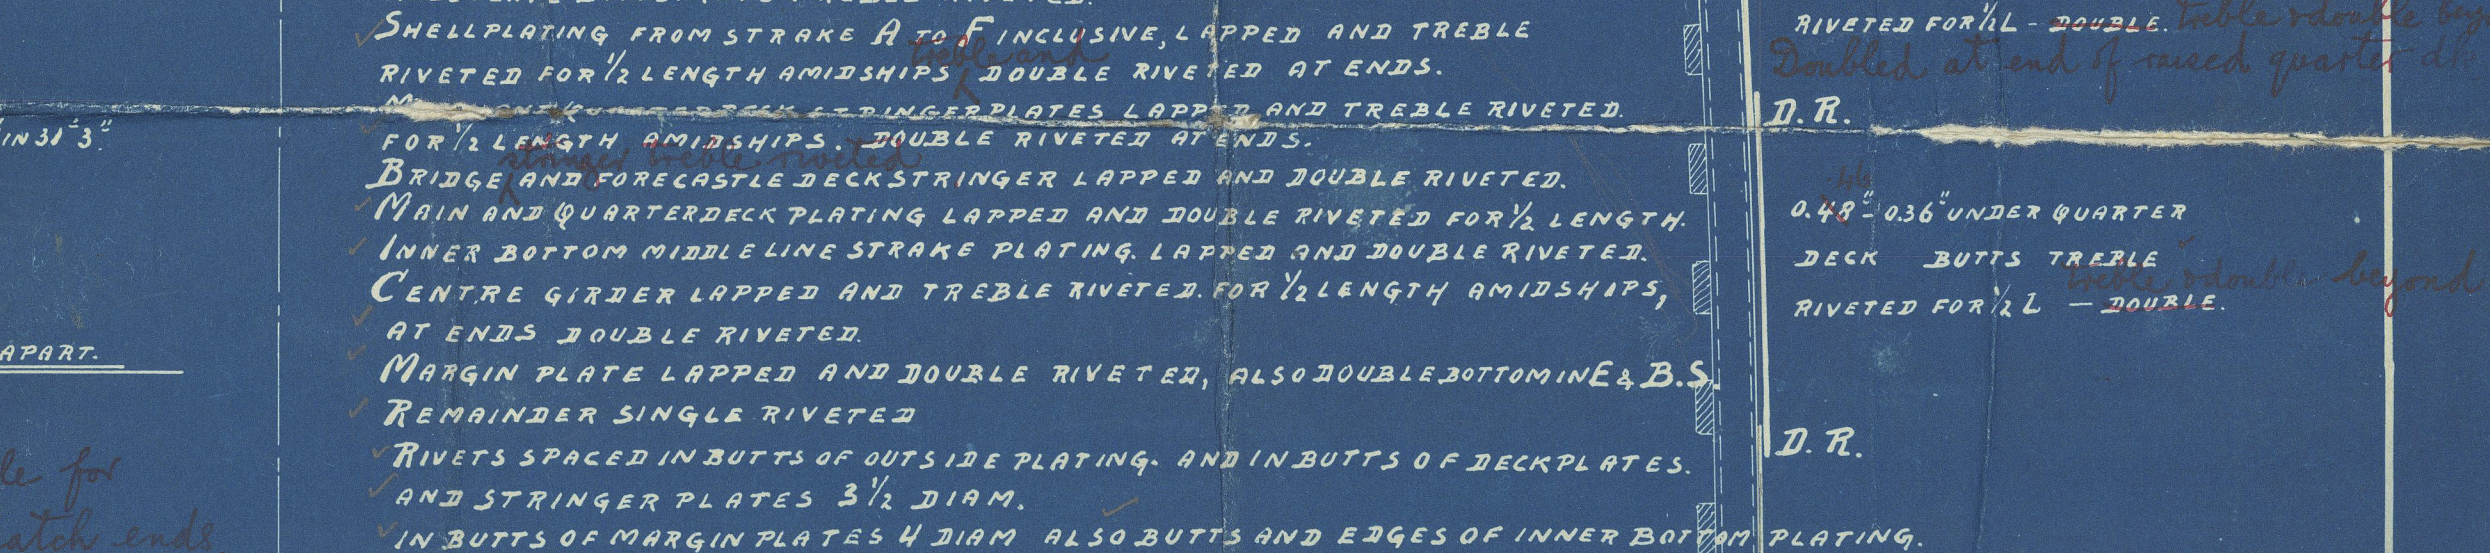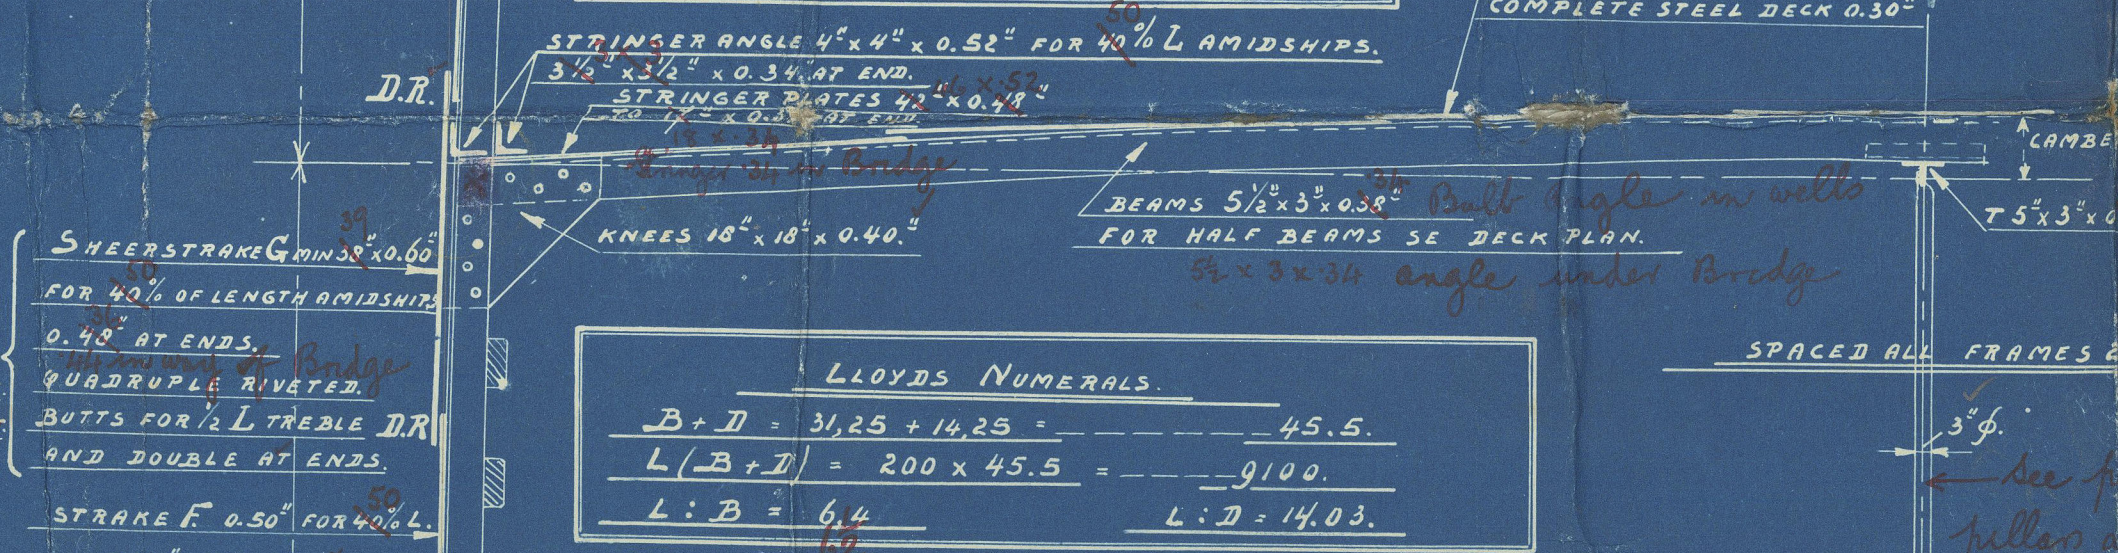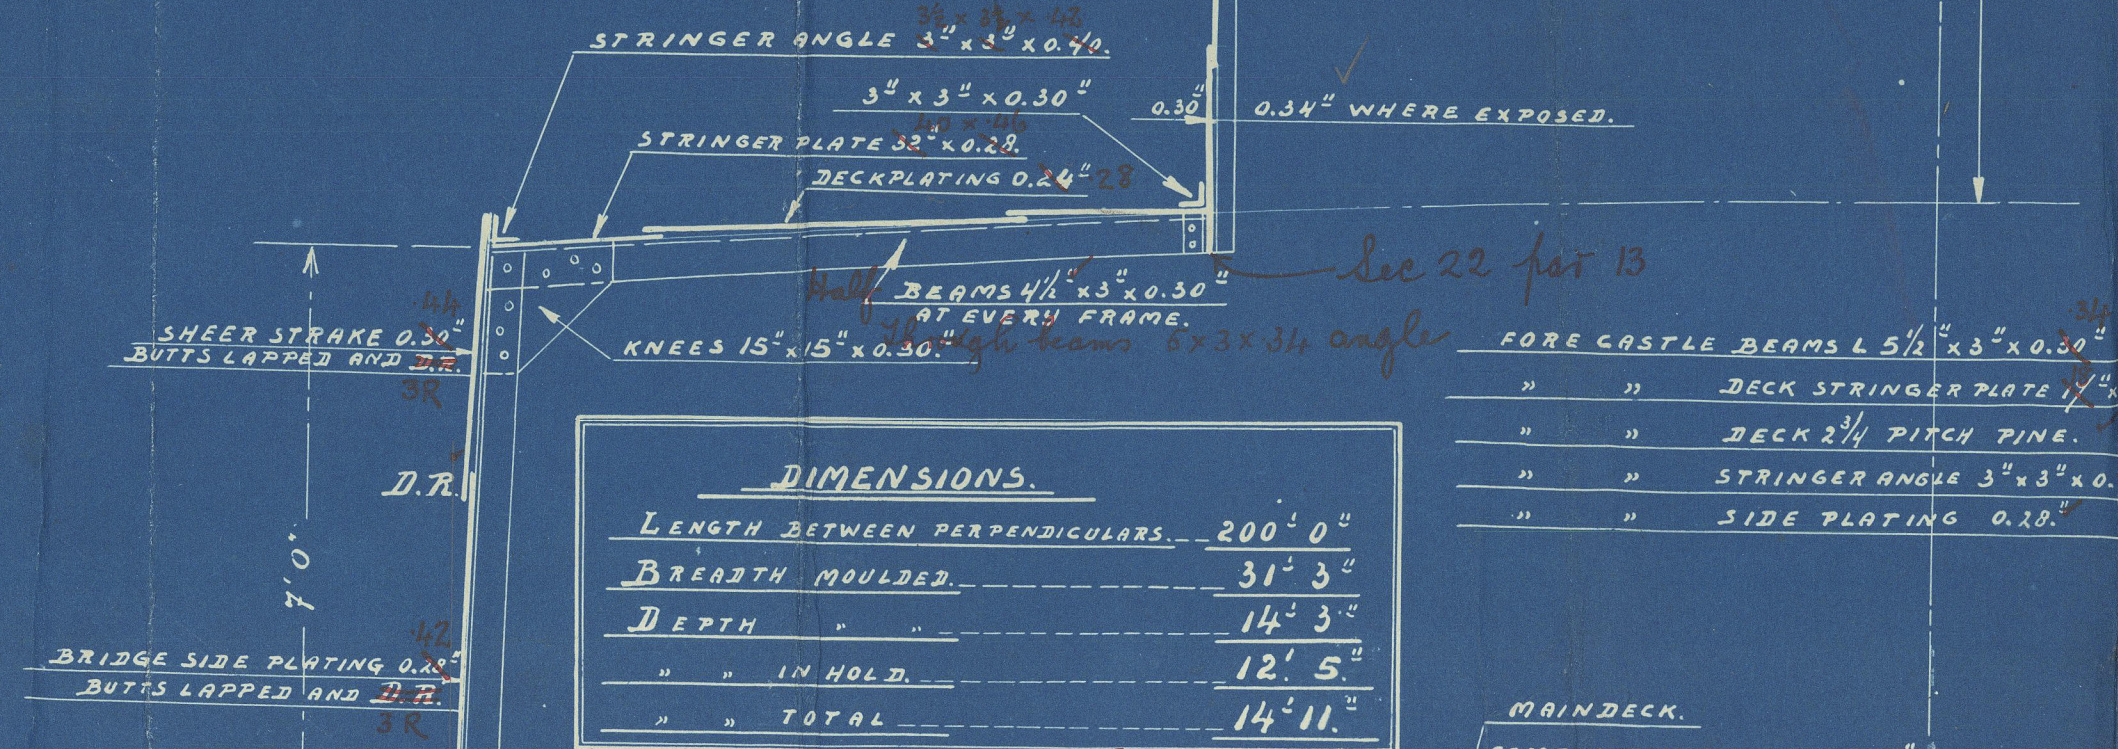




RETAIN

Scheepsbouw Maatschappij

N. S. 411.

Midship Section.

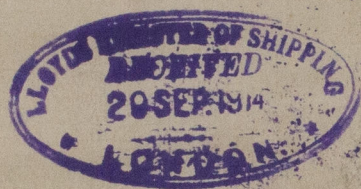

$\frac{5}{8}$ " Dartmeet

Ans by 64.

---



© 2020

Lloyd's Register  
Foundation