

N<sup>o</sup>. 510.


~~N<sup>os</sup> 507 & 9.~~

# MIDSHIP SECTION.

DIMS. 130' B.P. x 22'-1" M<sup>LD</sup> x 12'-10" M<sup>LD</sup> - 12'-0" H<sup>LD</sup>.

STEEL - CLASS 100 A.1. (FOR FISHING PURPOSES.)

SCALE 1/2" = 1 FOOT.

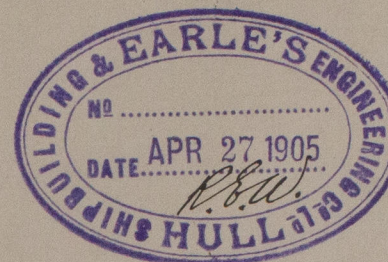

1.5.05

1/2 GIRTH. 20.16  
1/2 BREADTH. 11.04  
DEPTH. 13.33  
44.53 1<sup>st</sup> N<sup>o</sup>

128.792 LENGTH PER RULE.

8906  
40077  
31171  
35624  
8906  
4453  
5735.10776 2<sup>nd</sup> N<sup>o</sup>



L/B = 5.83 L/D = 9.64

## EQUIPMENT.

ONE ANCHOR 5 3/4" CNTS EX. STOCK  
5 1/4"  
3"

105 FTHMS 1 1/2" CHAIN.

60 -- 6" HANSE.  
60 -- 5" WARP.

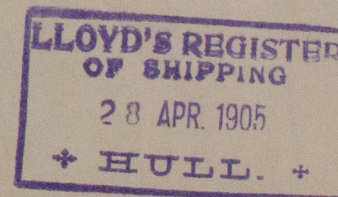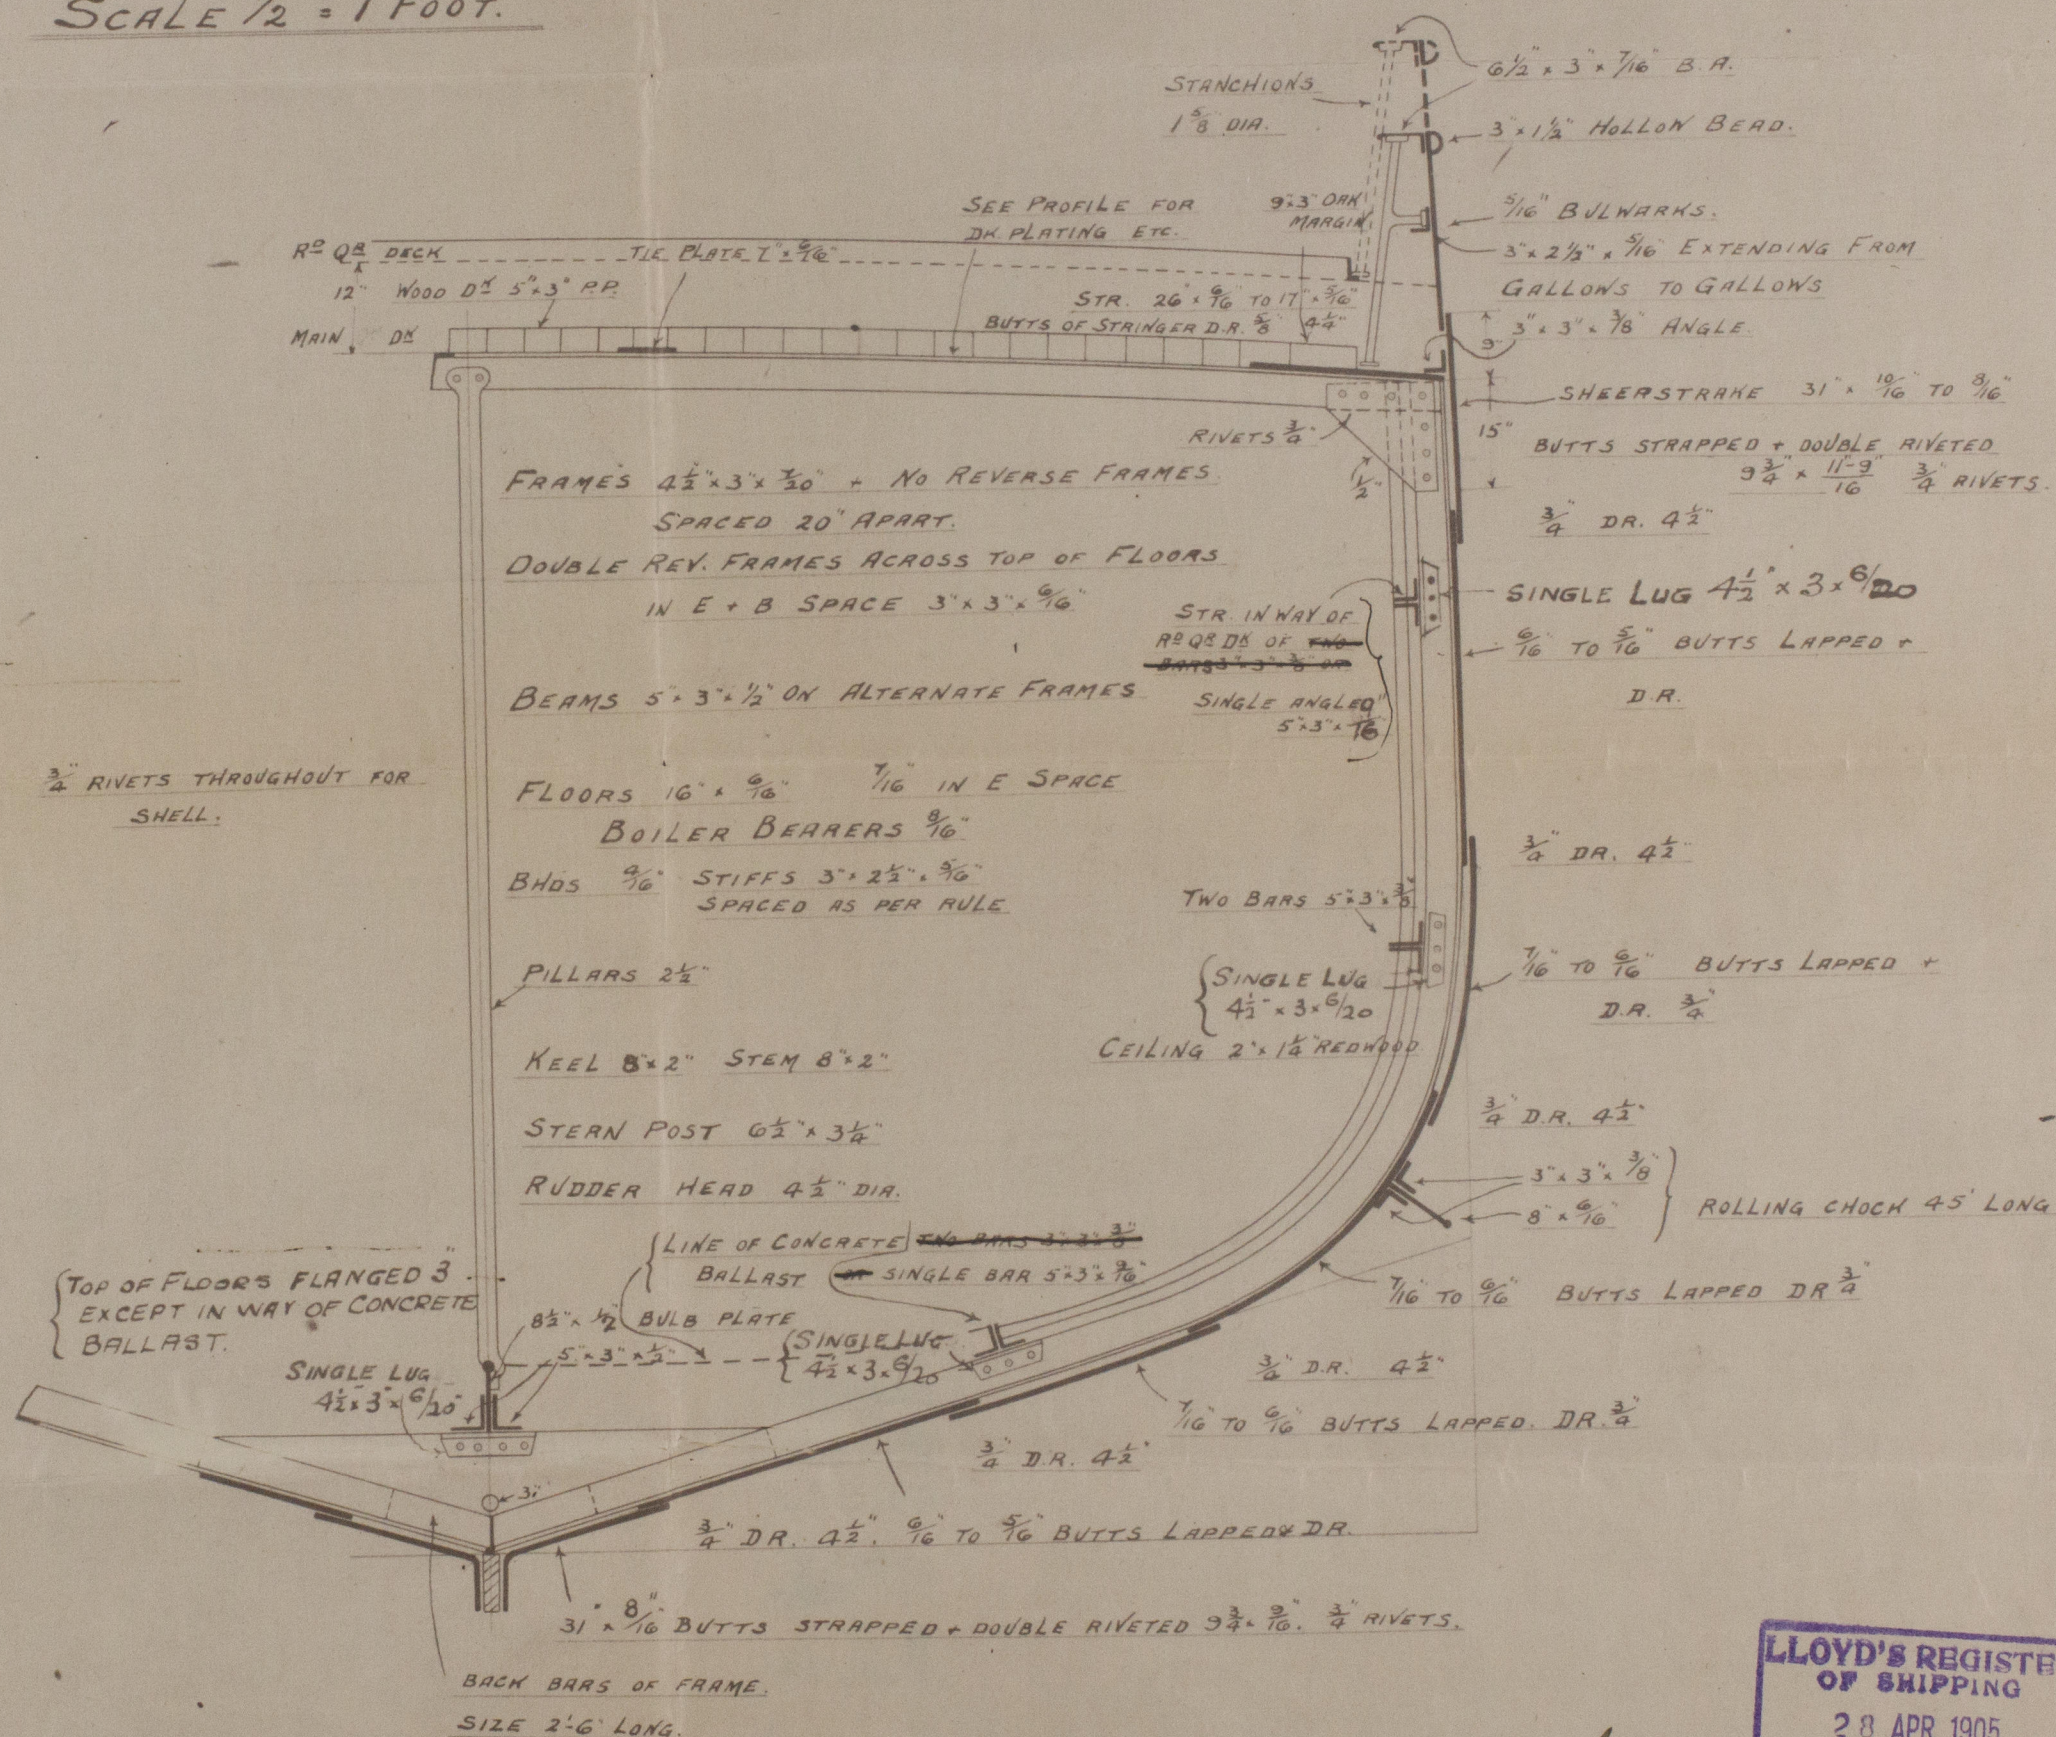

107/05



Earle's S. & E. Co.


Nº 510.

Midship Section



s/s 'Dauntless'

Hull Report Nº 17326

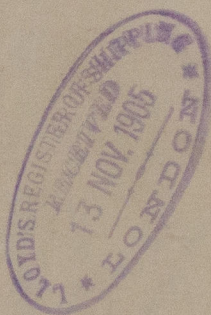

RETAINR

© 2020

Lloyd's Register  
Foundation

W446-0094