

1505

-N° 510-




~~N° 507~~

# PROFILE & DECK PLAN.

130.0 BP x 22.1 MLD x 12.10 MLD.

TO CLASS 100 A.1 STEEL  
FOR FISHING PURPOSES.

SCALE 1/4" = ONE FOOT.

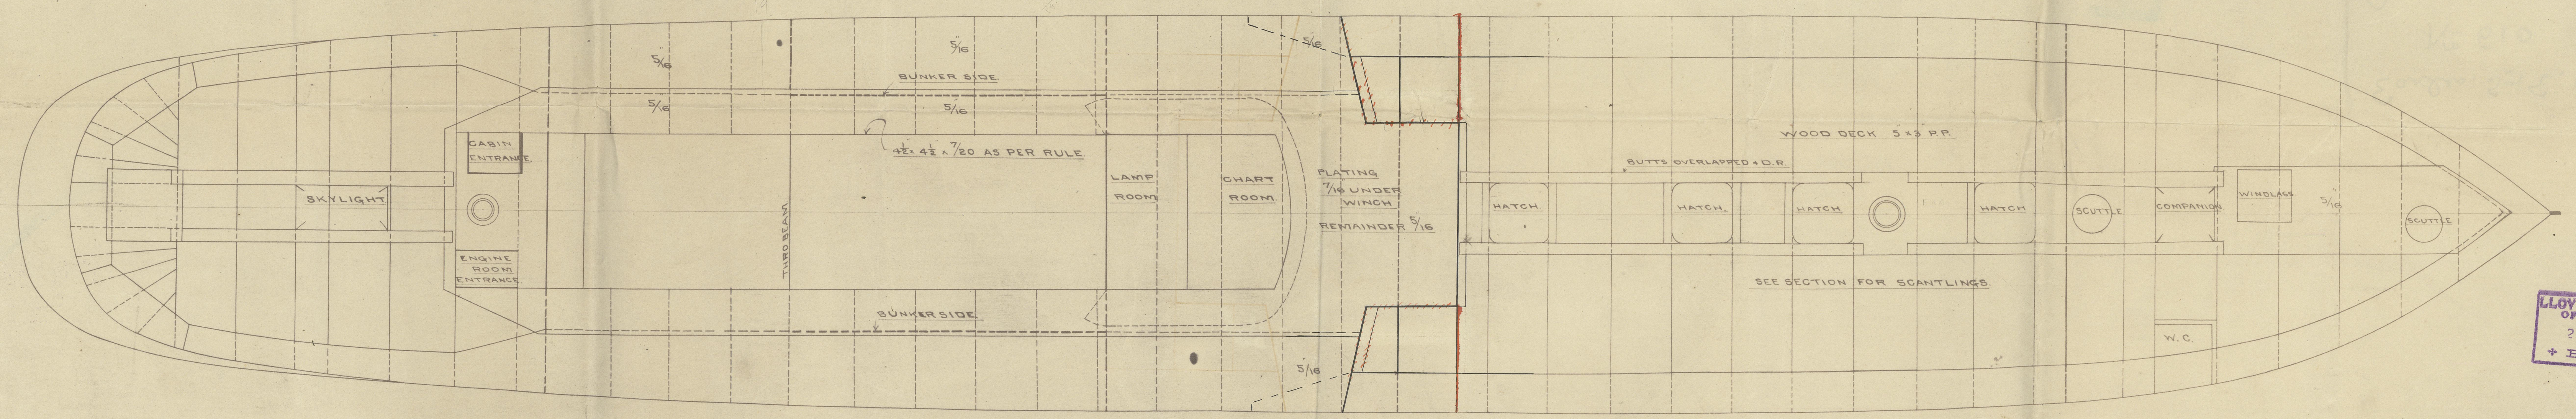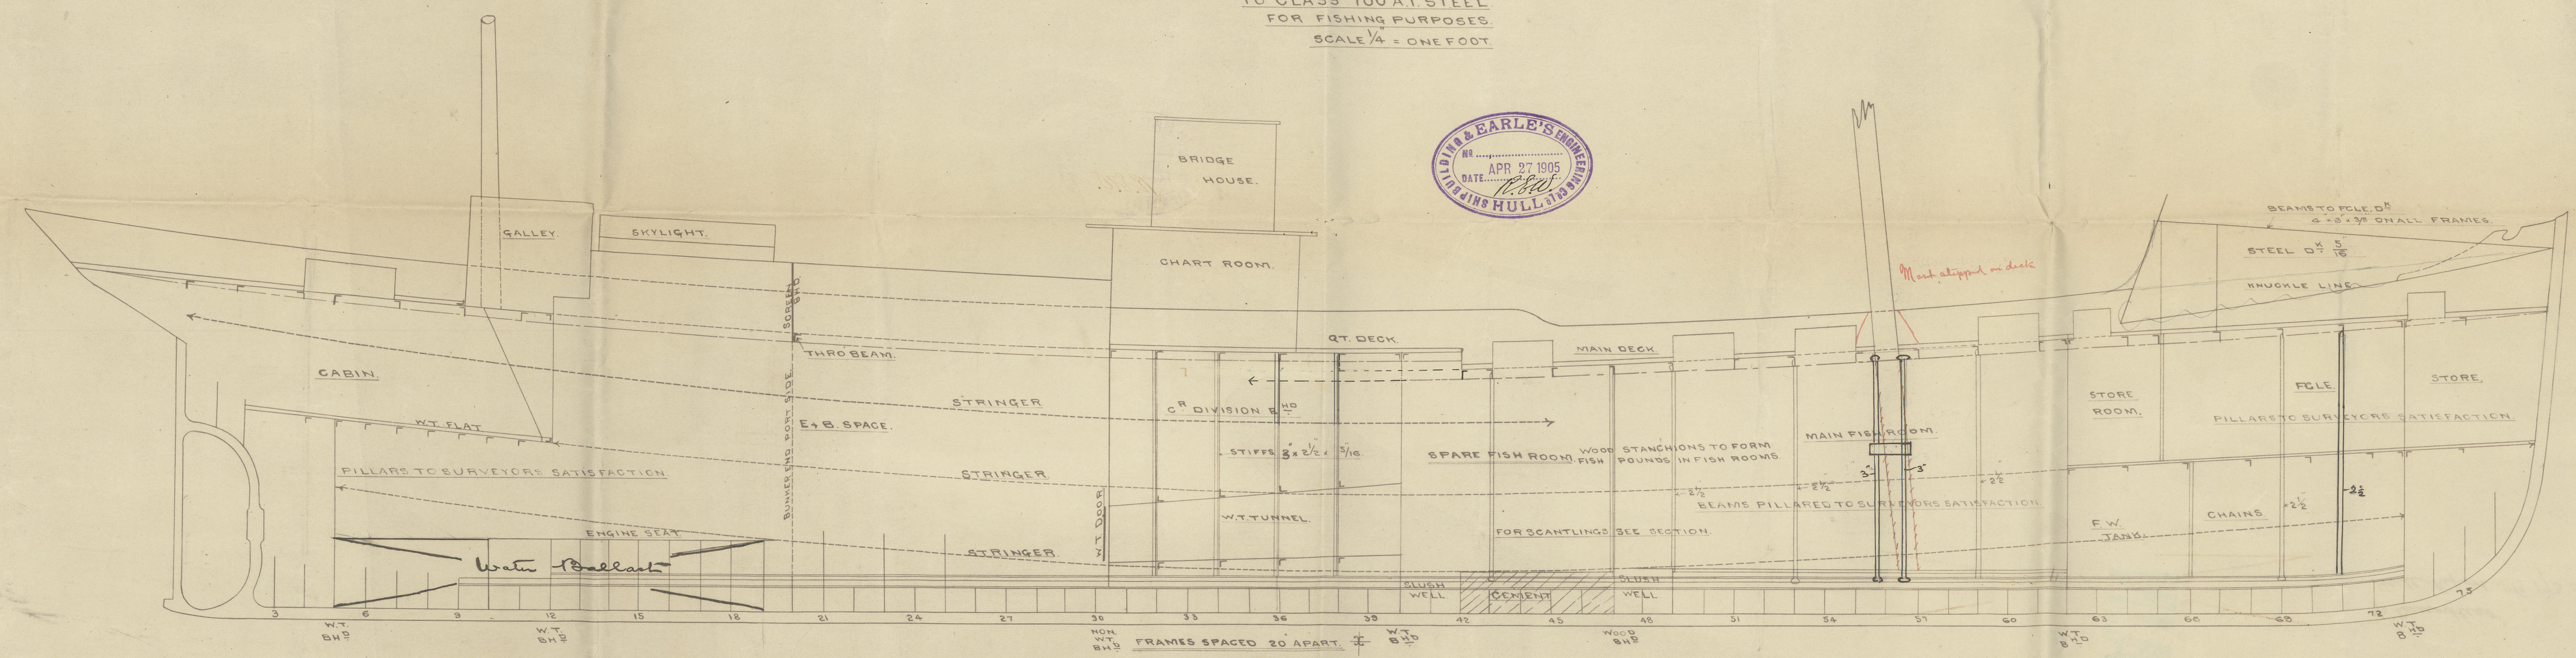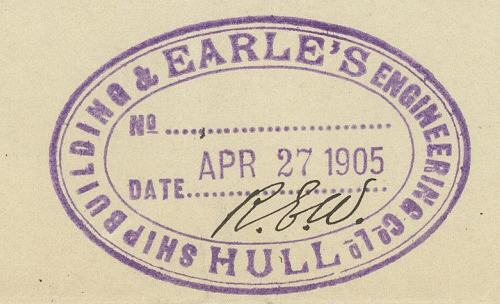

Handwritten signature and date 15/5




RETAIN


Nº 510

Profile + Deck Plan

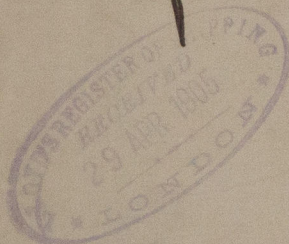

4s Dauntless

Hull Report Nº 17326



© 2020

Lloyd's Register  
Foundation

W 946 + 0045