





24.11.08.  
7.12.08.

# PROFILE & DECK

N<sup>o</sup> 449

DIMENSIONS. LENGTH 83'0" x 17'0" BREADTH M<sup>d</sup> x 10'6" DEPTH M<sup>d</sup>

SCALE 1/4" = 1 FOOT.

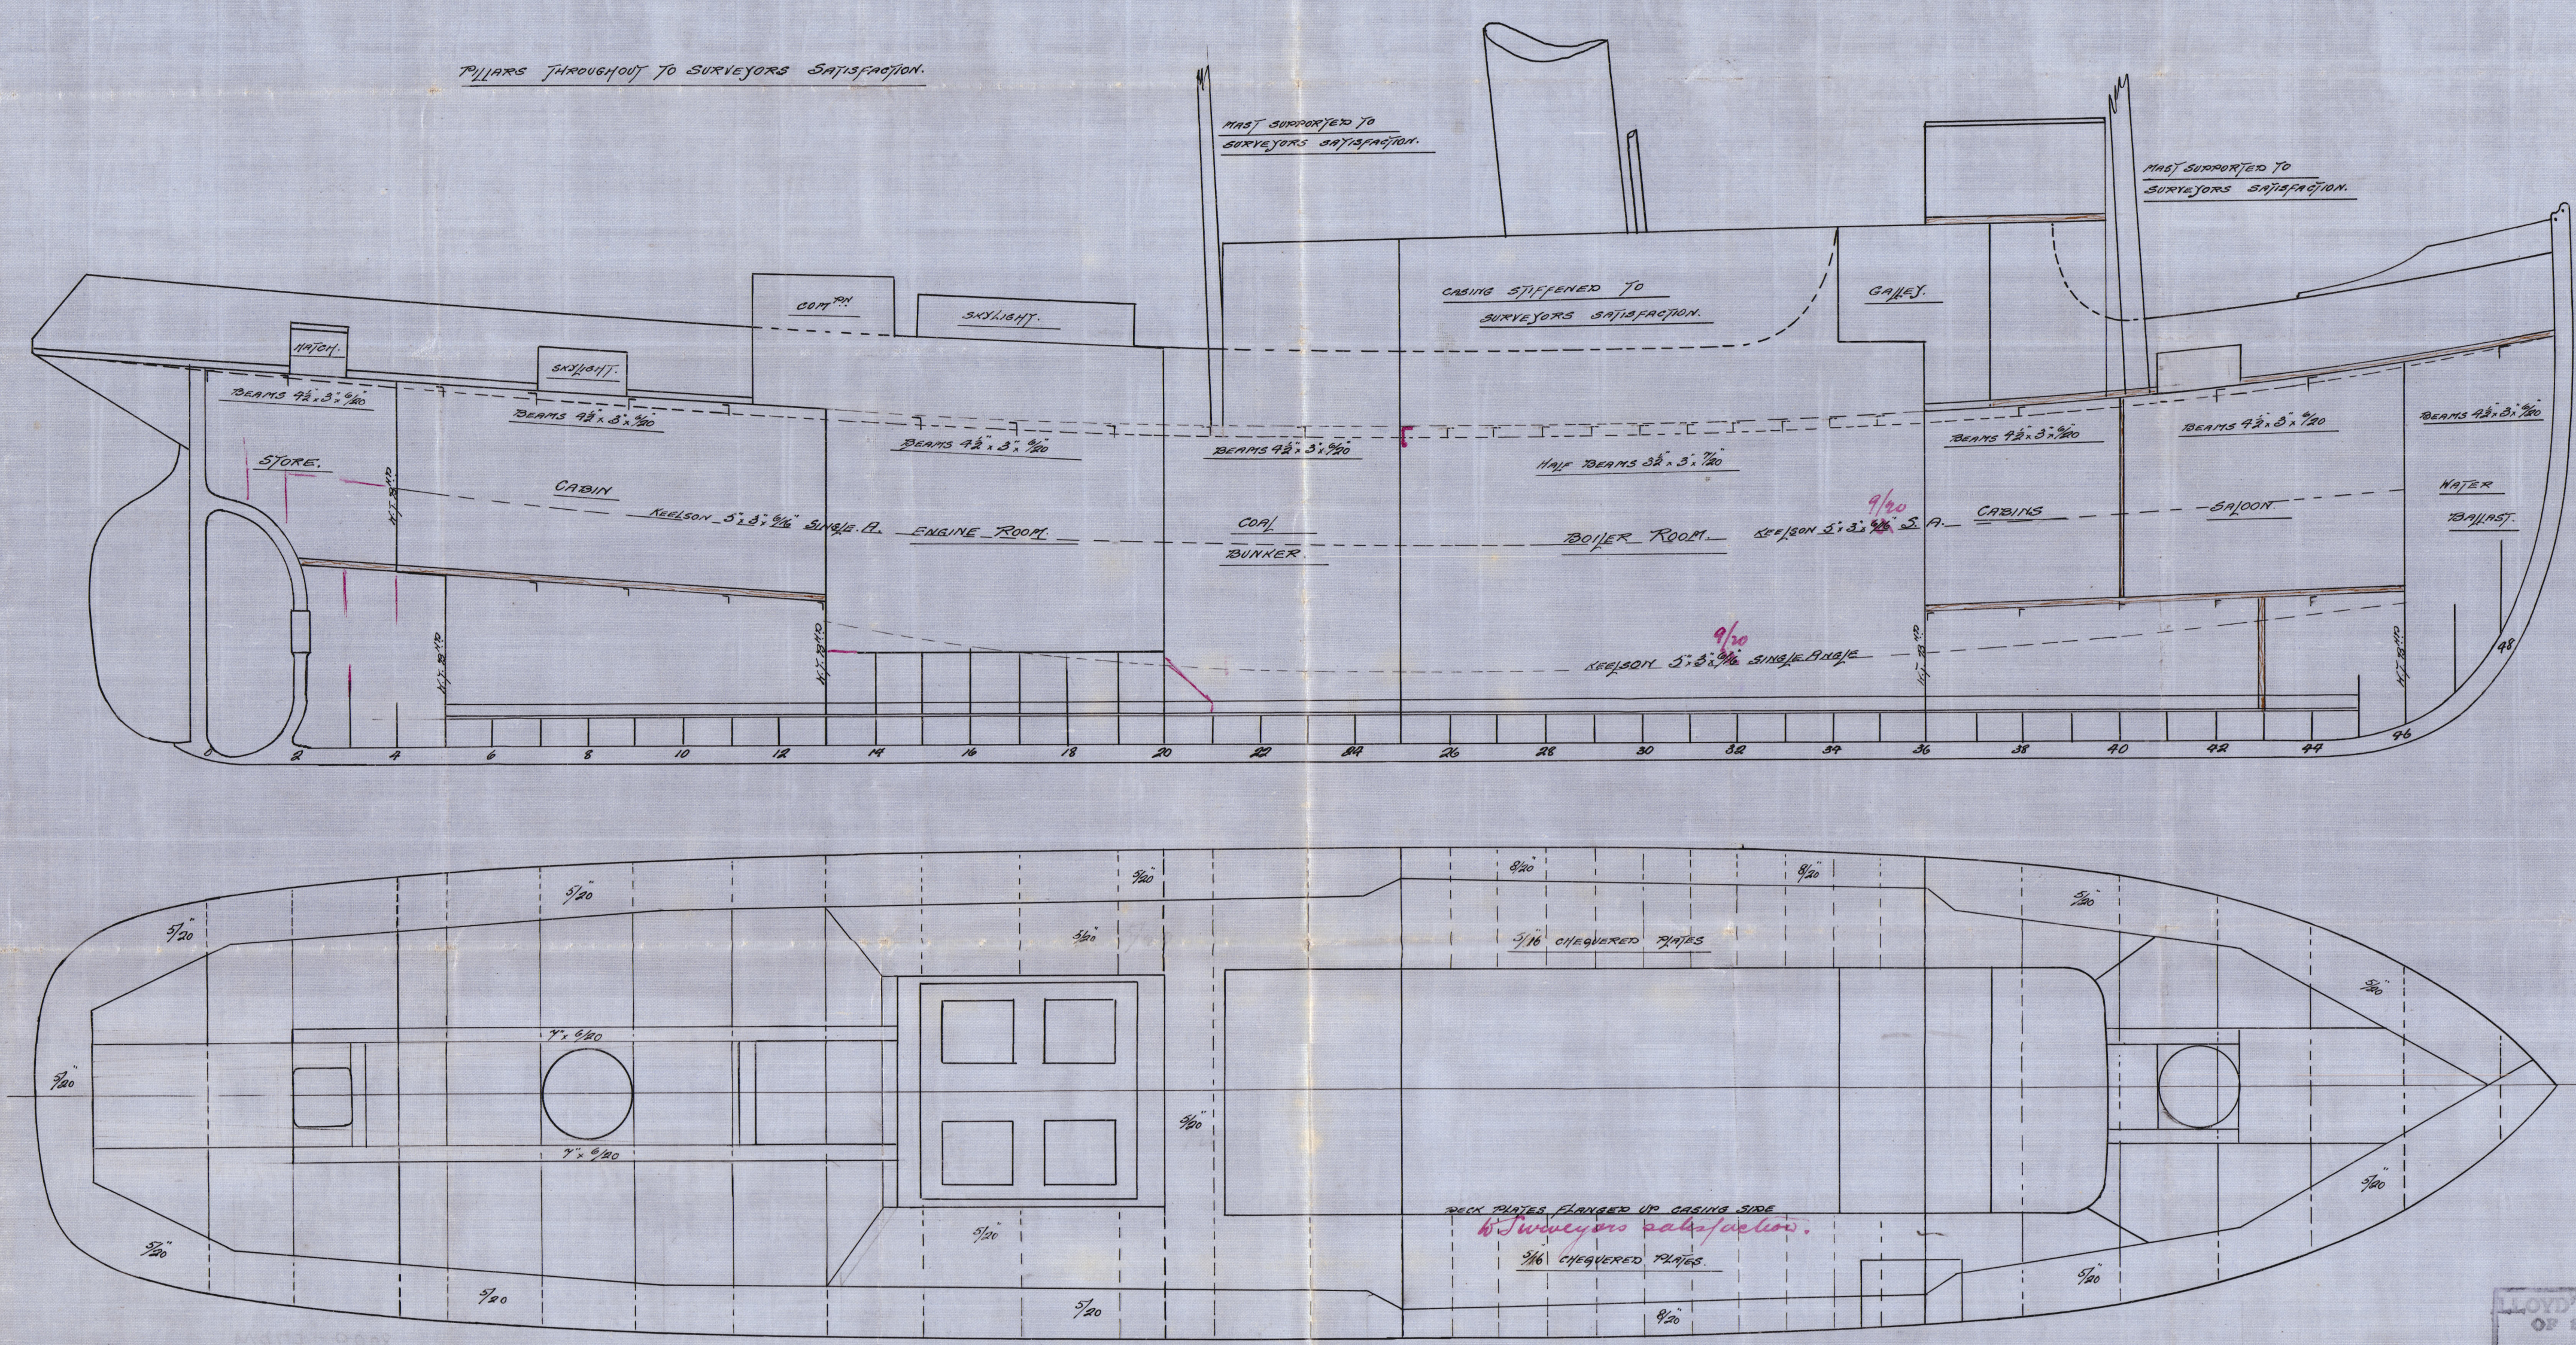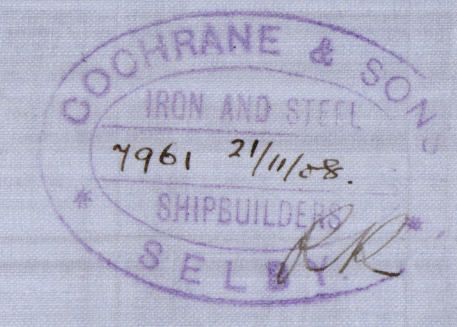

*Handwritten notes in red ink:*  
6' 6\"/>


*Handwritten notes:*  
J.H.  
24/11/08




Cochran & Sons  
No. 449.

Profile & Deck Plan.

s/s Diplomat  
Hull Rpt No 20967

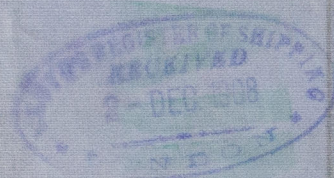

W947-0008

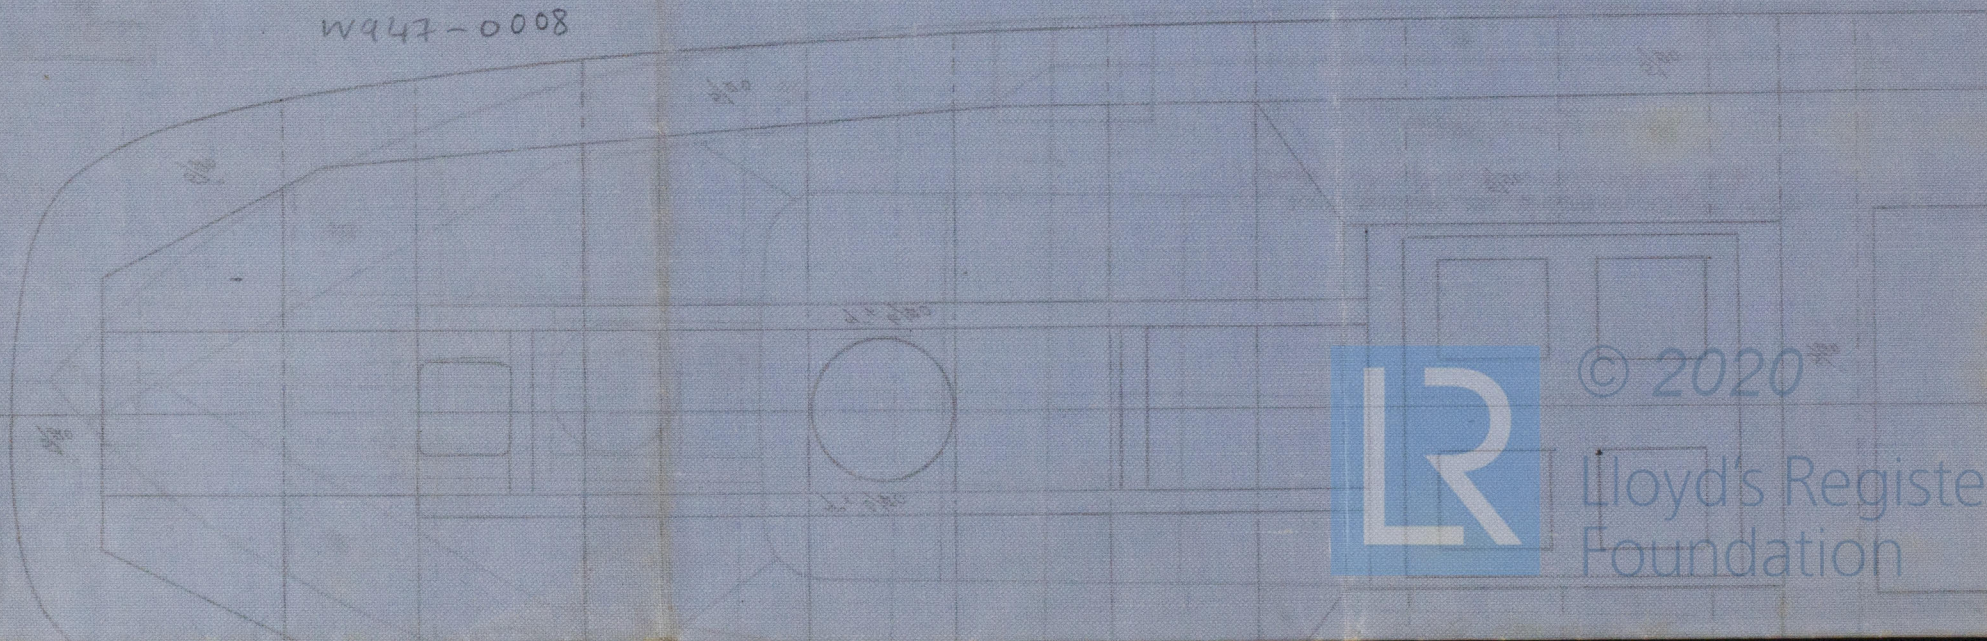

© 2020

Lloyd's Register  
Foundation