



SCHEDULE L

SCALE 1 INCH — ONE FOOT

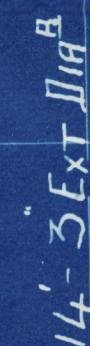

NOTE ALL PLATES STAYS $\frac{1}{2}$ TO BE OF STEEL EXCEPT OTHERWISE SHOWN
TENSILE STRENGTH OF SHELL PLATES TO BE NOT LESS THAN 29 TONS
ALL HOLES DRILLED IN PLACE AFTER PLATES ARE BENT

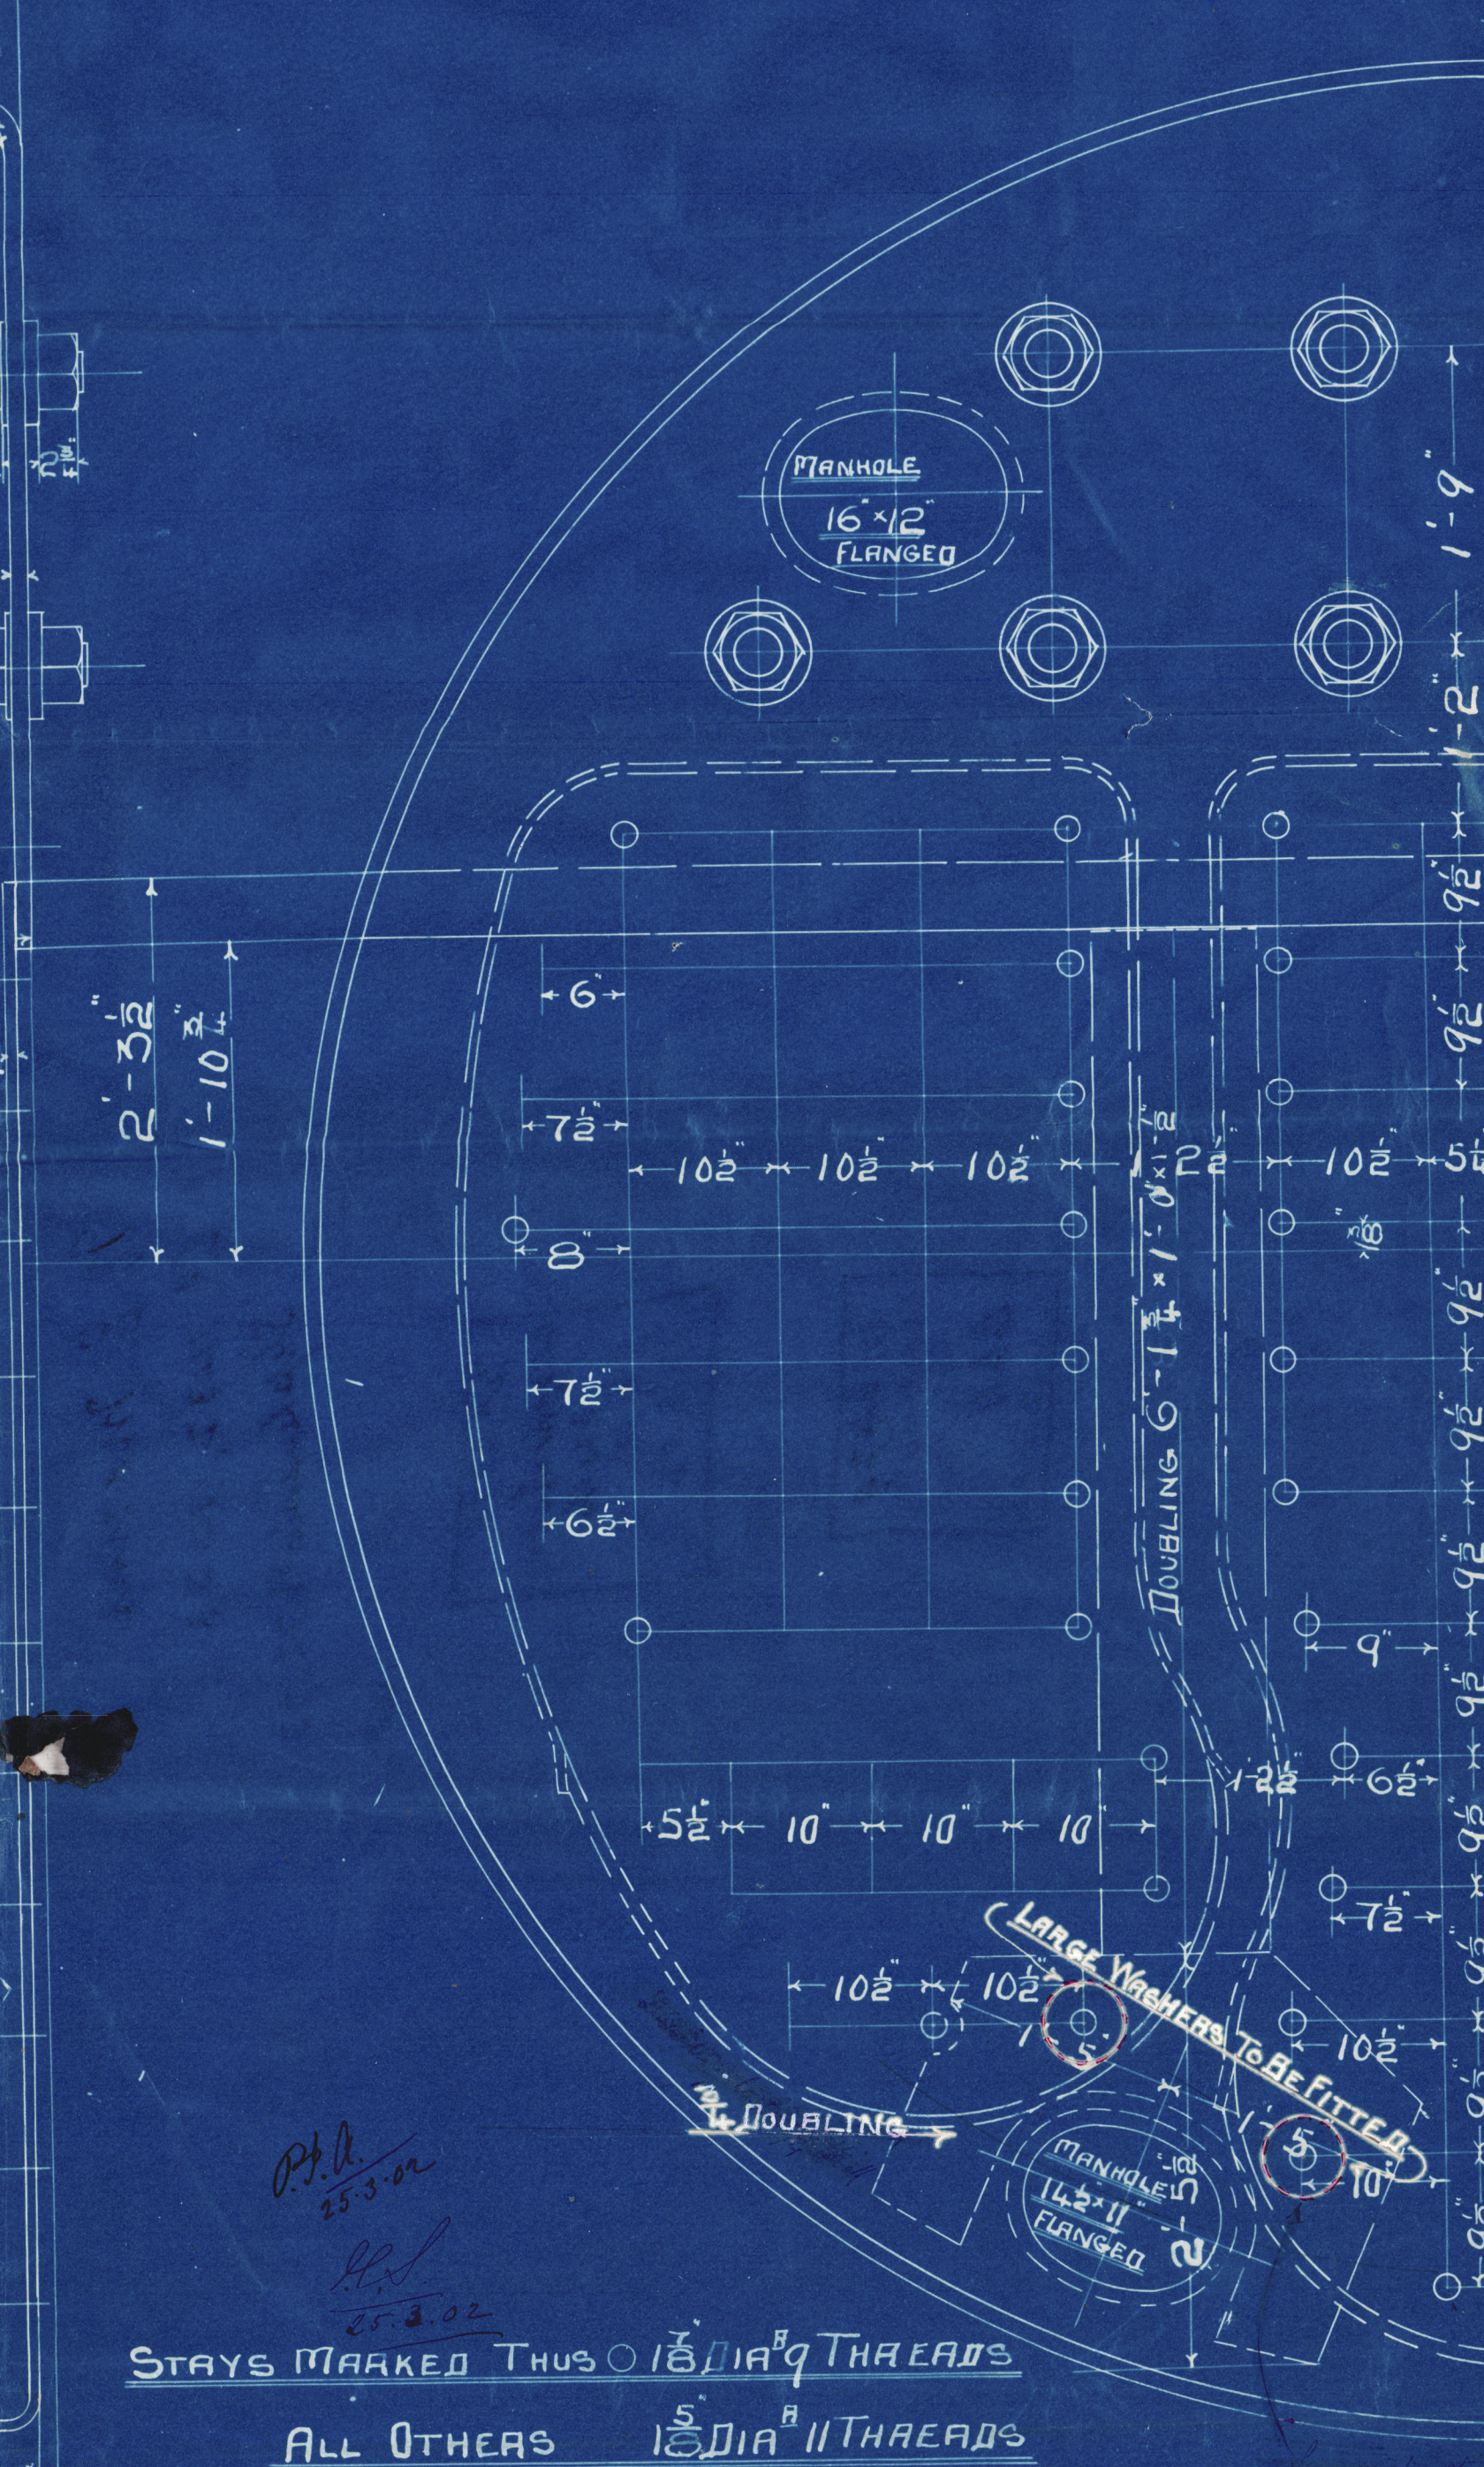

STAYS MARKED THUS \bigcirc 18 DIA⁹ THREADS

ALL OTHERS 10⁵ DIA^H II TNAEAD

NOTE ALL STAYS SCREWED AND FITTED WITH NUTS

1 THUS
1 OPPOSITE HAND

CONTRACT 1433
1432

W947-0040 1/2

N. E. M. E. CO., LIMITED, WALLSEND.

ENCLOSURE
FOR

Messrs.

Lloyd's Surveyor

Lloyd's Register
Foundation

W947-0040

N E. Marine

C. 1432, 1433

Stephensons 9/5 72, 73

WP/64

No 6378
Lloyd's List
320 lbs
J. H. H.
13.8.02

1432

No 6429
Lloyd's List
320 lbs.
G. A. H.
22.10.02

1433



J. G. Meldon



Newcastle Dockyard

© 2020
Lloyd's Register
Foundation