

19.8.04


— PROFILE & DECK PLAN —

— STEEL STEAM TRAWLER —

— N° 331. —

— 132'-0" x 22'-0" x 13'-2" MLD —

— SCALE  $\frac{1}{4}$ " = 1 FOOT. —

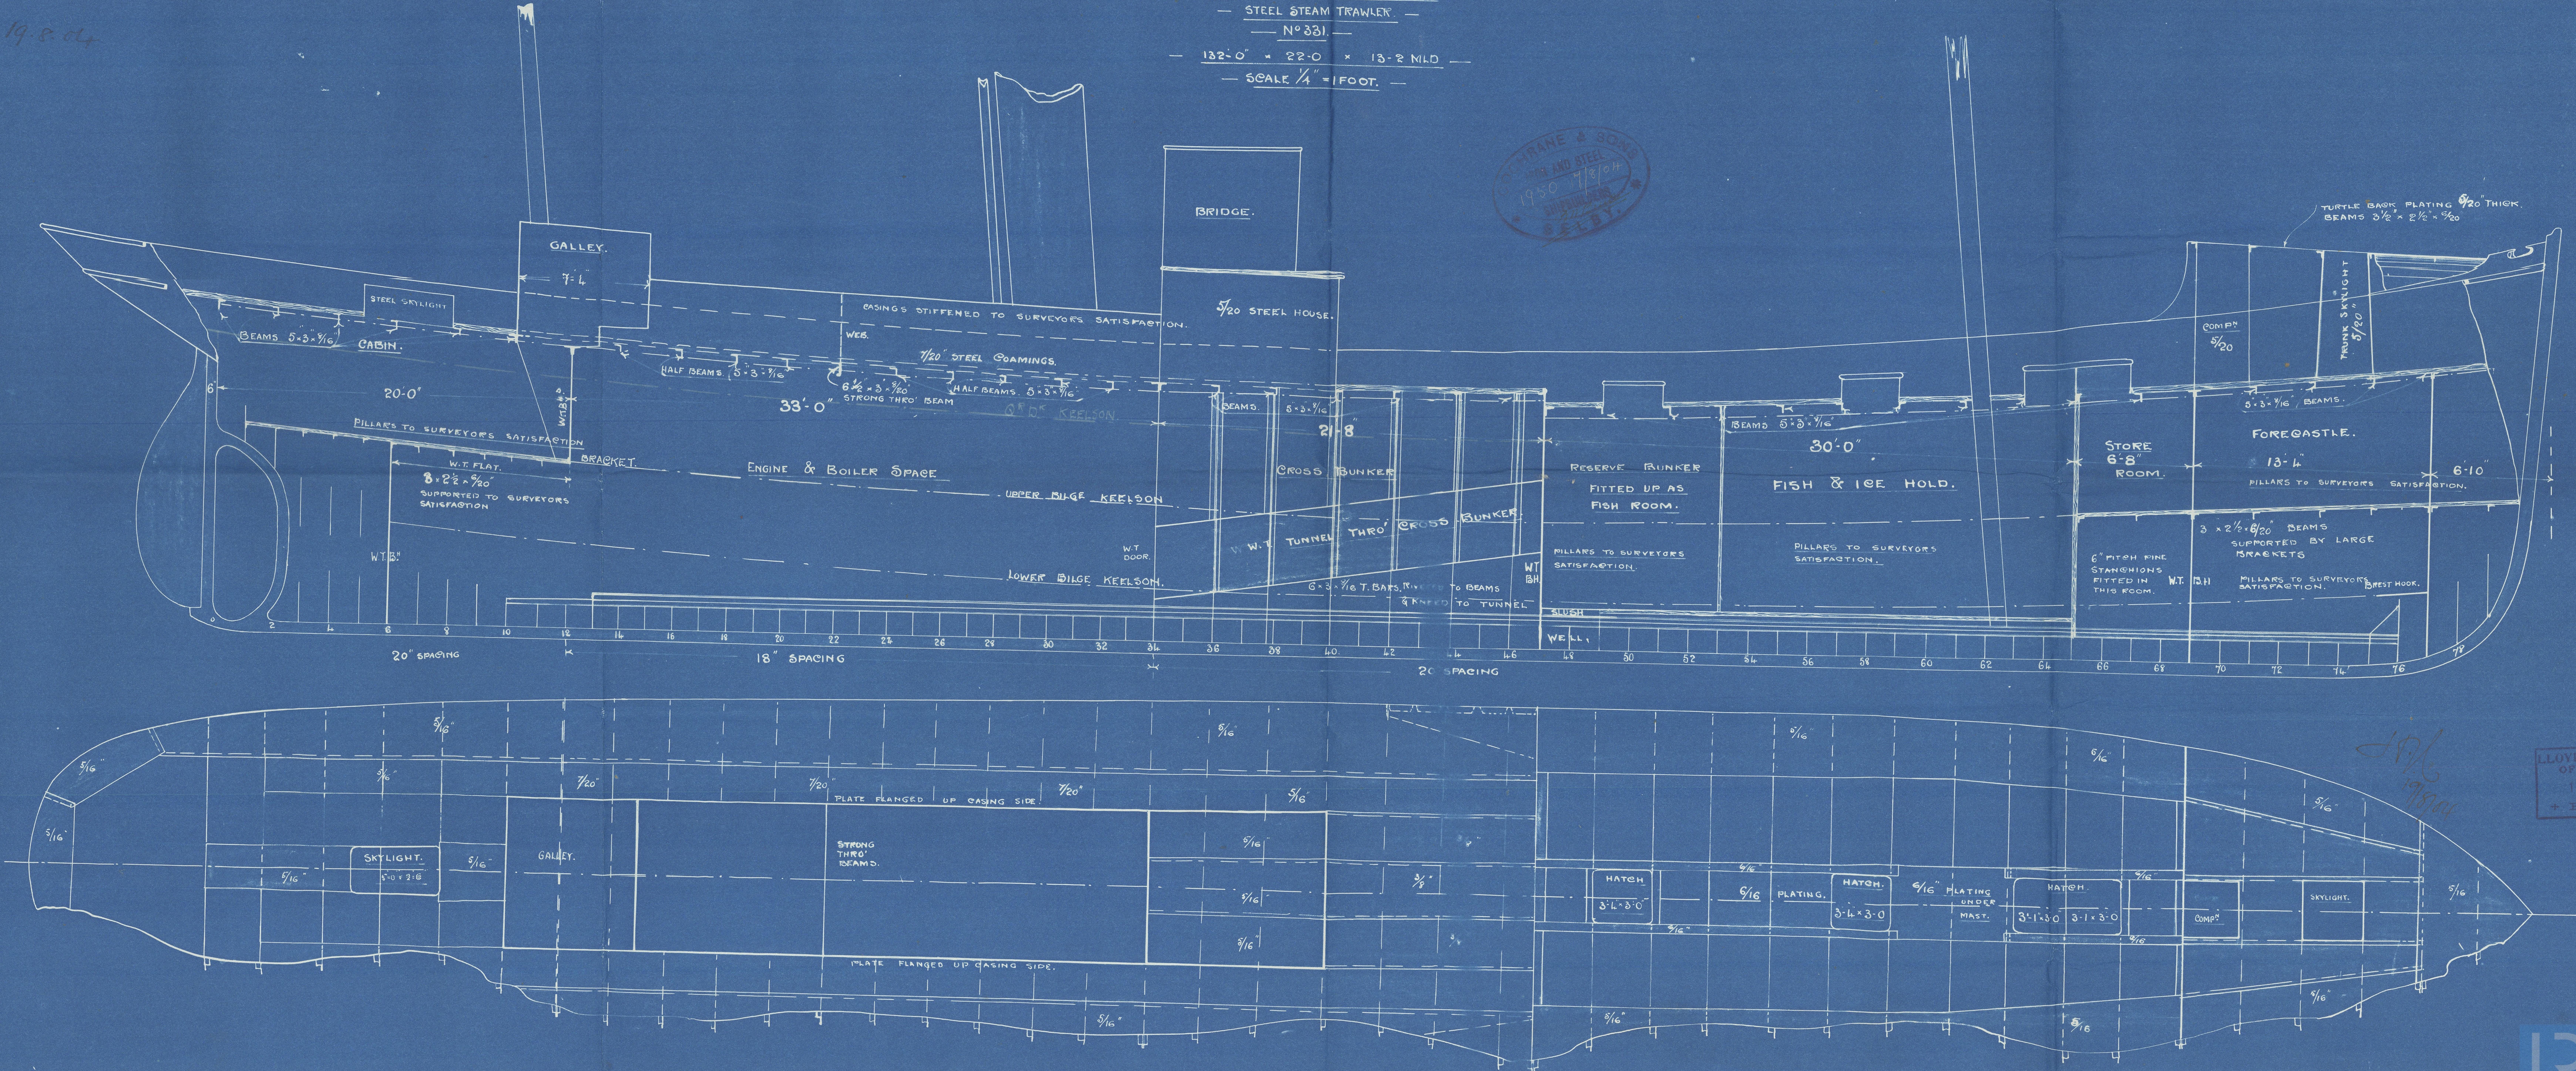

LLOYD'S REGISTER  
OF SHIPPING  
17 AUG 1904  
HULL



- Profile Deck Plan -

Steel Steam Trawler

- No 331 -

Lochman & Son

Selby



Sp. Dray

Hull Report No. 16548

RETAIN



© 2020

Lloyd's Register  
Foundation

W948-0112