

15.4.07.

EQUIPMENT. (V)

2 BOWER ANCHORS 35 1/2 CWT. STOCKLESS. } COLL'S WEIGHT.
 1 --- 30 --- 101 CWT.
 1 STREAM --- 9 7/8 --- EX. STOCK.
 1 KEDGE --- 7 7/8 ---
 290 FATHOMS --- 1 1/2" STUO CHAIN CABLE MIN. WEIGHT 370 LBS. 22.
 75 --- 1 1/2" STREAM CHAIN, OR 7 STEEL WIRE.
 30 --- 1 1/2" TOWLINE, OR 3 1/2" STEEL WIRE.
 2 @ 90 --- 5 HAWSER.
 2 @ 90 --- 4 WARR.
 2 @ 90 --- 2 STEEL WIRE ROPE.

MIDSHIP SECTION.

S.S.N^o 184.

SCALE 1/2" = 1 FOOT.



DIMENSIONS: 270-0 B.P. x 39-6 x 20-0 M⁴P

AWNING DECK VESSEL. TO CLASS 100 A.I. AT LLOYD'S.

NUMERALS.

DEPTH --- 20.82.
 1/2 BREADTH --- 19.75
 1/2 CIRTH --- 37.91
 1 1/2 M^o --- 77.98 x 268.5
 2 1/2 --- 20937.63.
 + 3020 ERECTIONS.
 + 236 SIDE HOUSES.
 EQUIP^E N^o --- 29193.

ERECTIONS.

AWNING D^s 2685.75 x 1 1/2" = 3020.


PROPORTIONS.

BREADTHS TO LENGTH 6.79.
 DEPTHS TO LENGTH 12.89.

RIVETING.

KEEL (TAIL PIECES) STEM, STERN POST & RUDDER 1/8" RIVETS 5/8" CENTRES.
 FRAMES TO 1/8" RIVETS, 6" CENTRES THROUGH FRAME & SHELL.
 BEAMS 7/8" RIVETS, 5/8" CENTRES THROUGH STRINGERS, 7/8" RIVETS, 5/8"
 CENTRES TO 1/8" RIVETS, 9/8" CENTRES THROUGH DECK PLATING.
 BUTTS OF AWNING D^s STRINGERS STRAPPED & TREBLE RIVETED WITH
 DOUBLE STRAPS FOR 2 L (STRAPS 20 THICK) DOUBLE RIVETED AT ENDS
 WITH SINGLE STRAPS (20 THICKER THAN PLATES)
 BUTTS OF MAIN D^s STRINGER STRAPPED & TREBLE RIVETED FOR 2 L WITH
 STRAPS 20 THICKER THAN PLATES, DOUBLE RIVETED AT ENDS (STRAPS 20 THICKER
 THAN PLATES) ALL OTHER STRINGERS STIES DOUBLE RIVETED.
 BUTTS OF DECK PLATING DOUBLE RIVETED WITH 7/8" RIVETS
 TO SINGLE RIVETED WITH 5/8" RIVETS AT ENDS.
 LANDINGS OF DECK PLATING SINGLE RIVETED 7/8" RIVETS TO 5/8" AT ENDS.
 --- FLAT PLATE KEEL 1/8" RIVETS TO 5/8" AT ENDS, 5 TO 6 RIVETS IN SPACE.
 --- SHEER STRAKE 7/8" RIVETS TO 5/8" AT ENDS, 6 TO 7 RIVETS IN SPACE.
 --- SHELL PLATING 7/8" RIVETS TO 5/8" AT ENDS, 6 TO 7 RIVETS IN SPACE.
 --- TOP SIDES 7/8" RIVETS TO 5/8" AT ENDS, 6 TO 7 RIVETS IN SPACE.
 BUTTS OF FLAT PLATE KEEL TREBLE RIVETED THROUGHOUT STRAPS 20 TO 20 THICK.
 BUTTS OF SHEER STRAKE TREBLE RIVETED THROUGHOUT.
 BUTTS OF SHEER STRAKE TREBLE RIVETED STRAPS 20 THICKER.
 --- TOP SIDES TREBLE RIVETED 7/8" RIVETS TO 5/8".

SECTION IN WAY OF ENGINE SPACE.

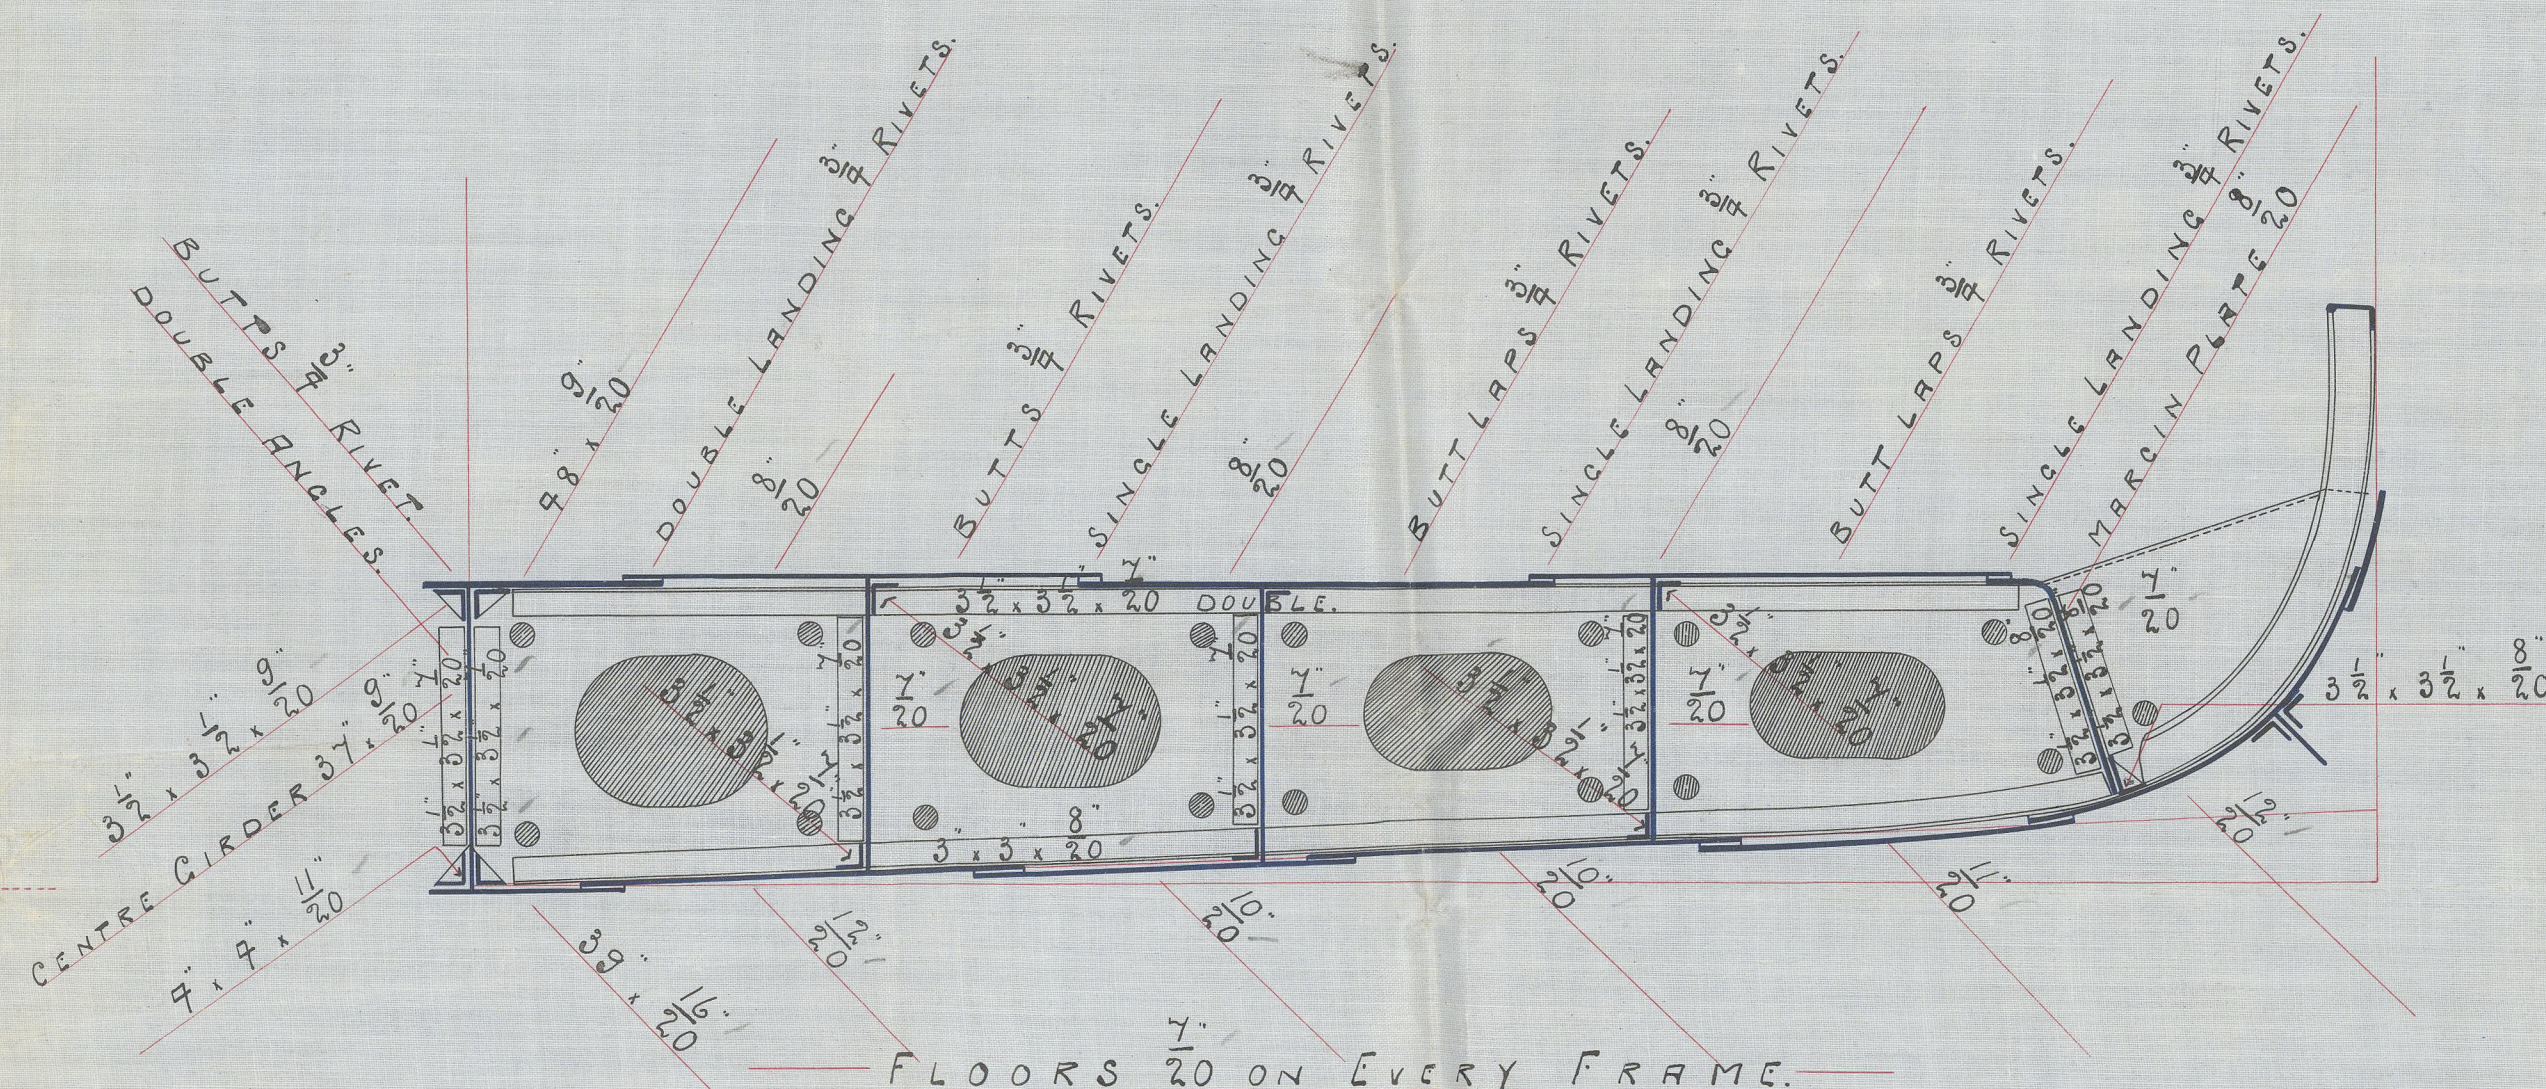

FLOORS 20 ON EVERY FRAME.

15.4.07.

15.4.07.

Messy. Ailsa. S.P. Co. Ltd.

S/s. No. 1844.

Midship Section

11. "Drake"

Glasgow Report No. 26453

RETAIN

RETAIN

181

W948-0146



© 2020

Lloyd's Register
Foundation