

10.6.07

N^{OS} 539-40

MIDSHIP SECTION.

DIMENSIONS 141-8 BP x 23-0 EX. x 13-0 M^{LD}

STEEL TO CLASS 100 A1 FOR FISHING PURPOSES.

SCALE $\frac{1}{2}$ = 1 FOOT.




NUMERALS

DEPTH = 13-5
 $\frac{1}{2}$ BREADTH = 11-43
 $\frac{1}{2}$ GIRTH = 21-25
 46-18 = 1ST N^O
 140-46 = LENGTH
 277 08
 18472
 184720
 4618
 6486428 = 2ND N^O

$\frac{L}{B}$ = 6-14
 $\frac{L}{D}$ = 10-40

EQUIPMENT

ONE ANCHOR $6\frac{1}{4}$ CWT EX. STOCK
 " " $5\frac{3}{4}$ " " "
 " " $3\frac{1}{4}$ " " "
 120 FATHOMS $\frac{1}{8}$ CABLE
 60 " 6 HAWSER
 60 " 5 WARP

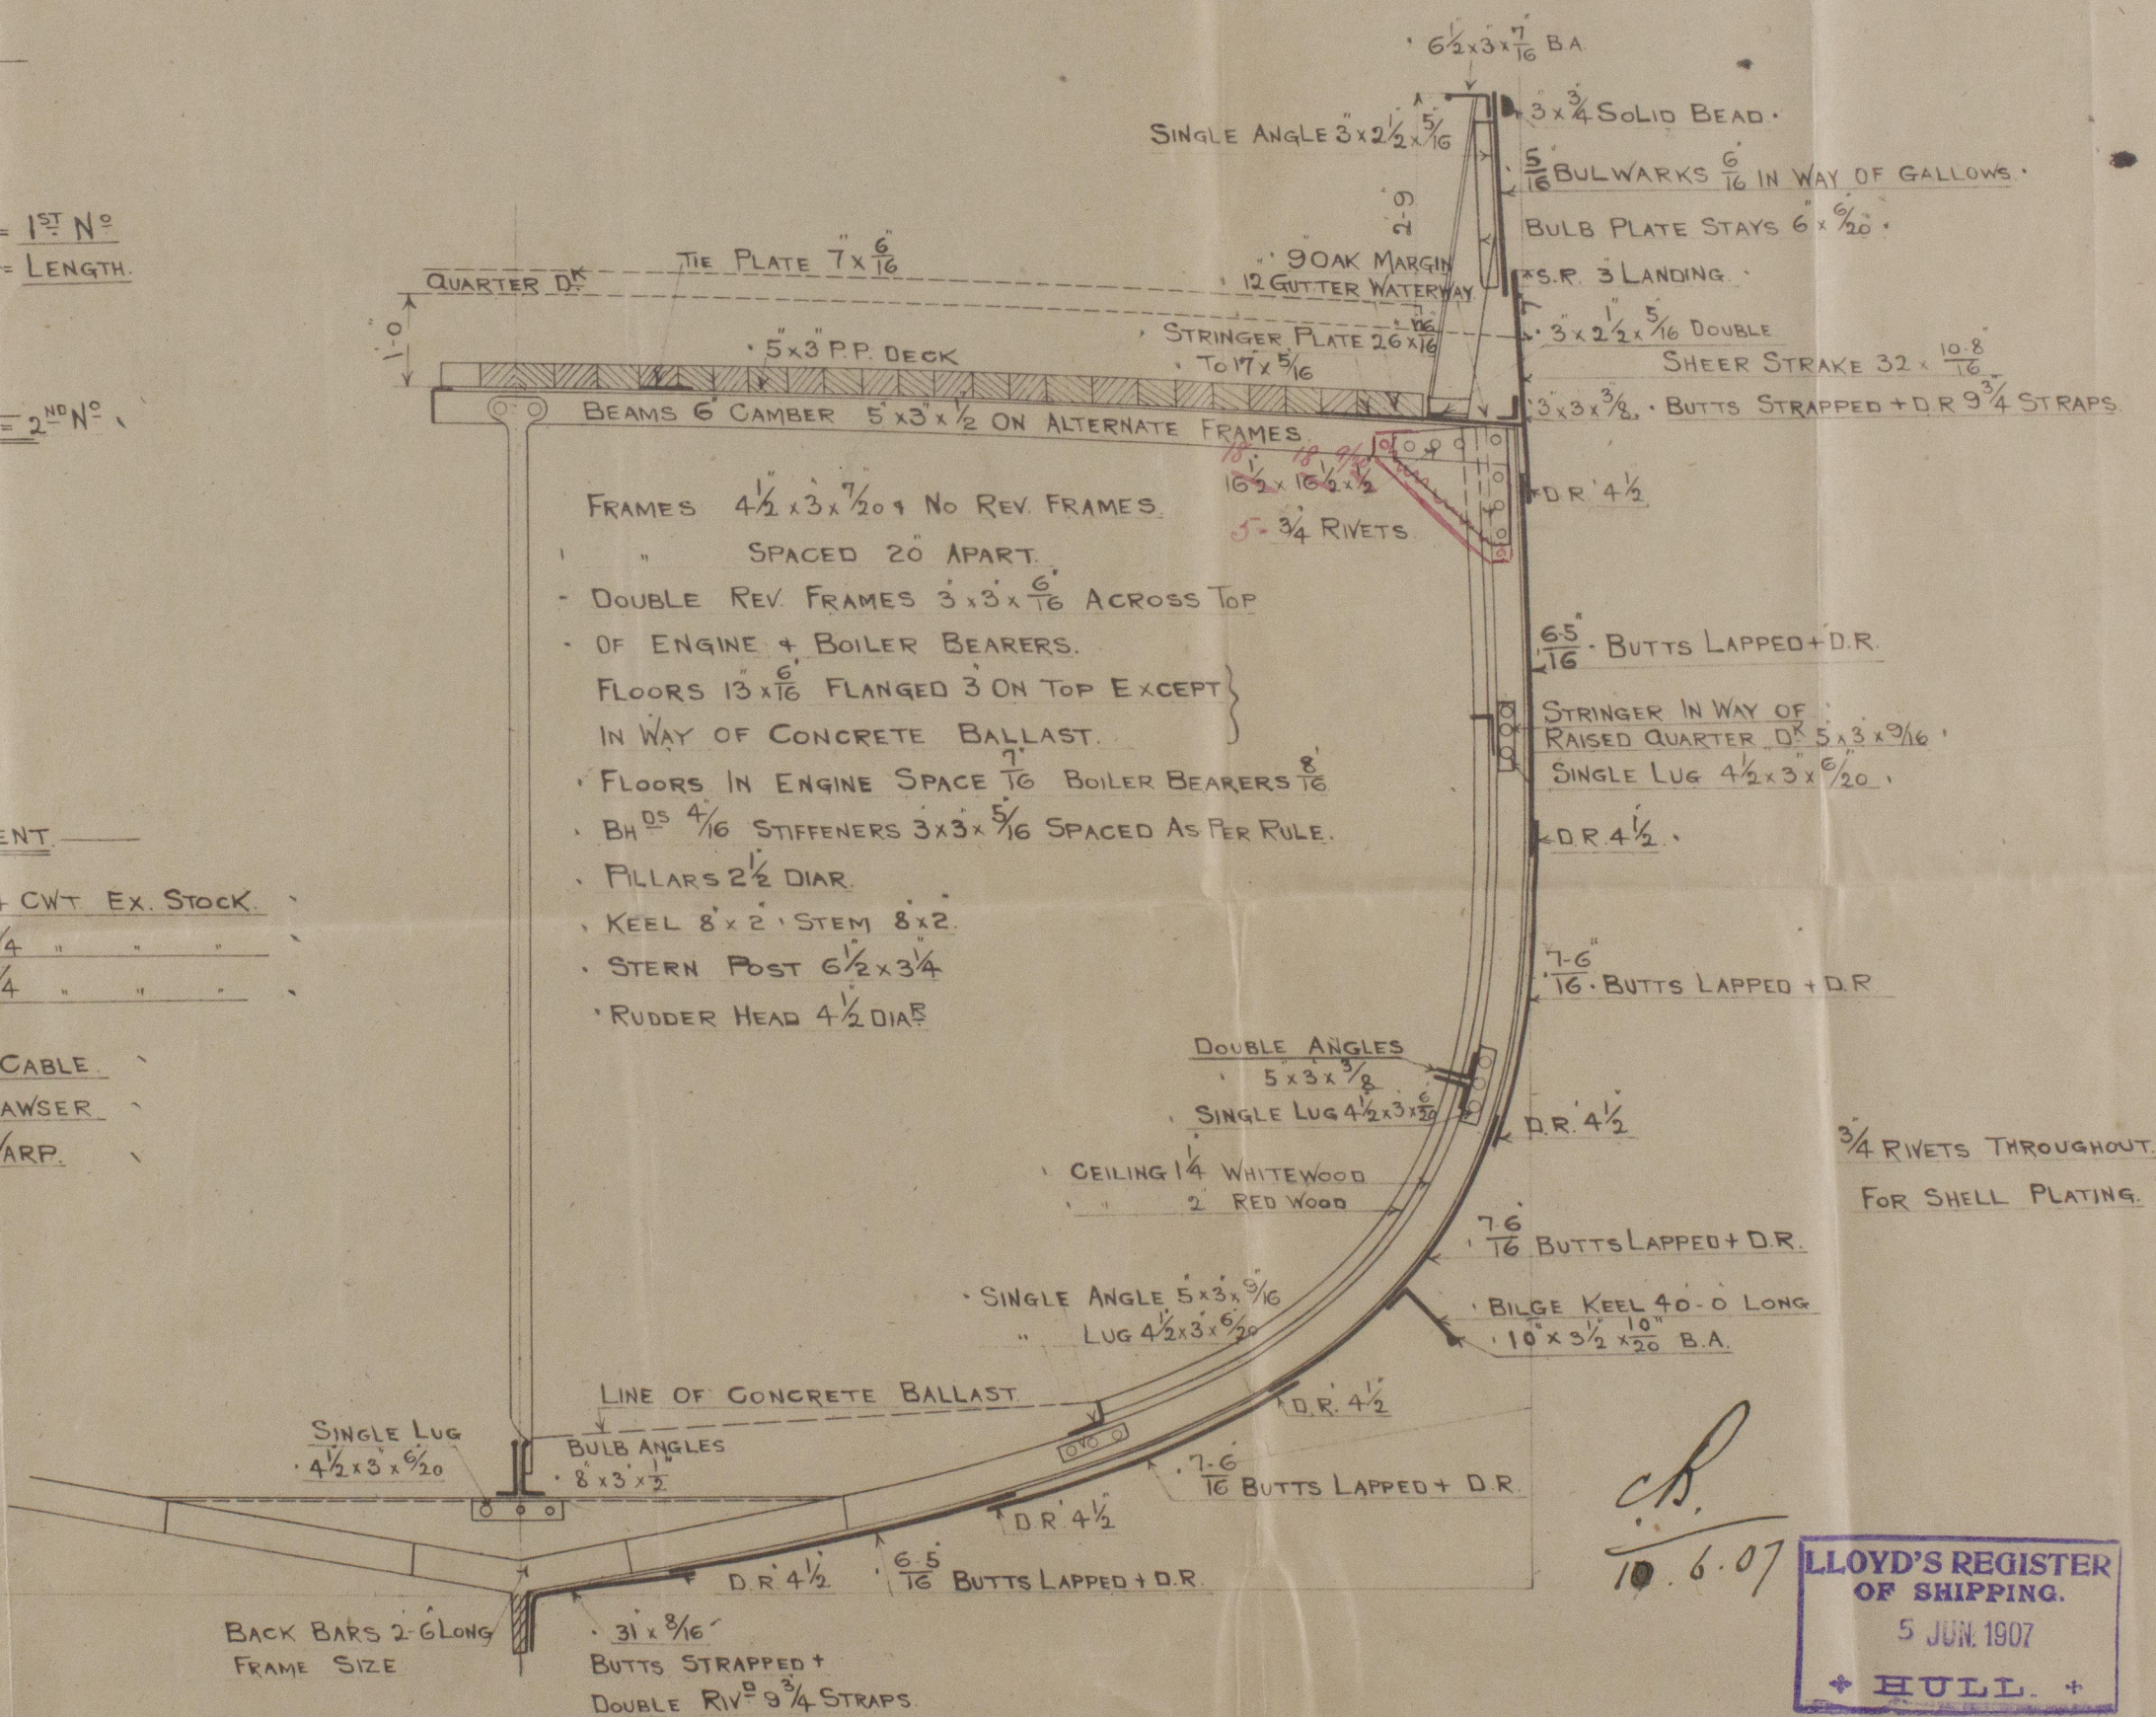


LLOYD'S REGISTER
 OF SHIPPING.
 5 JUN 1907
 + HULL +


- Midship Section

Earle's Co. Ltd
Hull

No. 539 + 540 -

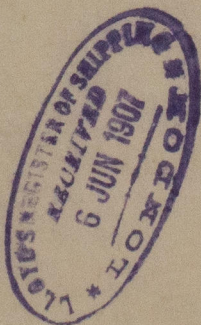

s/s "Botanic" Hull Rpt 2, 19630
"Coltman" " " " 19681

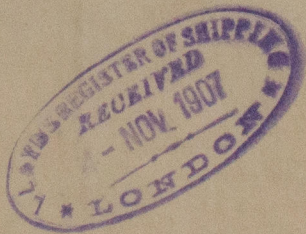

w949-0066

RETAIL

© 2020

Lloyd's Register
Foundation