


10.6.07.

• N^{os} 539-40

PROFILE & DECKPLAN

DIMENSIONS 141'8 B.P. x 22'10 M.L. x 13'0 M.D.

SCALE $\frac{1}{4}$ " = 1' "

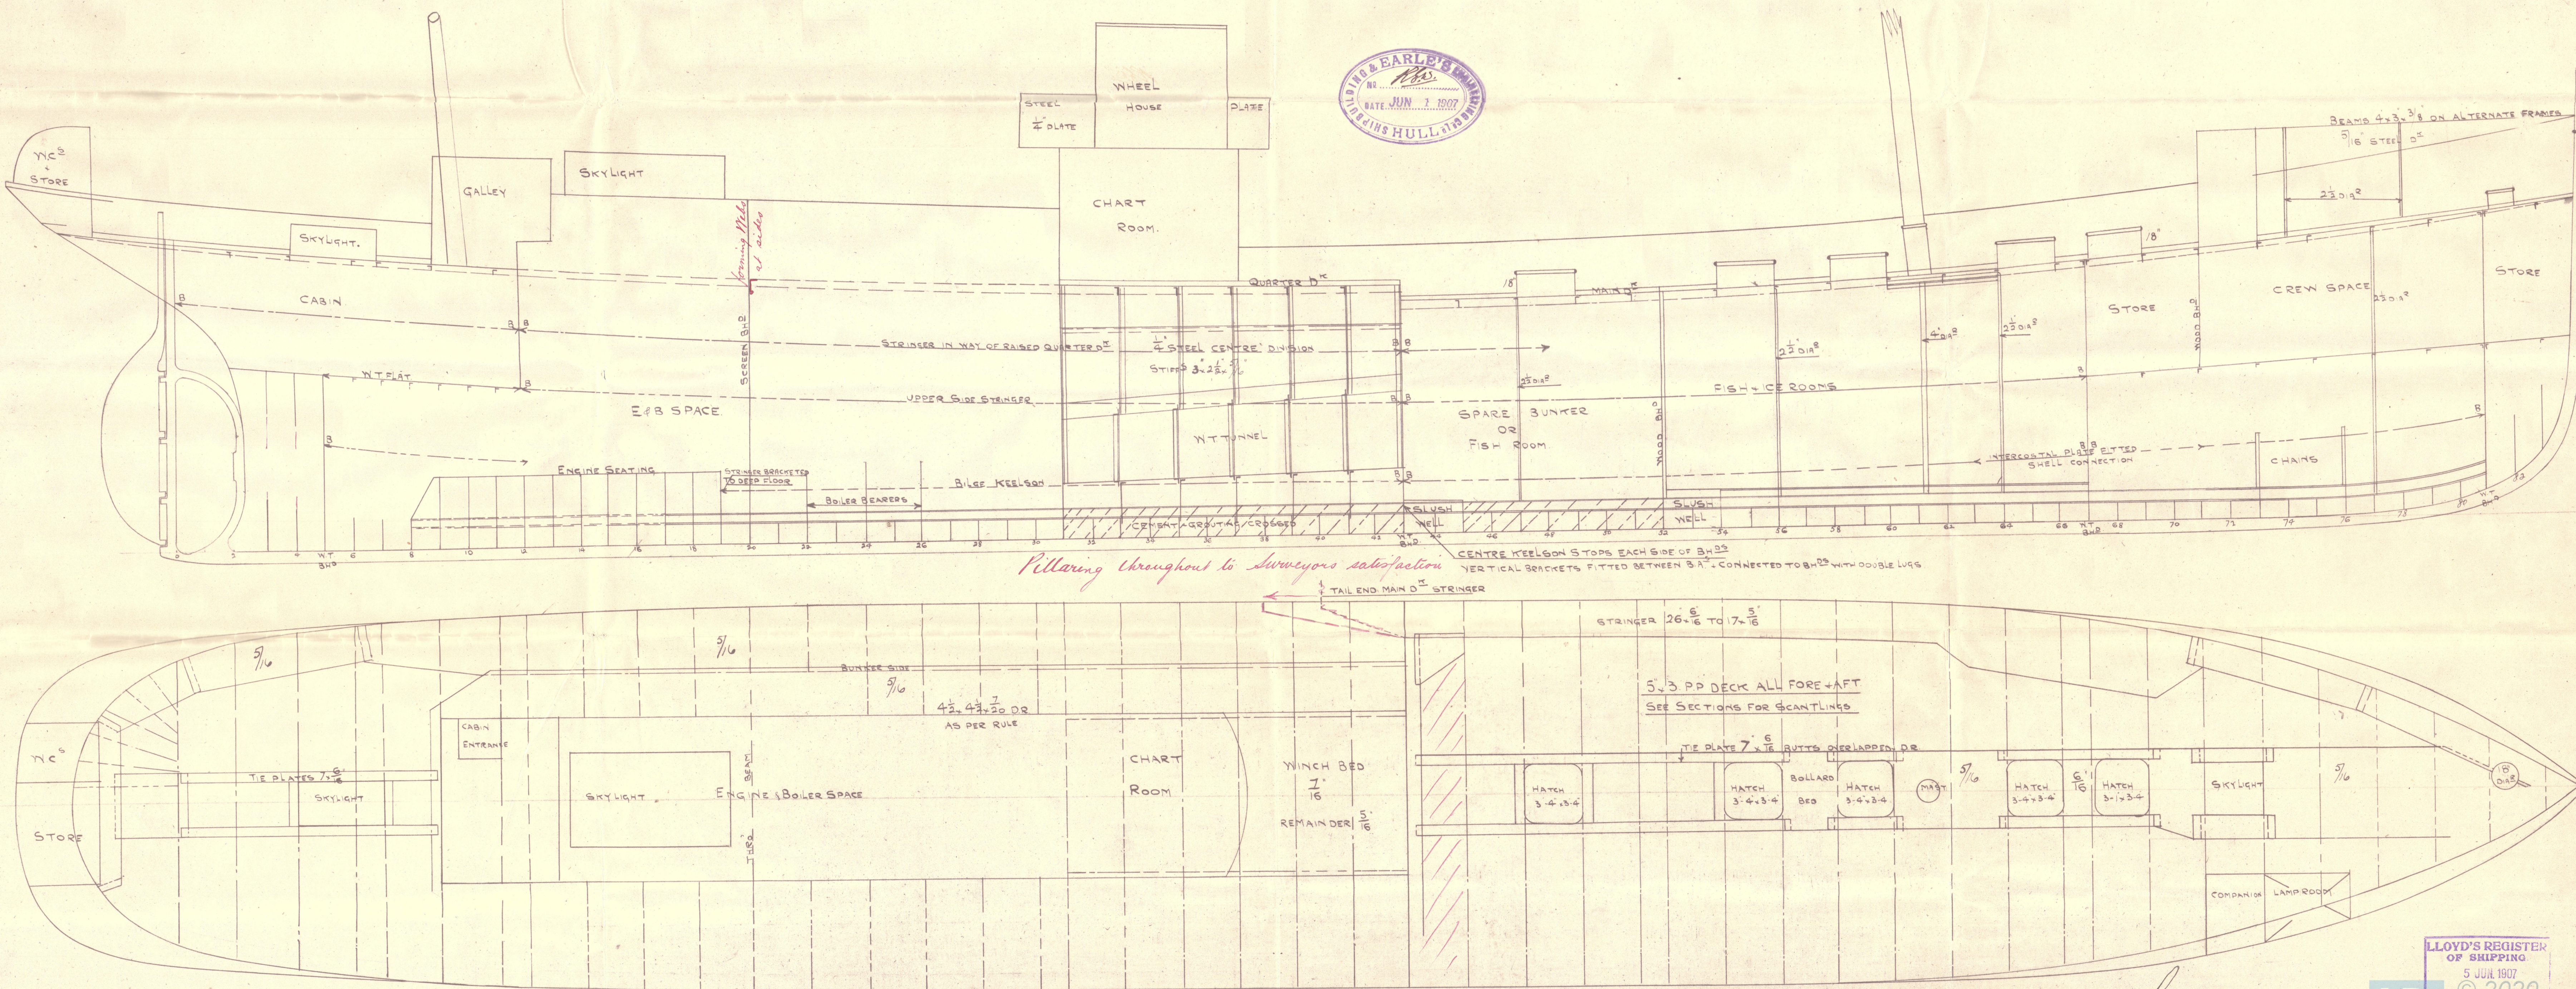

Pillaring throughout to Surveyors satisfaction

CENTRE KEELSON STOPS EACH SIDE OF BH²⁵
VERTICAL BRACKETS FITTED BETWEEN BA¹ + CONNECTED TO BH²⁵ WITH DOUBLE LUGS

TAIL END MAIN D¹² STRINGER

STRINGER 26' 6" TO 17' 5"

5' 3" PP DECK ALL FORE + AFT
SEE SECTIONS FOR SCANTLINGS

TIE PLATE 7' 6" BUTTS OVERLAPPED OR


C.B.
10.6.07.

Profile & Deck Plan —

Earle's Co. Ltd., Hull

— s/s No. 539 & 540 —

W949-0067

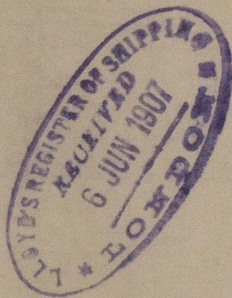

s/s Botanic Hull Rpt No. 19630
, Colman - - - 19681

RETAIN



© 2020

Lloyd's Register
Foundation