

MIDSHIP SECTION


TRIASTER

SCALE 1/2" = 1 FOOT.

DIMENSIONS :- 400'-0" B.P. (ON LWL) x 59'-3" EXT. x 38'-0" MLD. x 29'-0" MLD. TO SECOND DECK x 37'-0" MLD. TO UPPER DECK
TO CLASS 100 A.1 WITH FREEBOARD CORRESPONDING TO A LIMITED DRAFT OF 24'-6" SUMMER MOULDER AT LLOYD'S SPECIAL SURVEY

LLOYD'S NUMERALS

FIRST LONGITUDINAL NUMBER $L = D + 400.0 \times 55.54 = 14216$
SECOND LONGITUDINAL NUMBER $L \times (B + D) = 400.0 \times (59.0 + 37.0) = 37160$
PROPORTION 7D TO UPPER DECK $= 400.0 \times 37.0 = 10.81$
D TAKEN AT 27.42 (TO SUIT 24.6 MLD. DRAFT) $+ 6.0 = 33.42$
d (IN WAY OF FORE HOLDS) $= 37.0 - (B.0 + 4.5) = 24.54$
d (IN WAY OF ENGINE ROOM) $= 37.0 - (B.0 + 6.0) = 23.00$

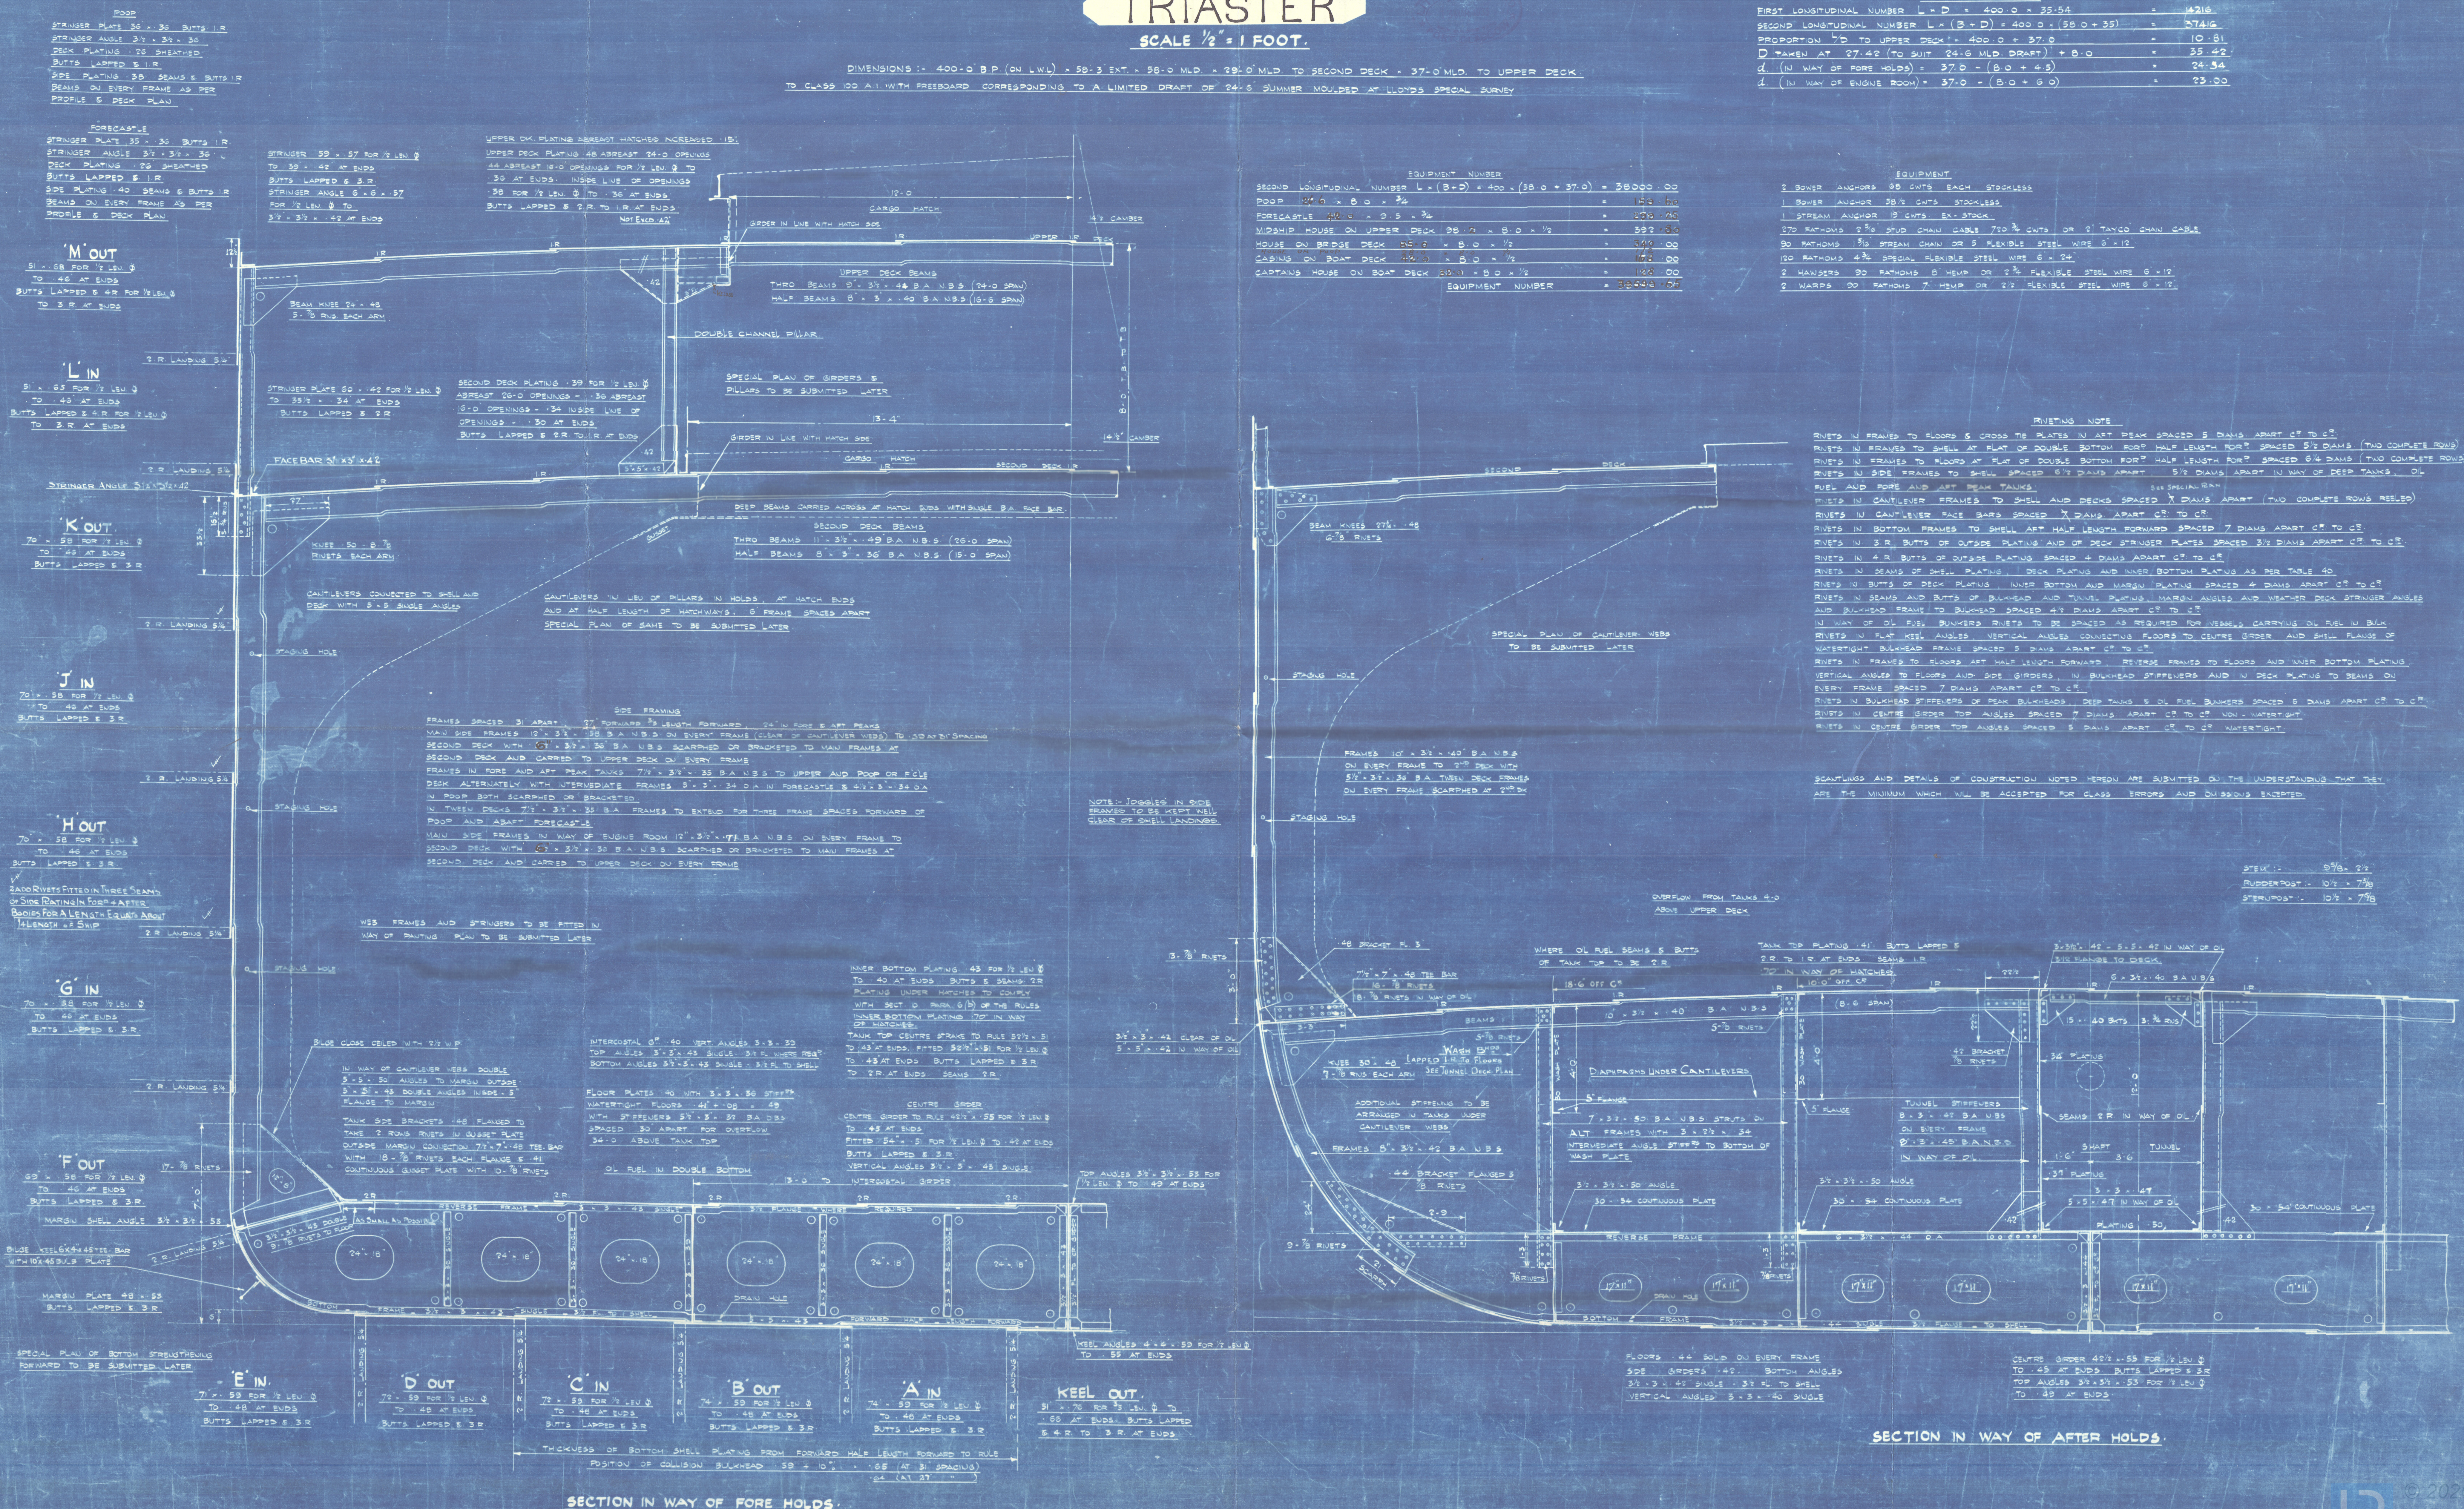

LITHGOWS LTD.

Nº 872.

M.V. "TRIASTER"

MIDSHIP SECTION.

(AS BUILT).

M.V. "Triaster"

Greenock List Entry Report Nº 19929.

W95-0075



© 2020

Lloyd's Register
Foundation