

<u>LLYDYS DIMENSIONS.</u>		
LENGTH FROM FORE SIDE OF STERN POST TO AFTER SIDE OF STEM		328.75
BREADTH MOULDED		46.75
DEPTH TO SKIN ASSUMING 12" ROUND UP OF BEAM		27.54
DEPTH TO LENGTH	11.93	11 TO 12.
BREADTH TO LENGTH	7.01	7 TO 8

MIDSHIP SECTION.


— DIMENSIONS. —
 LENGTH B.P. 330'-9", BREADTH EX. 47'-0", DEPTH M^d 26'-6".
 TO CLASS 100. A.1. AT LLOYDS "THREE DECK" RULE.

LLOYDS NUMERALS.

$\frac{1}{2}$ GIRTH -----	47.03
BREADTH -----	23.37.
DEPTH -----	27.54
	<u>97.94</u>
	7.00
	<u>90.94 = 1ST N^O GRADES 85 TO 91.</u>
	328.75.
	<u>298.96 = 2ND N^O GRADES 28700 TO 31200.</u>

UNDER DECK TONNAGE CO-EFFICIENT = .82.

EQUIPMENT N° _____
 1/2 GIRTH TO UPPER D^Y 47-03
 1/2 BREADTH 23-37
 DEPTH TO UPPER D^Y 27-54
 37-94
 328-75
 8 32197-77
 4024-72
 48
 1931-86
 32197-77
 ✓ EQUIP IN? 34129-63 GRADES 32820/35450 Letter V
 74 = .48
 75

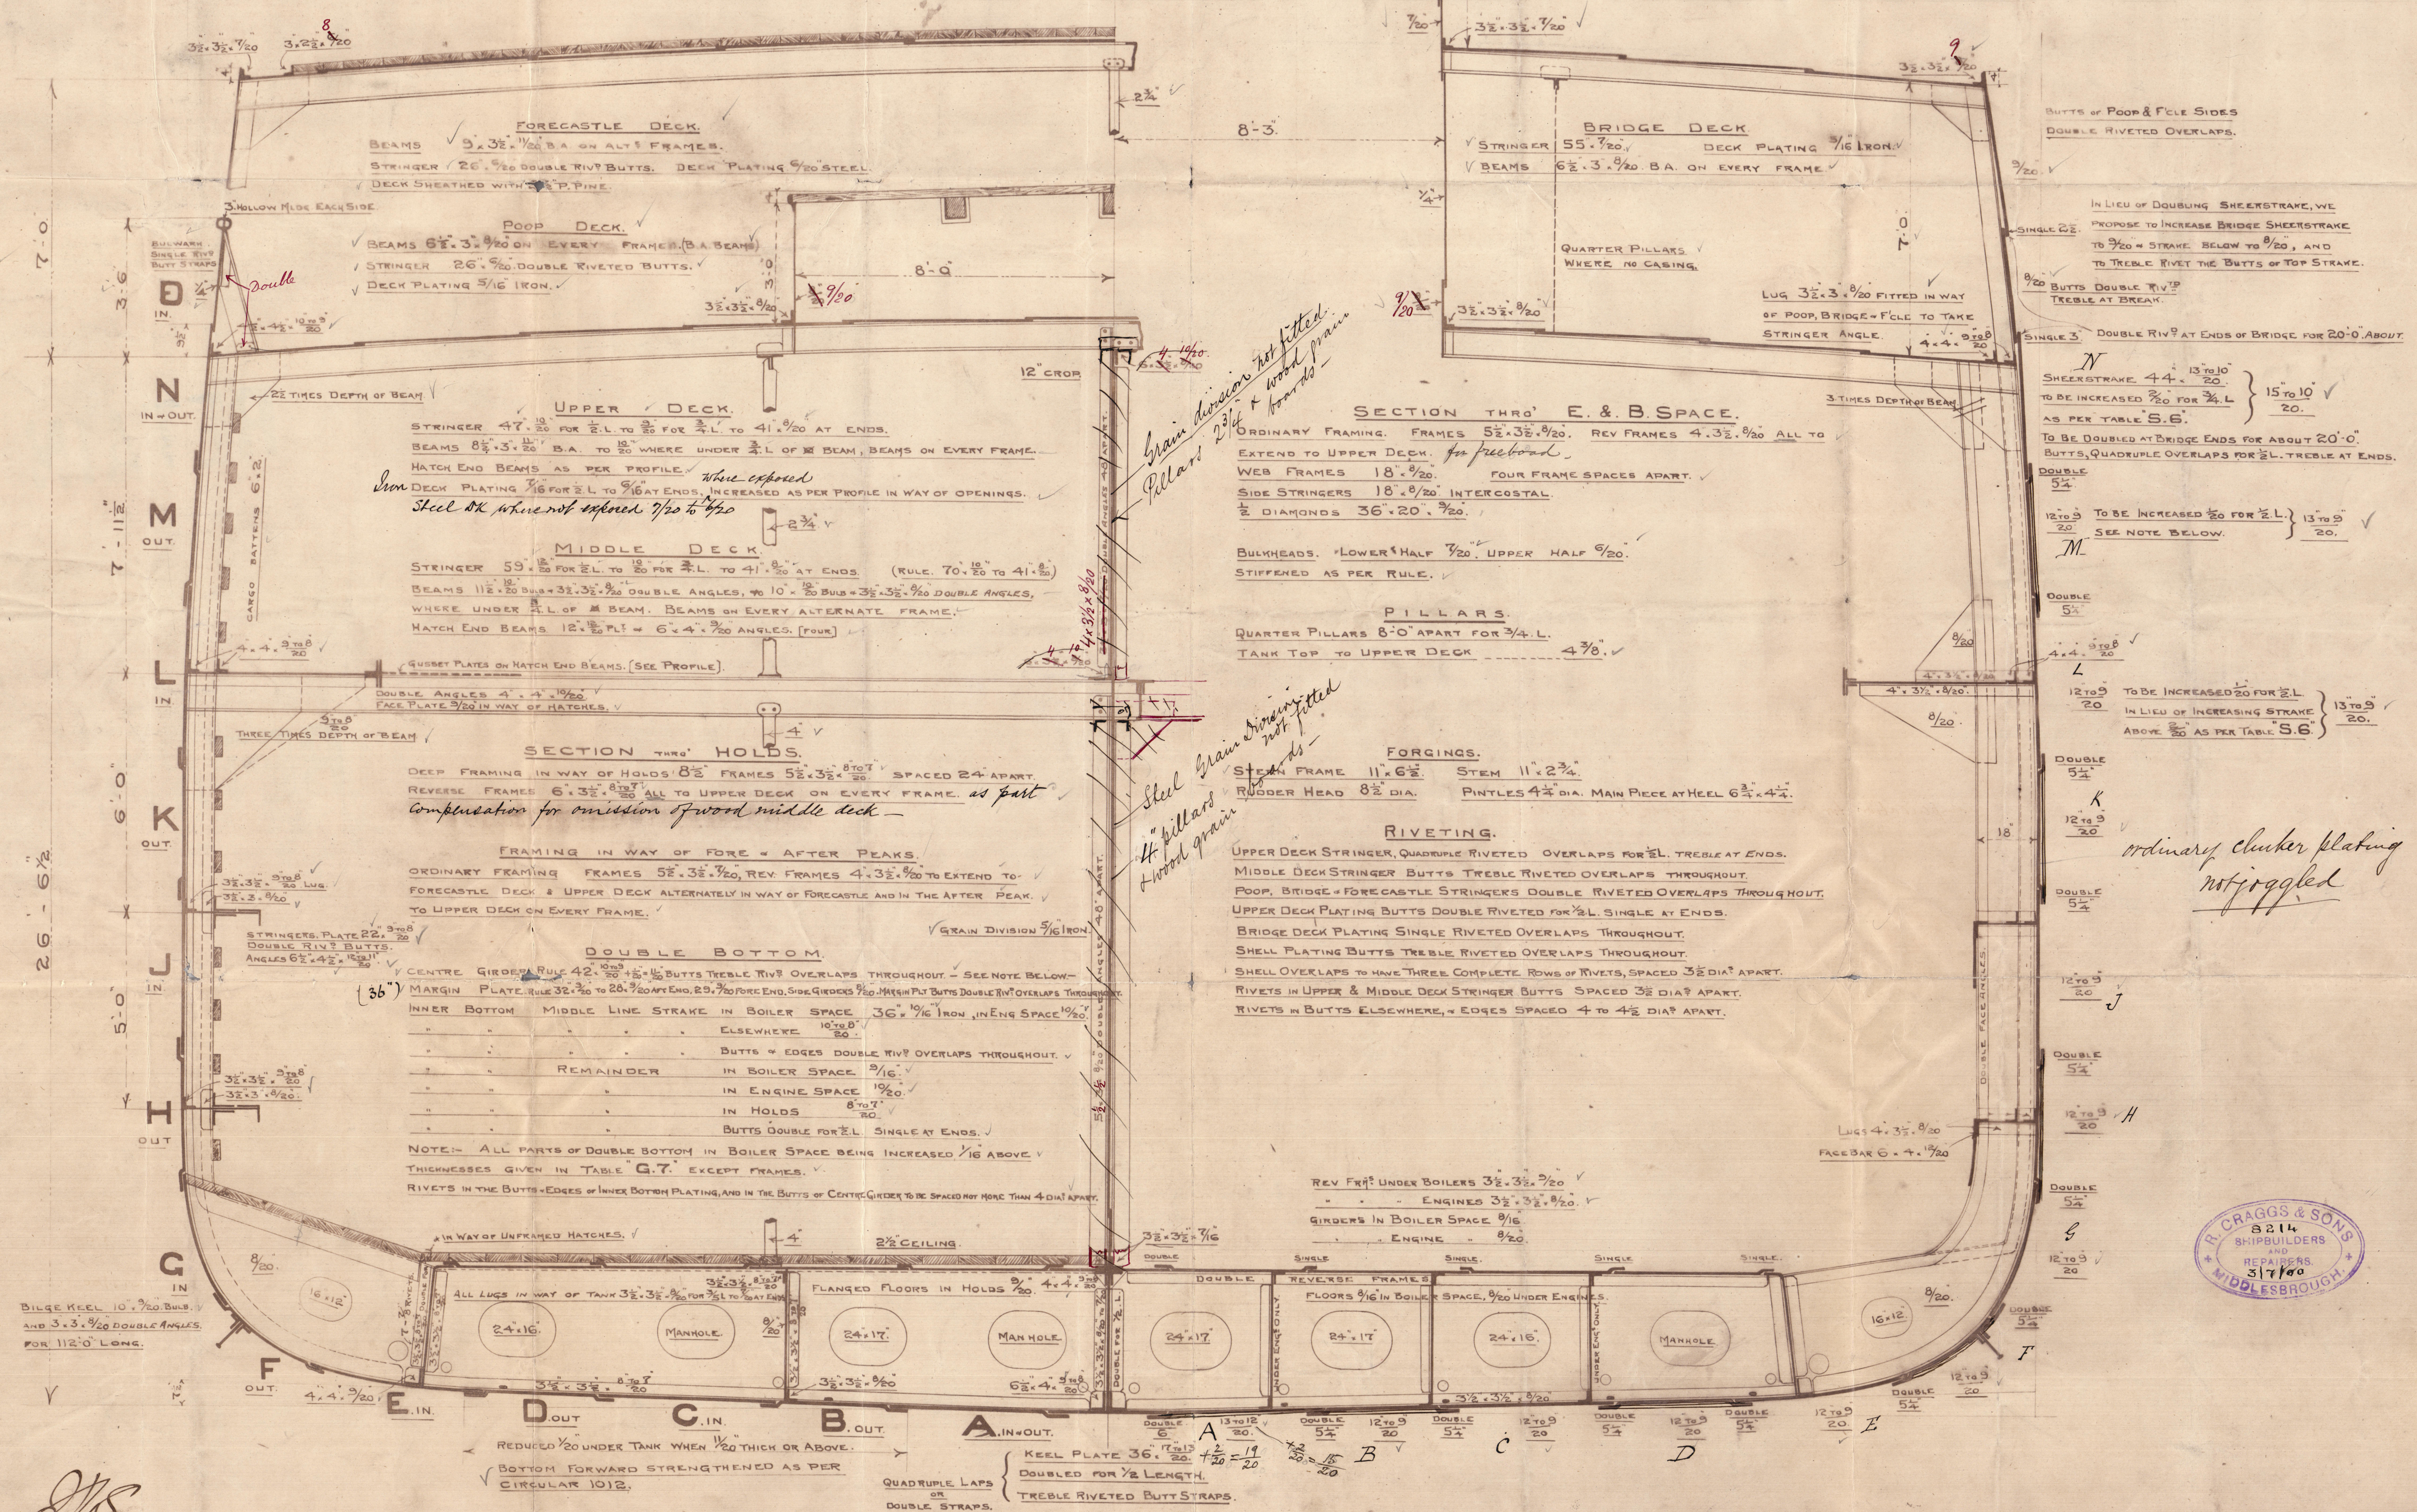

W. Craggs
R. CRAGGS & SONS.
TEES DOCKYARD
MIDDLESBROUGH - ON - TEES.

NOTE:- IN LIEU OF DOUBLING KEEL FOR $\frac{1}{2}$ L. WE PROPOSE TO INCREASE KEEL $\frac{3}{20}$ FOR $\frac{1}{2}$ L. GARBOARDS $\frac{3}{20}$ FOR $\frac{1}{2}$ L. AND CENTRE GIRDER $\frac{1}{20}$ FOR $\frac{1}{2}$ L.

N^o 167.


© 2020
Lloyd's Register
Foundation

L. Bragg & Sons

Nº 164

Midship Section

RETAIN

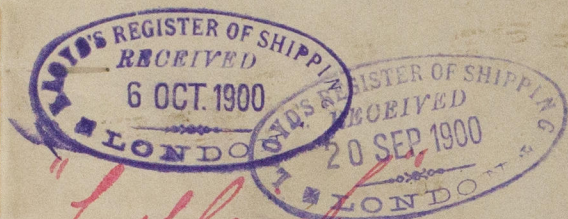

Lustleigh



Indb. Report Nº 3109

RETAIN



© 2020

Lloyd's Register
Foundation
W 950 - 0136