


SCALE 1 IN. = 1 FOOT



THOMAS RICHARDSON & SONS, Limited				
NO. OF DRAWING	..	..	B 1114	
NO. OF TRACING	..	..	11452	
WHERE SENT	..	..	Lloyds	
EXAMINED BY	..	..	J.B.R.	
DATE	..	..	18th July 1901	

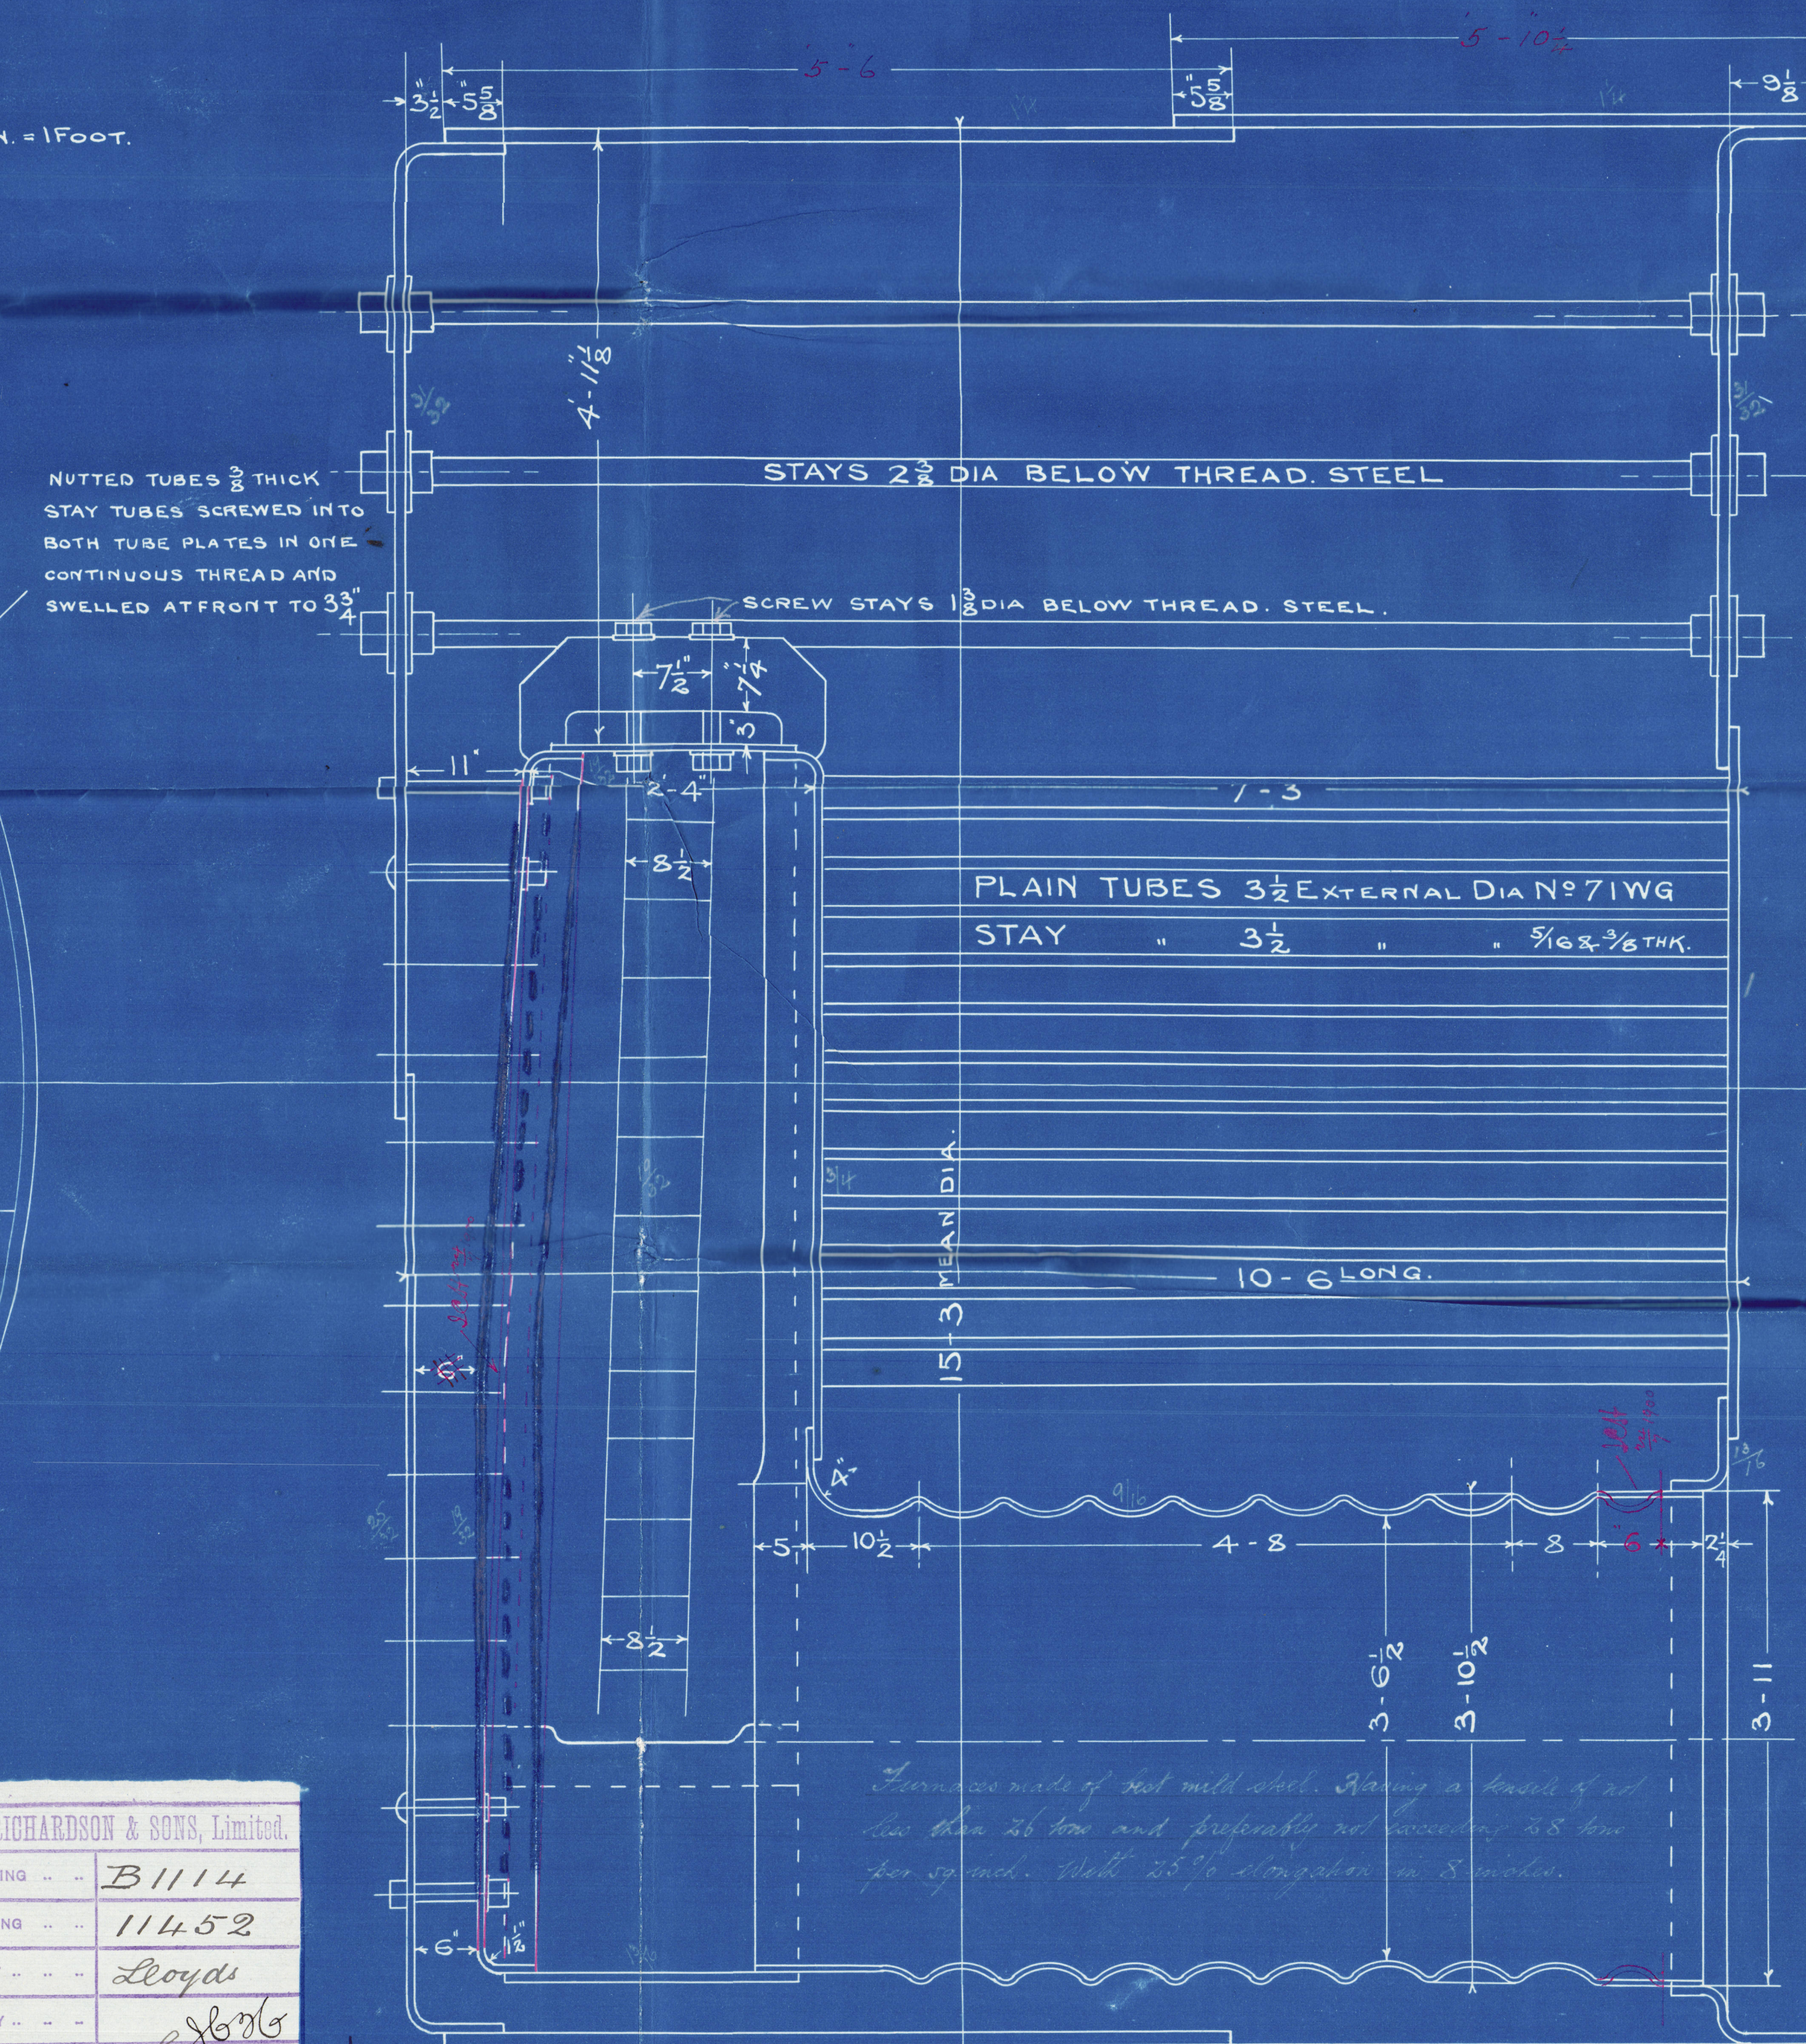

Main Boilers.

P. Craggs & Son  
No. 164 Vessel

Richardson No. 1114  
180 lbs

"Kusthigh"

~~Hpl No. 11519~~  
~~3109.~~



No. 2496  
Lloyd's List  
360 lbs  
W.J.S. 24.2.01

RETAIN



© 2020

Lloyd's Register  
Foundation

W950-0137