

17-7-00
21.9.00

PROFILE, DECK & STRINGER PLANS OF STEEL SCREW STEAMER

DIMENSIONS 330'-9" x 47'-0" EX. x 26'-6 1/2" MLD.

$\frac{1}{8}$ " SCALE

96-0✓

STRINGER 55' x $\frac{1}{20}$ BUTTS DOUBLE RIVETED

ENGINEERS HOUSES

DECK PLATING, $\frac{5}{16}$ IRON ✓

CABINS

UNDER DK. CO-EFF 82

BRIDGE DECK

FORECASTLE DK

NOTE: - ~~IN LIEU OF FITTING WEDGES TO BRIDS AS REQUIRED BY NOTE~~
~~WE PROPOSE INCREASING GRAIN DIVISION FOR 4" NEEL BRD $\frac{1}{16}$ " IN THICKNESS~~
~~DETAILS OF STRENGTHENING TO BE SUBMITTED~~
NEEL TRAIL DIVISION WAS NOT FITTED

[illegible]

BOTTOM STRENGTHENED FORWARD
AS PER CIRCULAR 1012.


R. CRAGGS & SONS
SHIPBUILDERS & REPAIRERS
TEES DOCKYARD
MIDDLESBRO'

LLOYD'S REGISTER OF
ROYAL EXCHANGE
14-7-00
MIDDLESBOUGH-ON-TEES
SHIPPING

MIDDLE DECK

N⁰ 167 © 2020

Lloyd's Register
Foundation


R. Craggs Sons

No 164

Profile & decks




Luckleigh

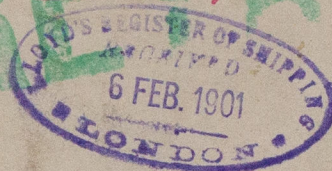

Mdb. Report No 3109

RETAIN

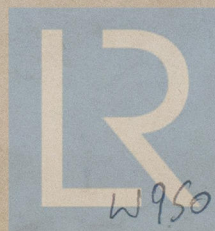

© 2020

Lloyd's Register
Foundation

W950-0138