



OUTSIDE VIEW OF PLATE
SCALE = 1/2" = 1 FOOT.

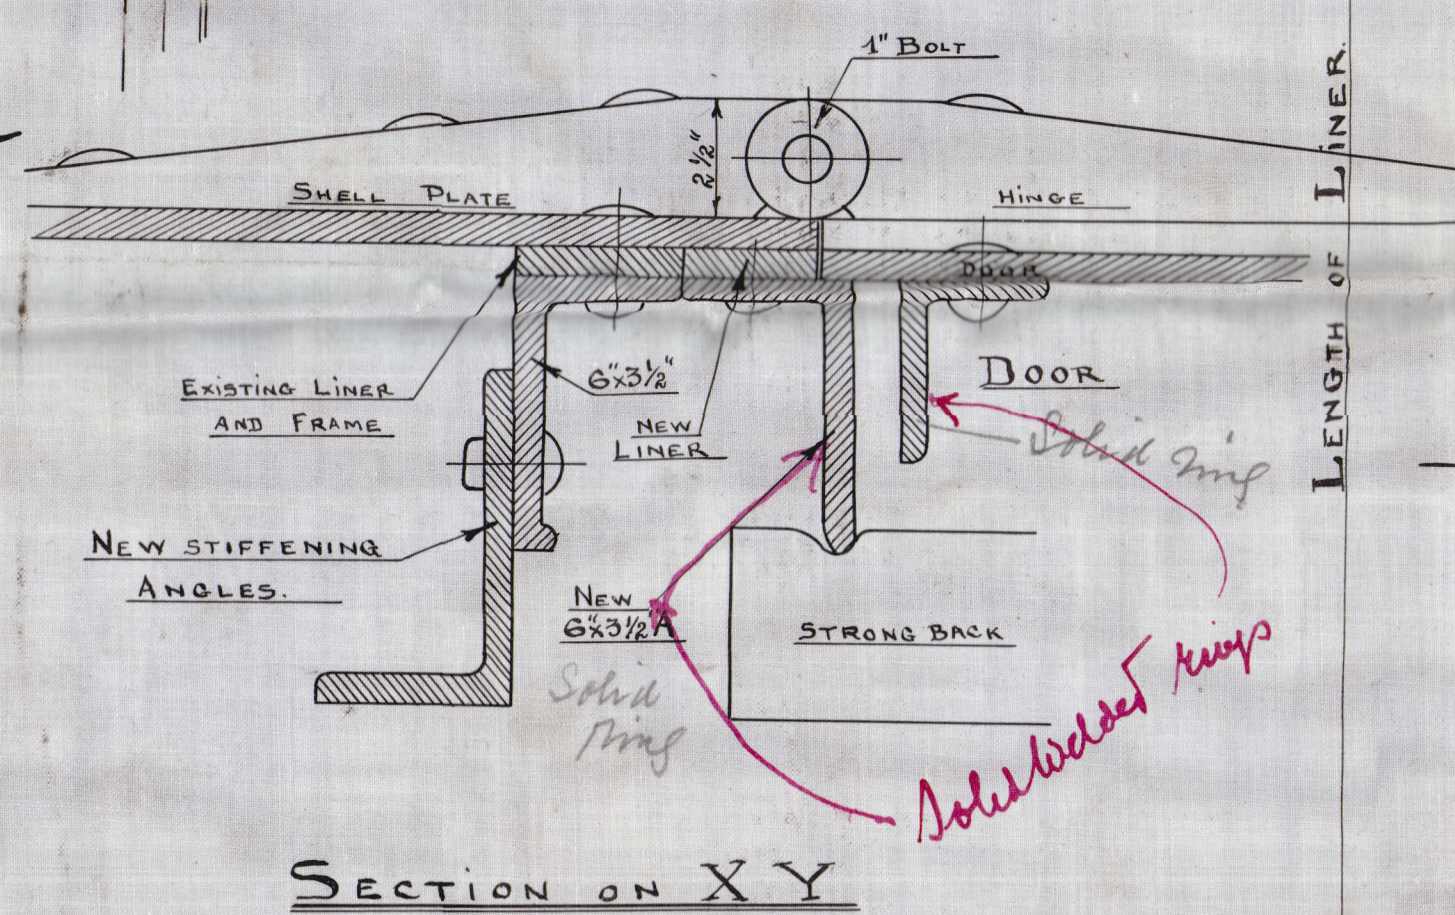


SECTION ON X-Y

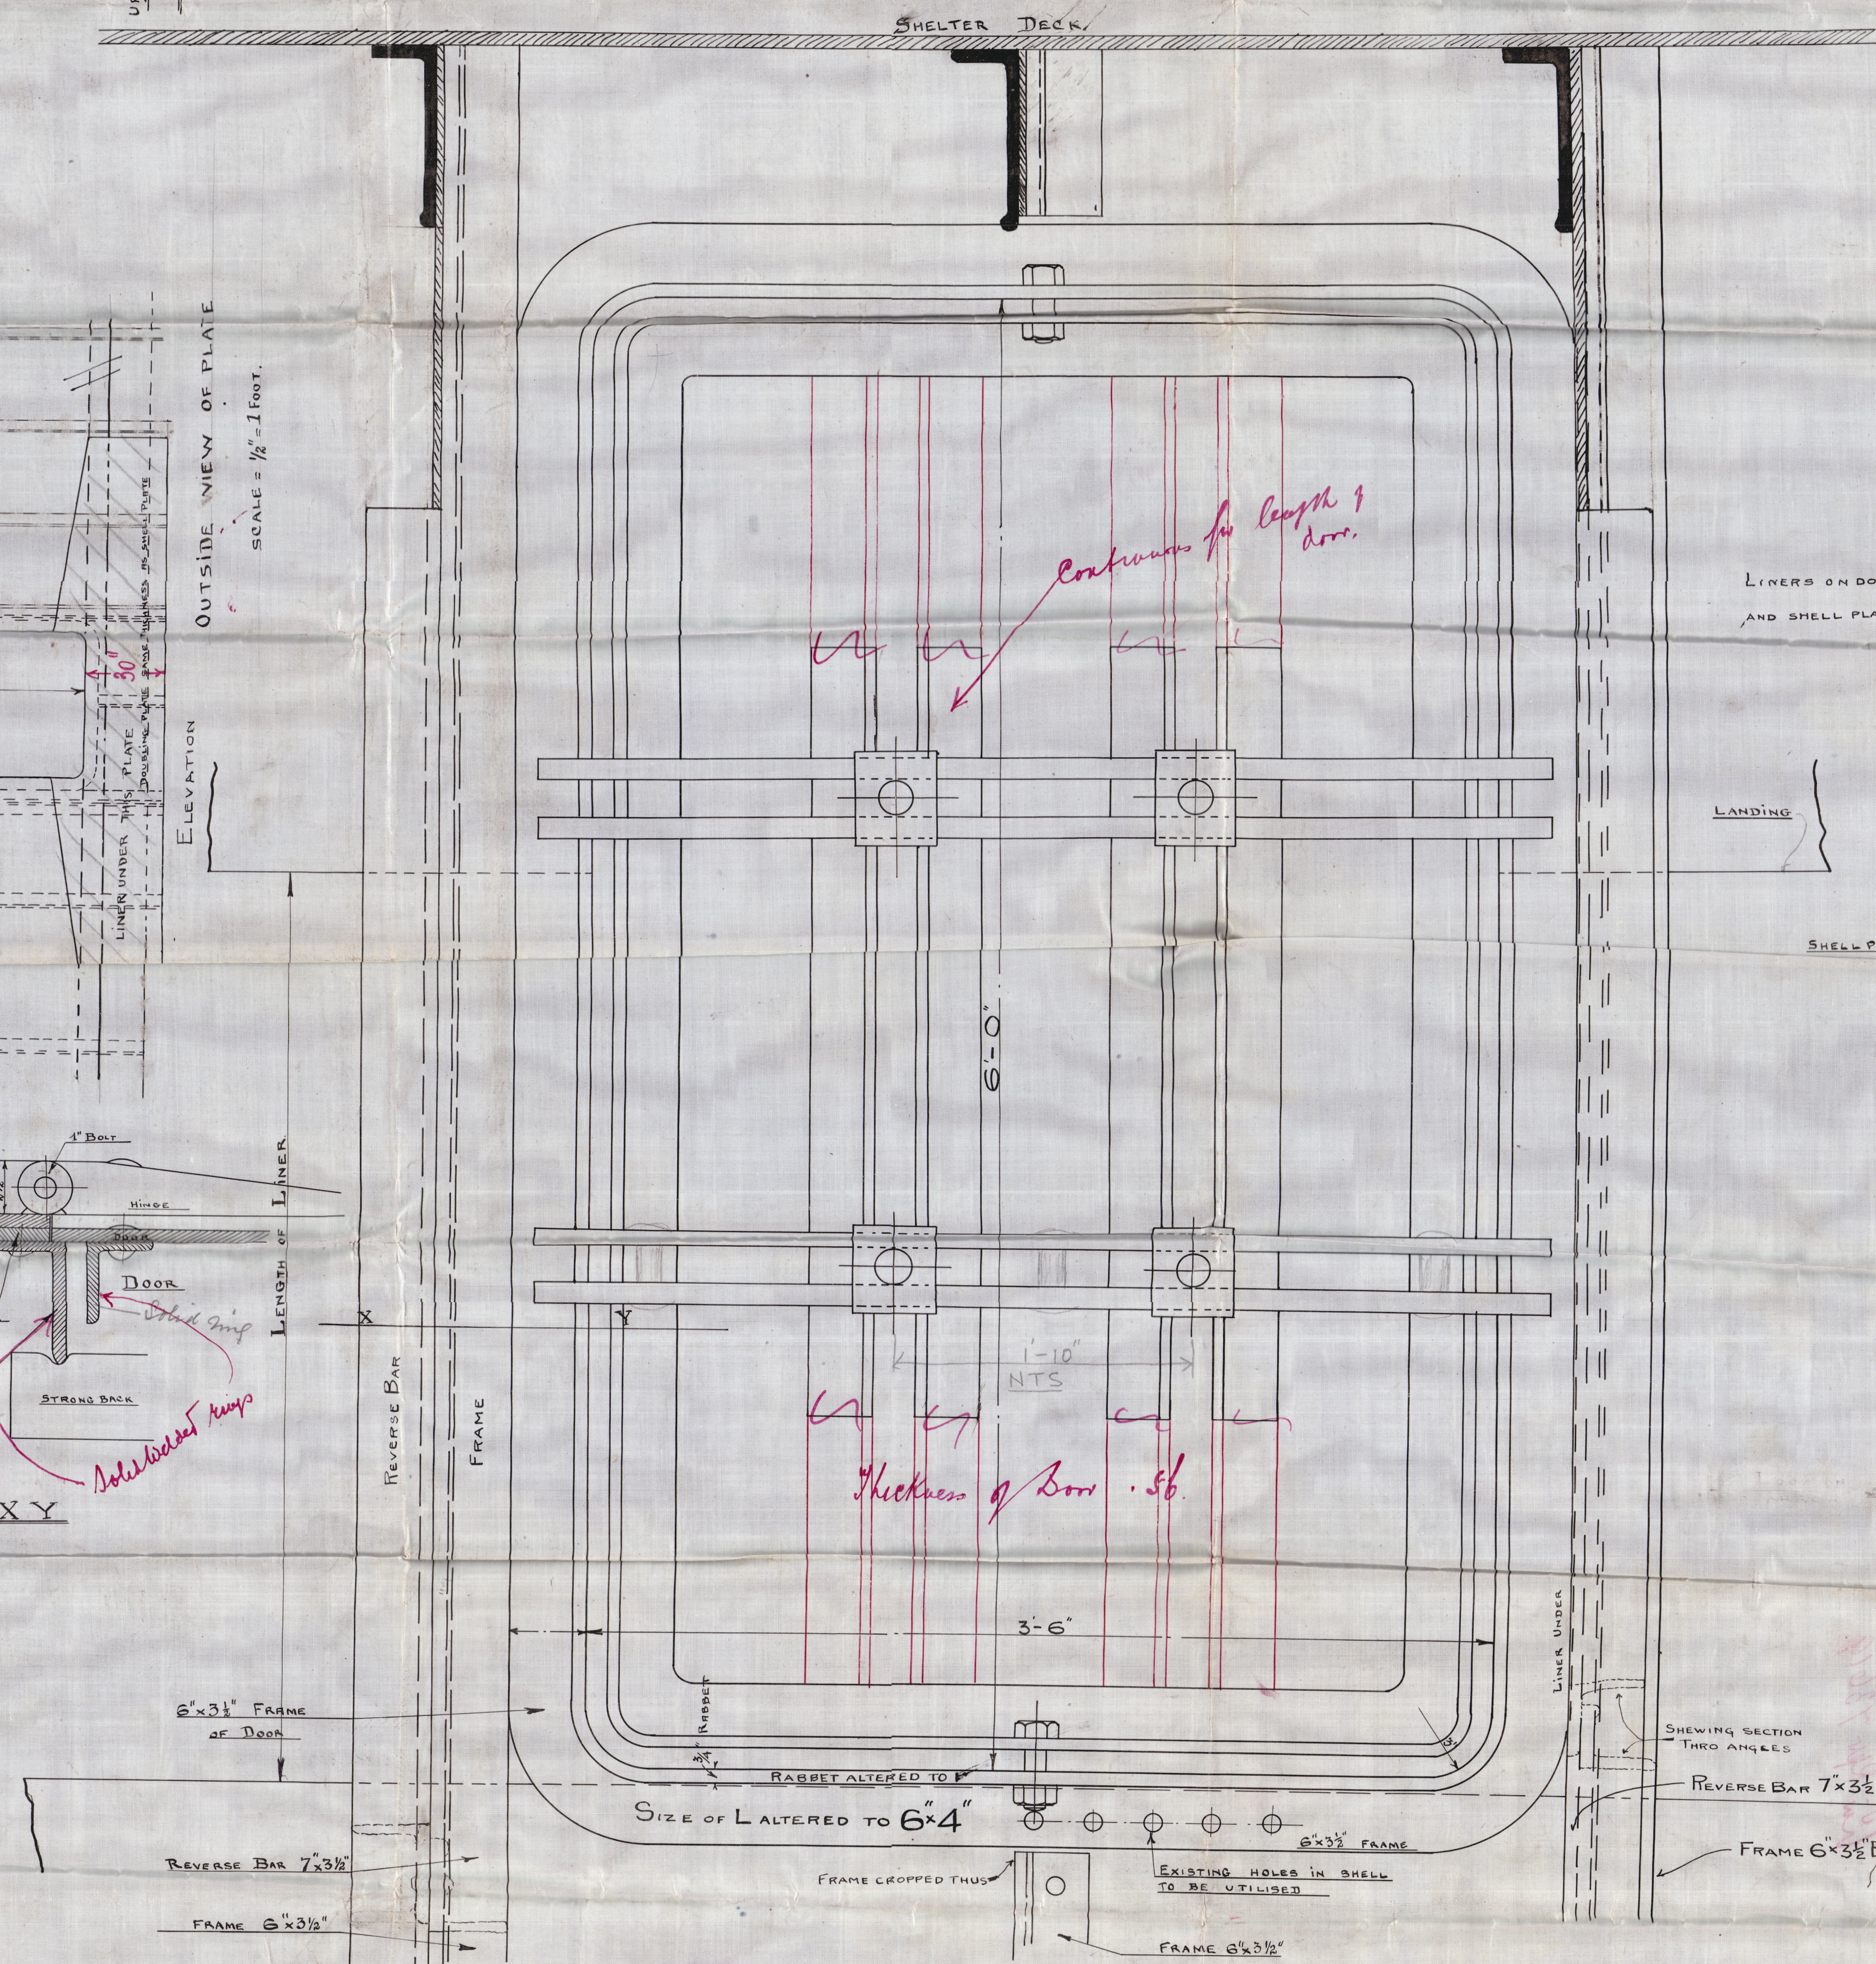

LINERS ON DOOR
AND SHELL PLATE

LANDING

SHELL PLATE

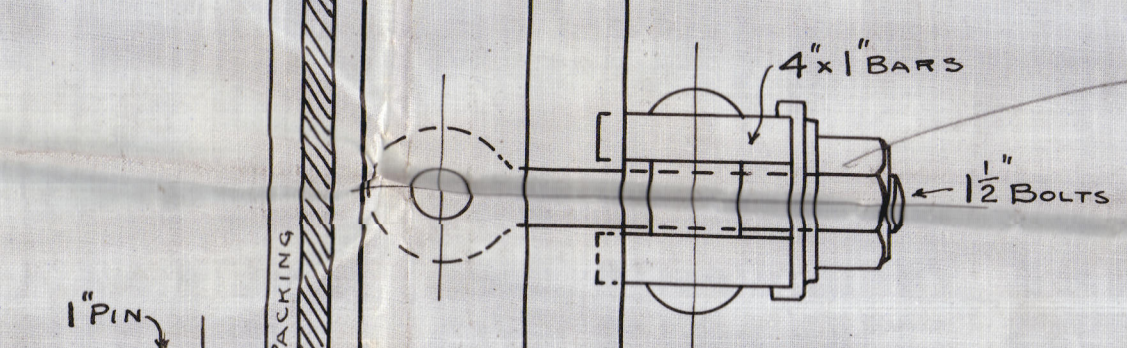

3 off thus

SHOWING SECTION
THRO ANGLES

REVERSE BAR 7x3 1/2"

FRAME 6x3 1/2" BA



SS. BAY STATE.
CATTLE PORT
SCALE = 3" = 1 FOOT.

fw
20.7.15

S. S. Bay State.

Rev Rpt 73619.



© 2021

W951-0008

Lloyd's Register
Foundation