

1-6-16
19.4.16
(1022) 21.8.16

No 1022 PROFILE & DECK PLANS


DIMENSIONS 285 PP x 40.0' EX x 27.4' MD to SHELTER D^o

TO CLASS 100 A1 AT LLOYDS

SCALE 1/8" = 1' FOOT

LONG. NO. 17239/65 TRANS. NO. 60-49

UNDER D^o TONNAGE (TO UPPER D^o) 1575.

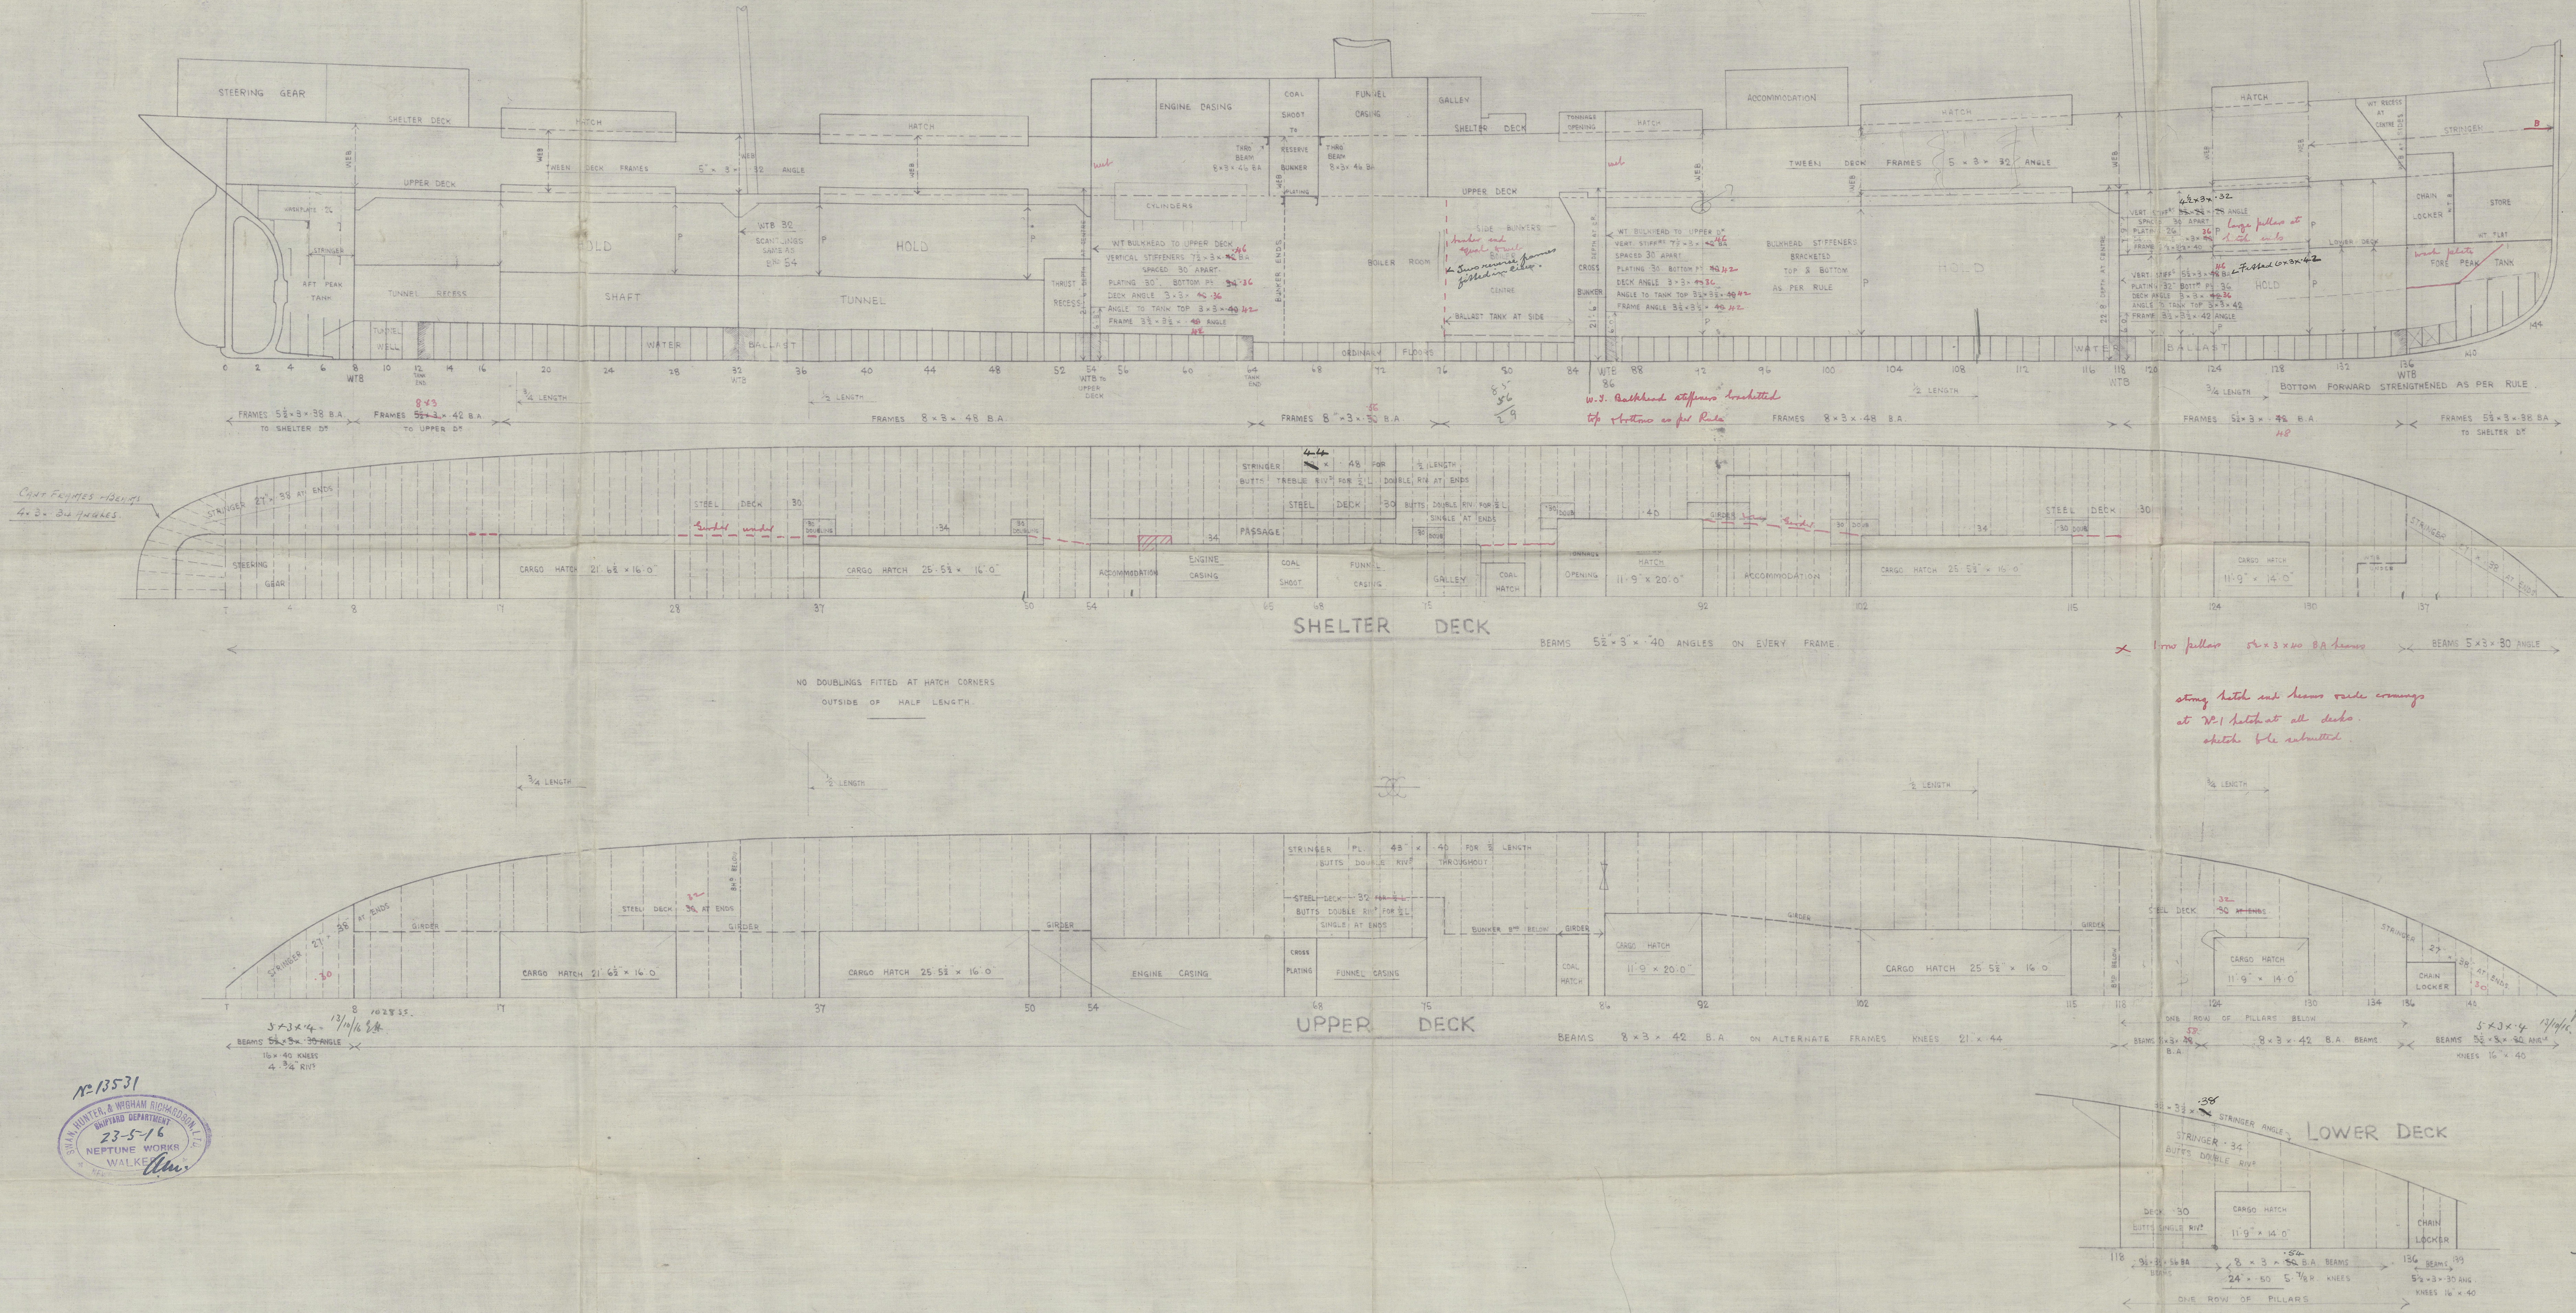

THE FOLLOWING PLANS
WILL BE
SUBMITTED —
PEAK BULKHEADS ✓
PILARS & GIRDERS ✓
HATCHWAYS ✓
PAINTING ARRANGEMENTS ✓
strengthening further forward

bb
1.6.16

17235/31
SHEPHERD & WILKINSON
23-5-16
NEPTUNE WORKS
WALTON

(4)

Swan Hunter.

Wigham. Richardson L^d.

No 1022. 1028

(approved.)
Profile & decks.

S.S. CLANGULA
NEWCASTLE ON TYNE.


Report No. 70362



S.S. DAFILA

NEWCASTLE ON TYNE.

Report No. 69315

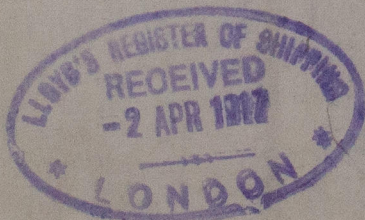

RETAIN



© 2020

Lloyd's Register
Foundation

W952-0062