
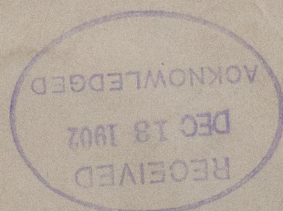


SCALE 1" = ONE FOOT.

SECTION THRO' MANHOLE
Mc NEILS DOOR.

W 953-0097
Newcastle on Tyne
R^t Stephenson & Co
Boiler No 470
Men Furness Withy & Co
L.S. No 267
"elay cracked"
Hpl. Report No. 12166

No 6540
Lloyd's List
2004.
S H H
26-3-03.

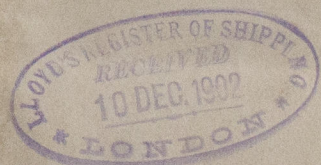

RETAIN



© 2020

Lloyd's Register
Foundation