



1871
 1872
SCALE $\frac{1}{8}'' = 1 \text{ FOOT}$

Nos 287-8-9.

53 - 3 1/2" LENGTH - 13/20 "1/20 IN WAY OF BRIDGE

FOR S E L L N G - 20. 20th MAY 1964.

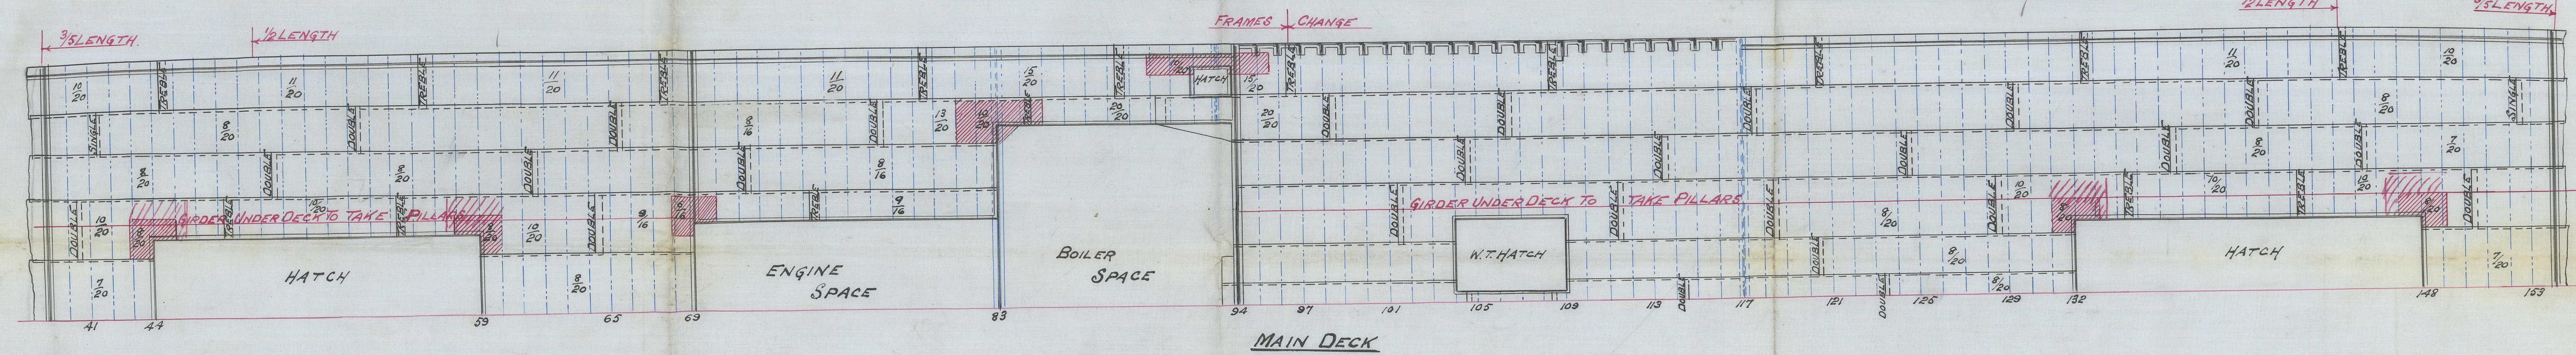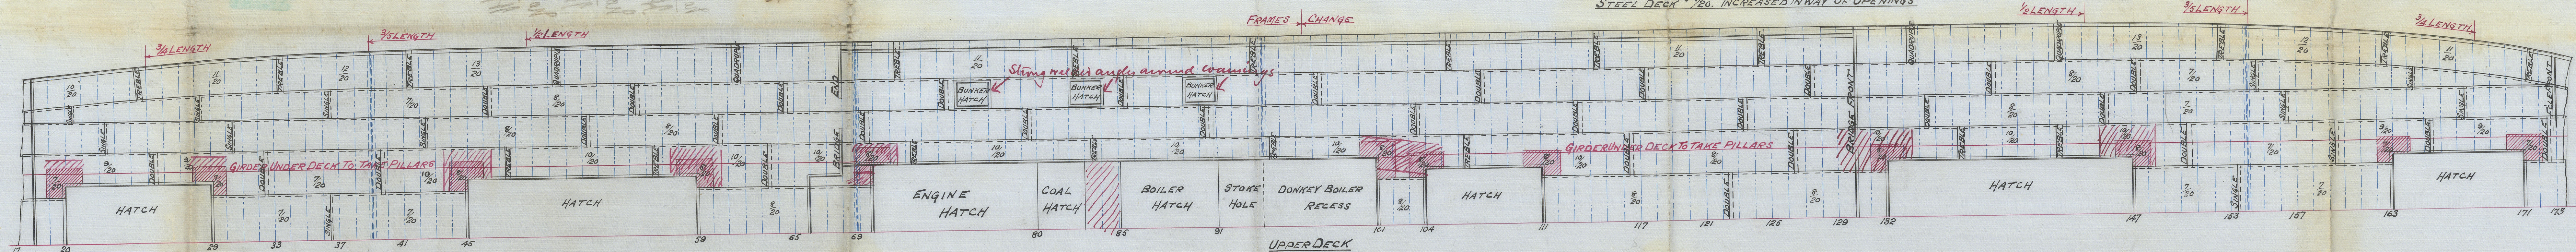

STEEL DECK $\frac{3}{16}$ INCREASED IN WAY OF OPENINGS

J.V.L.
9/6/05



FURNESS, WITHEY & CO., LIMITED
SHIPBUILDERS & REPAIRERS,
WEST HARTLEPOOL.

June 6/05

© 2020

Lloyd's Register
W953 0118

Deck Plan.

Turness, Wm. T. & Co.

Nos. 287, 288 & 289

no. 287 - "Plan Macpherson"

Hpl. Report no. 12776

no. 288 - "Plan Macintosh"

Hpl. Report no. 12815

no. 289 - "Plan Macintosh"

Hpl. Report no. 12864

W953-0118



© 2020

Lloyd's Register
Foundation