

W953-0183

Northumberland S. Co. Ltd


SS 245

Profile & Deck plans as built
showing WT bulkheads in
Shell & Tween Decks

S.S. "CLAN MACVEY"

NEWCASTLE ON TYNE.

Report No. 71144

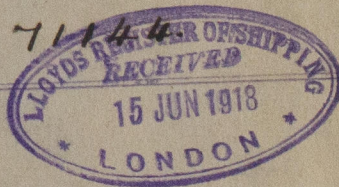

RETAIN



© 2020

Lloyd's Register
Foundation