



12.11.06

MIDSHIP SECTION

STEEL SCREW TRAWLER

LENGTH 128'-6" x BREADTH 22'-0" x 12'-6" DEPTH MOULDED.

SCALE 1/2" = ONE FOOT.

Nº 391.

TO CLASS 100-A-1. AT LLOYDS FOR FISHING PURPOSES
ENGINE & BOILER CASING AS PREVIOUSLY APPROVED.

DECK PLATED IN WAY OF E & B CASING

LLOYDS NUMBERS


1/2" GIRTH	19.91
1/2" BREADTH	10.95
DEPTH	12.95
	43.81 1ST NO
	RULE LENGTH 127.29
	5576.5749 2ND NO

PROPORTIONS

DEPTH TO LENGTH	9.783
BREADTH " "	5.8

EQUIPMENT

1ST BOWER	5 1/2 CWTs	EX STOCK
2ND " "	5	" " "
3RD " "	2 3/4	" " "
105 FATH	1 1/6	CABLE
60 "	6	HAWSER
60 "	4 1/2	WARP

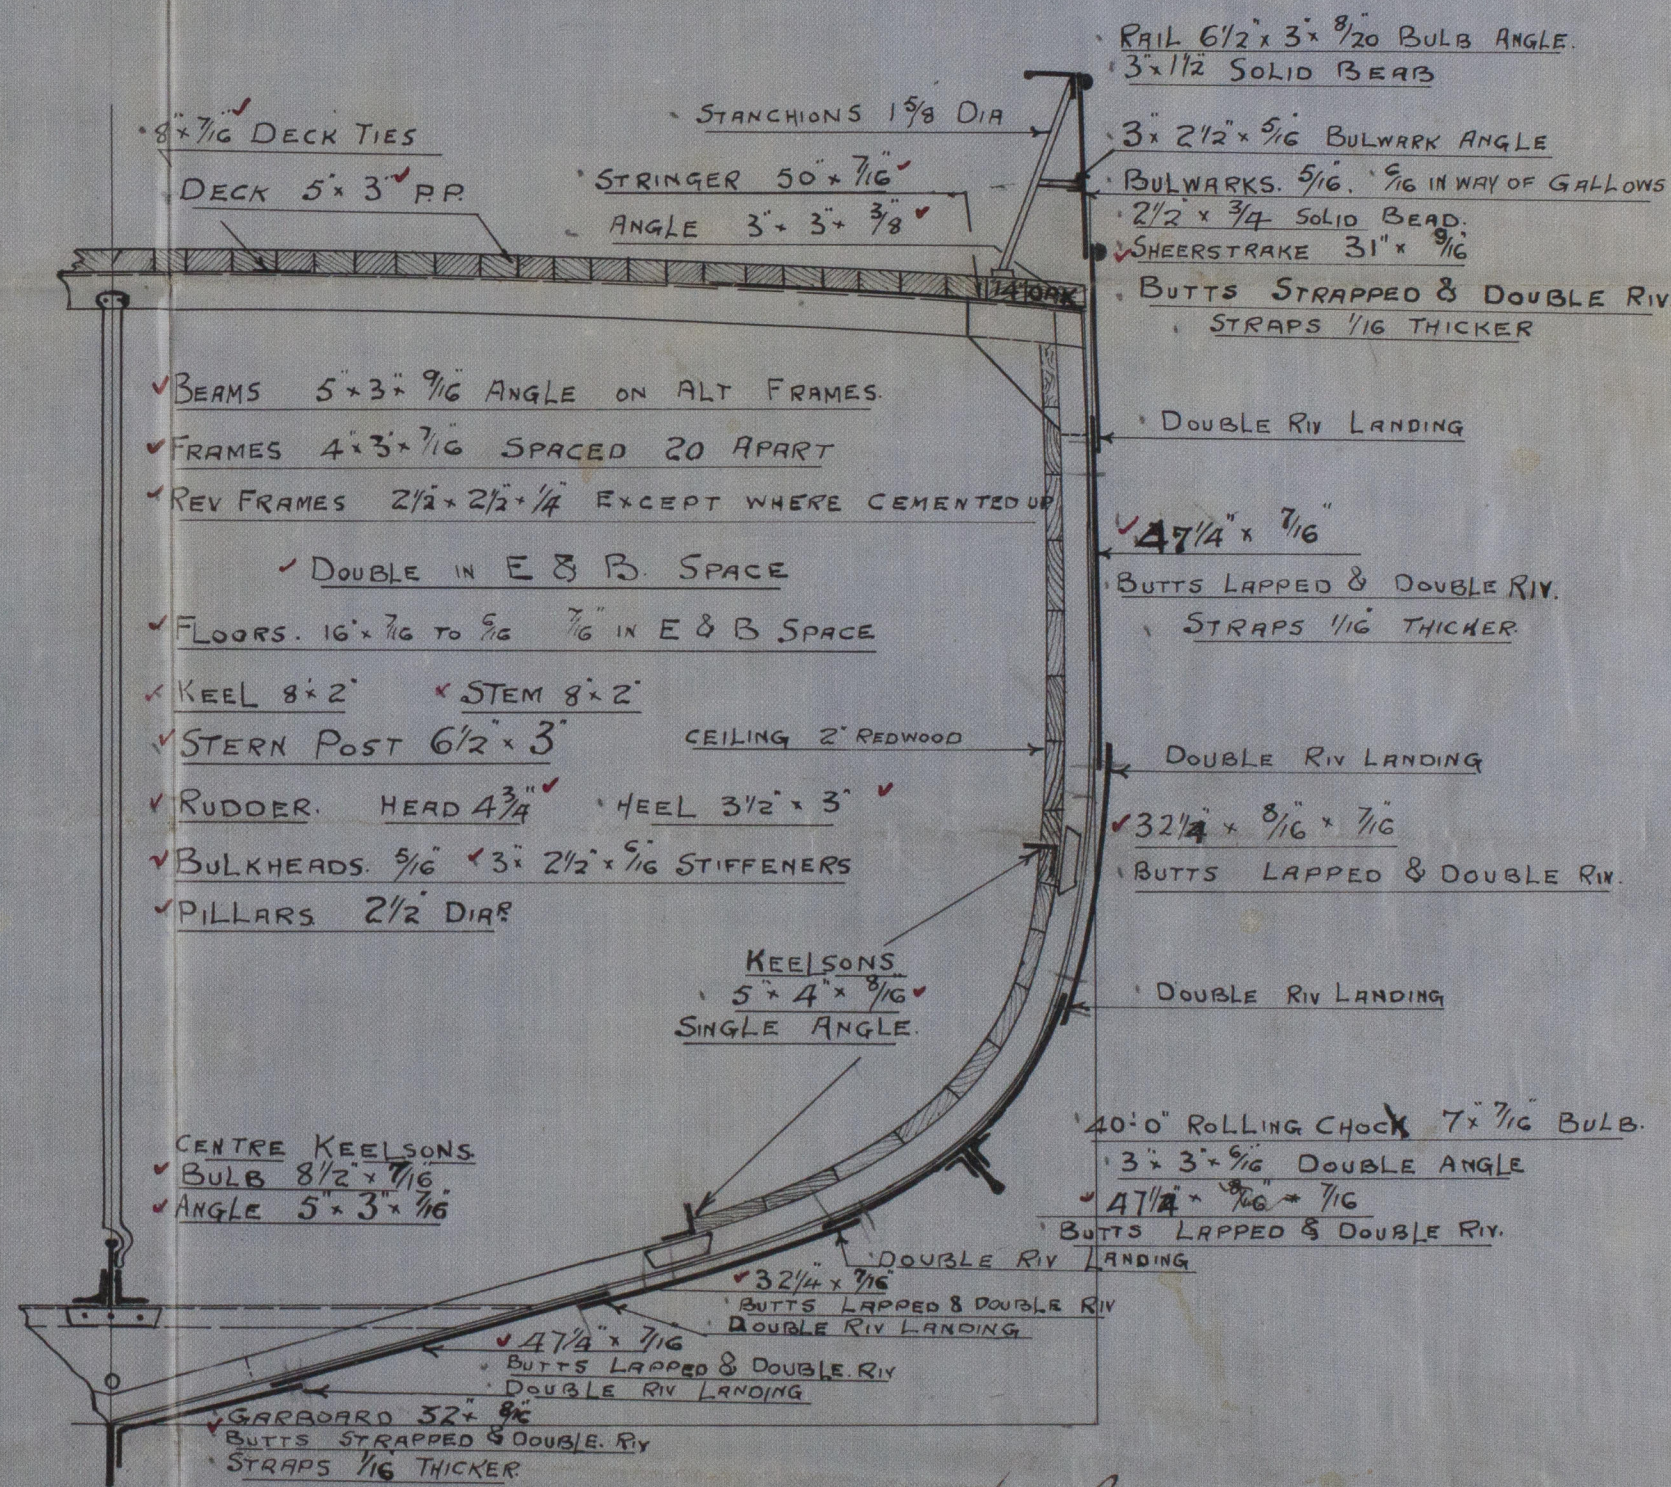

C.B.
12.11.06.

Cochrane & Sons
No. 391.

Midship Section.
of "Cleopatra".
Hull Report No.

DEPTH TO LENGTH
PROPORTIONS

2016.2548 S. No.

23.81 21 No

2.87
2.18

BRITAIN



© 2020

Lloyd's Register
Foundation

W954-0050