
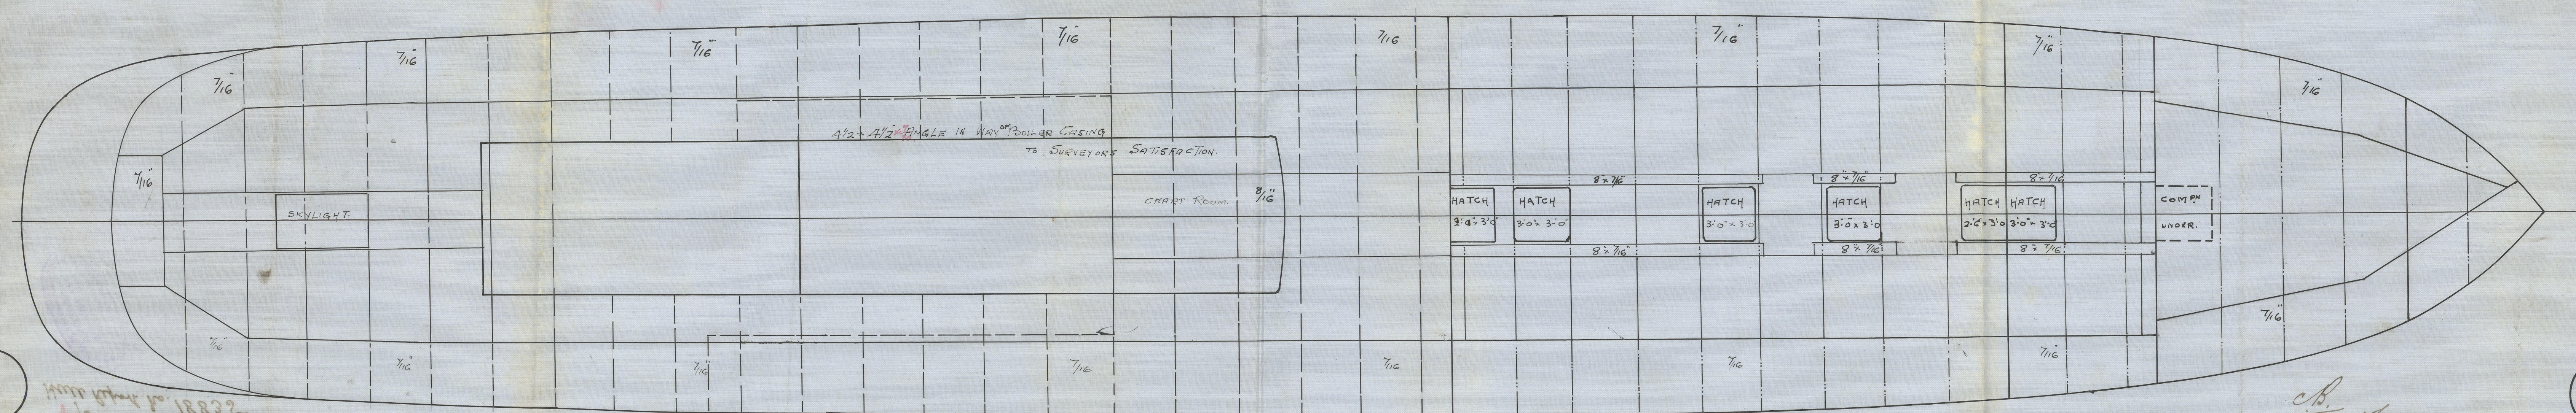
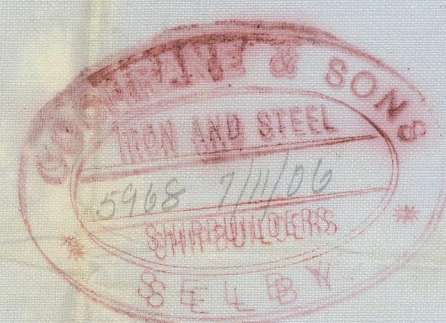


PROFILE & DECK PLAN.

S. S. N° 391.

LEN = 128'6" x 22'0" BEAM x 12'6" DEPTH MLD.

SCALE 1/4" = ONE FOOT.

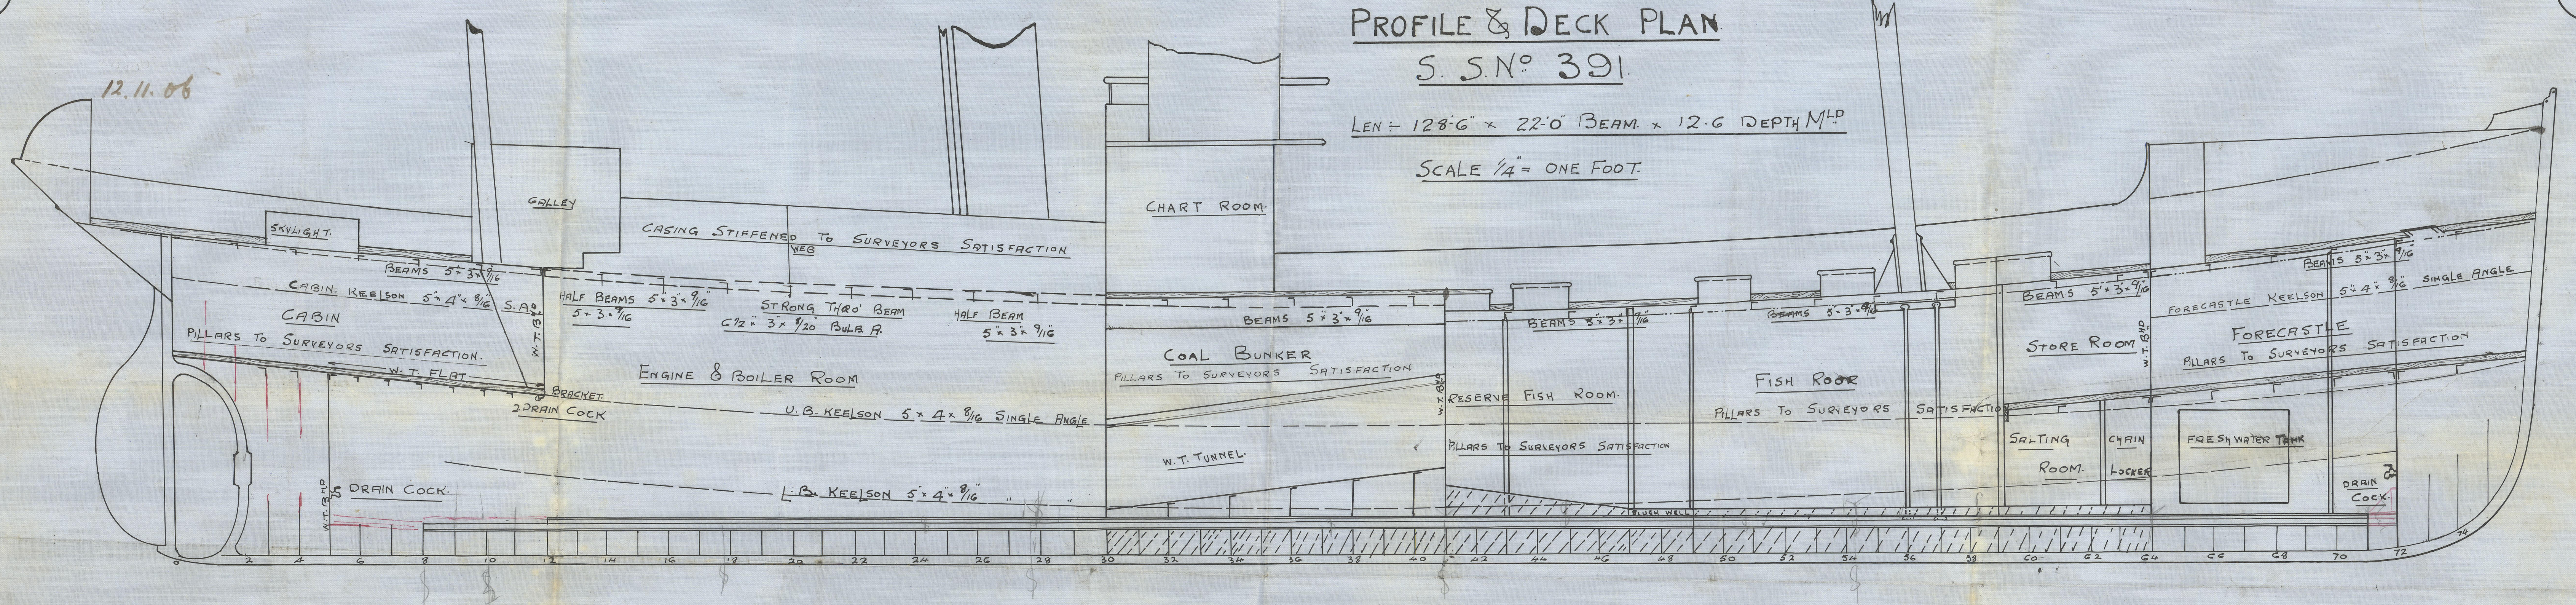

12.11.06
16.301
C. J. & S. Sons

C.B.
12.11.06.

150

Cochrane & Sons


N^o 391

Profile & Decks

S/S Cleve


Hull Report No. 18835

RETAIN

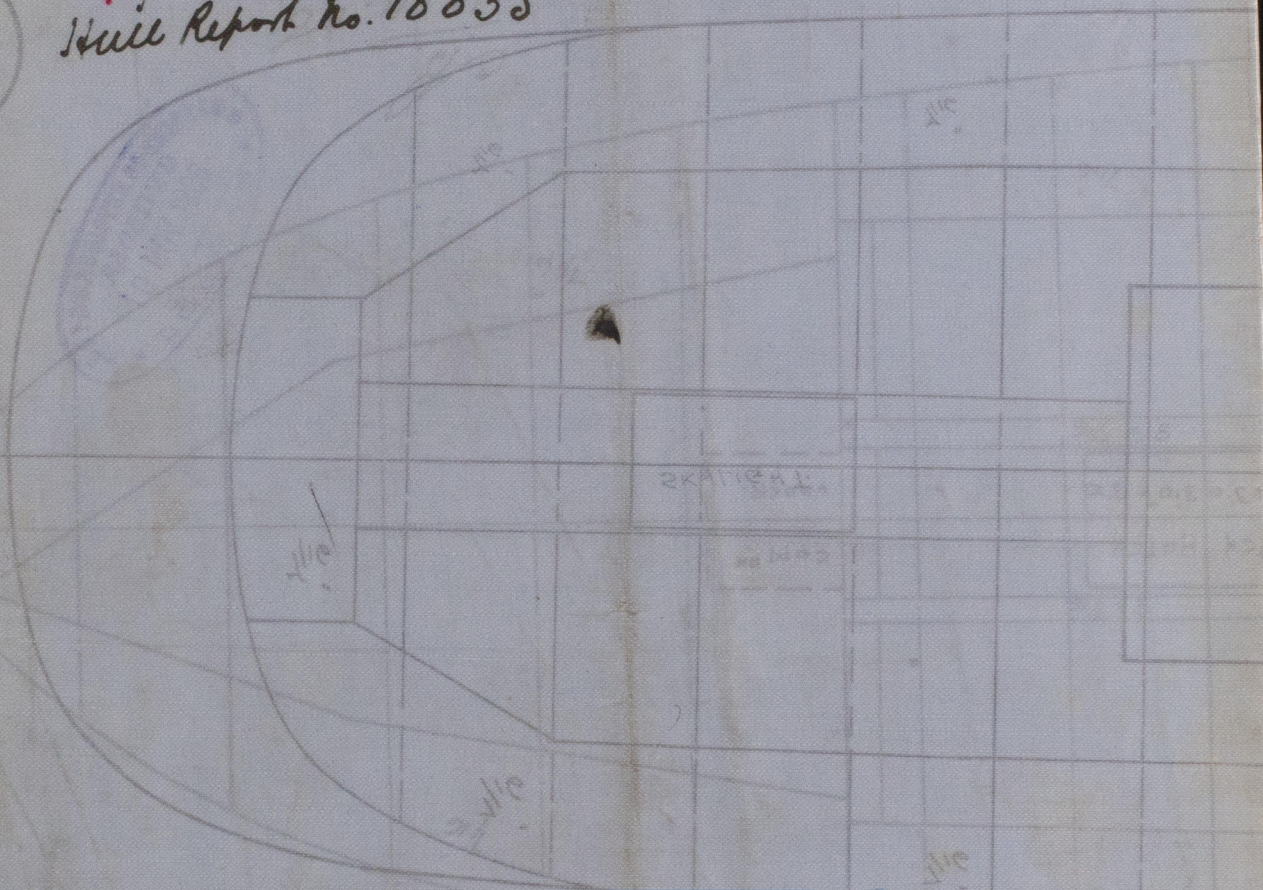

© 2020

Lloyd's Register
Foundation

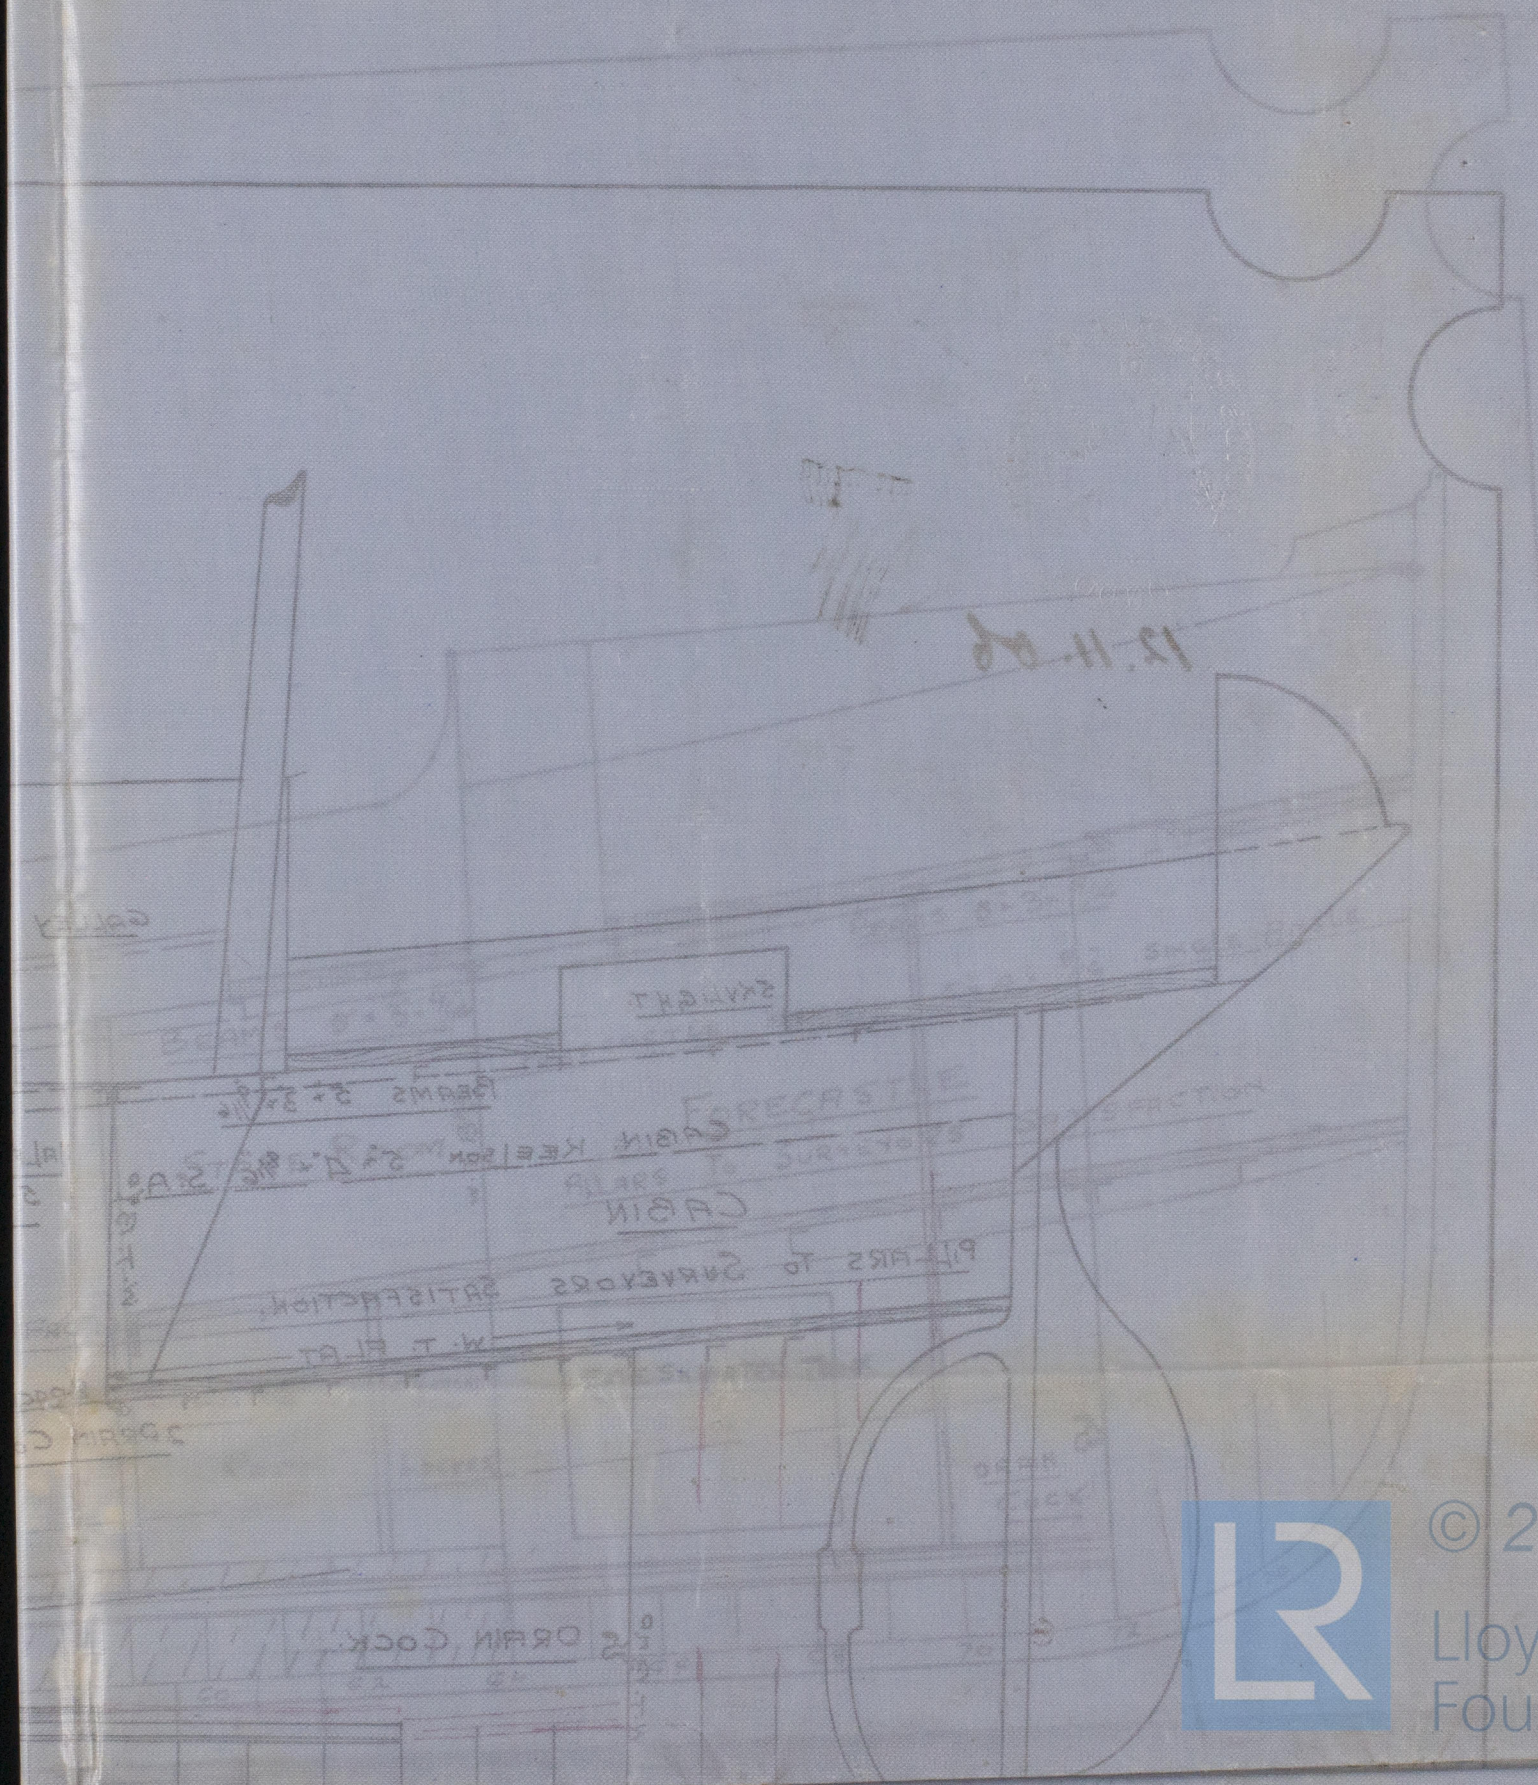

Profile & Deck Plan 391.



© 2020

Lloyd's Register
Foundation