


LENGTH B.P.	345'-0
BREADTH MLD.	50'-11 1/2
DEPTH MLD TO MAIN DECK.	27'-9 1/2

LONGITUDINAL SECTION

SCALE $\frac{1}{8}$ " = ONE FOOT

TR N° 9683

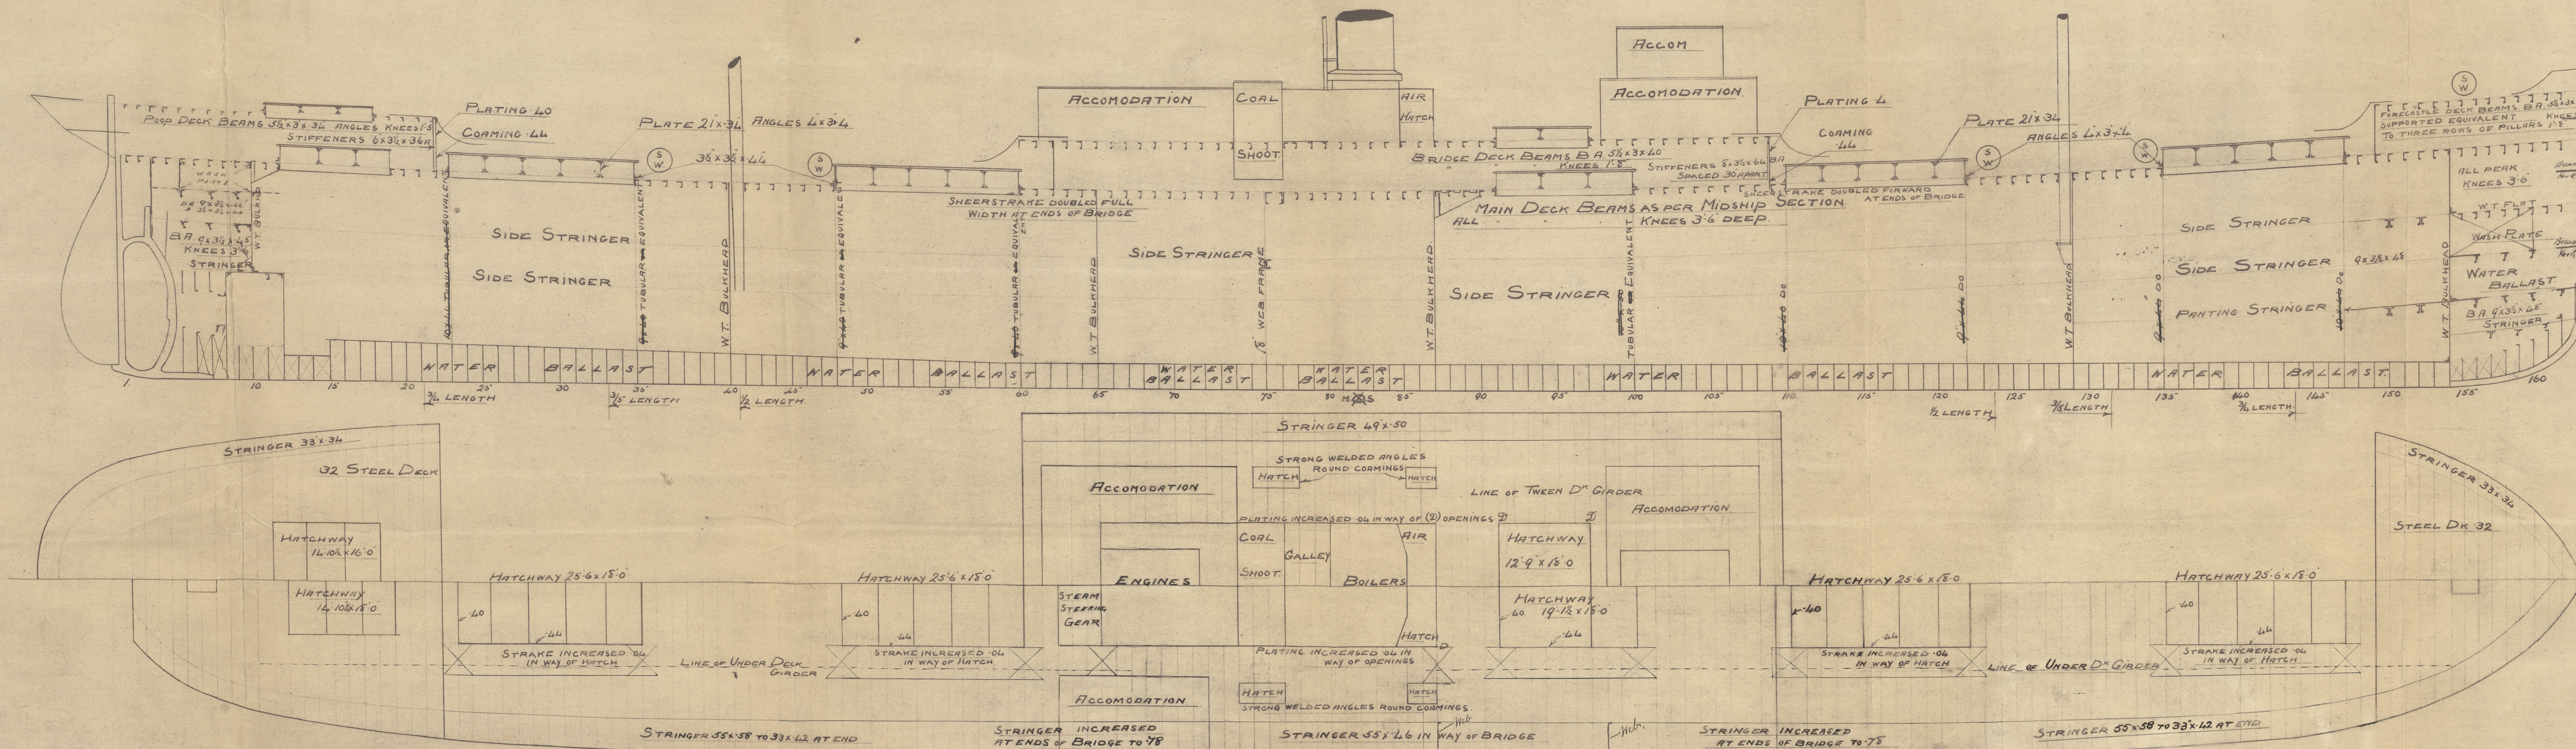

Craig, Taylor & Co
No 139
S. S. Bengrove
Profile & Deck Plans
as built-

Mar. F. C. Rpt. No 6209

WASS-0085



© 2020

Lloyd's Register
Foundation