

PLAN No. 166-9
FOR ENCLOSURE To
Messrs Lloyd's Surveyors
Hull FROM
COCHRANE & SONS,
SHIPBUILDERS, SELBY
DATE 26/6/12 RR

STEEL SCREW TRAWLERS

N⁰⁵ 524-58.9 530, 535, 536

DIMNS LEN 133'4" 23'0" E x 12'9" DEPTH MOULDED

Cochrane + ~~Don~~

No: 524.5-9530-5-6

Duplicate.

Profile + Deck plan.


W958-0102

~~L Balfour~~ ~~Shull~~ ~~Report~~ No: 25162

• Bonar Law " " - 25163

• Andrew Marvel " " "

• Lord Lester " " "

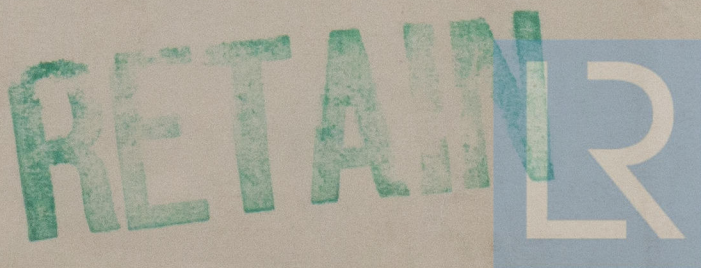

© 2021

Lloyd's Register
Foundation