

PLAN No. 1118
 FOR ENCLOSURE TO
 Messrs. Lloyd's Surveyors
 Hull FROM
 COCHRANE & SONS
 SHIPBUILDERS, SELBY
 DATE 26/8/12 RK

MIDSHIP SECTION


STEEL CREW TRAWLER

N^{OS} 524-589

DIM^{NS} LEN 133'4" 23'0" EX * 12'5" DEPTH MOULDED

SCALE 1/2" = ONE FOOT

TO CLASS 100 A1 FOR FISHING PURPOSES DECK PLATED OVER IN WAY OF
 MACHINERY SPACE. ENGINE & BOILER CASING AS PREVIOUSLY APPROVED.

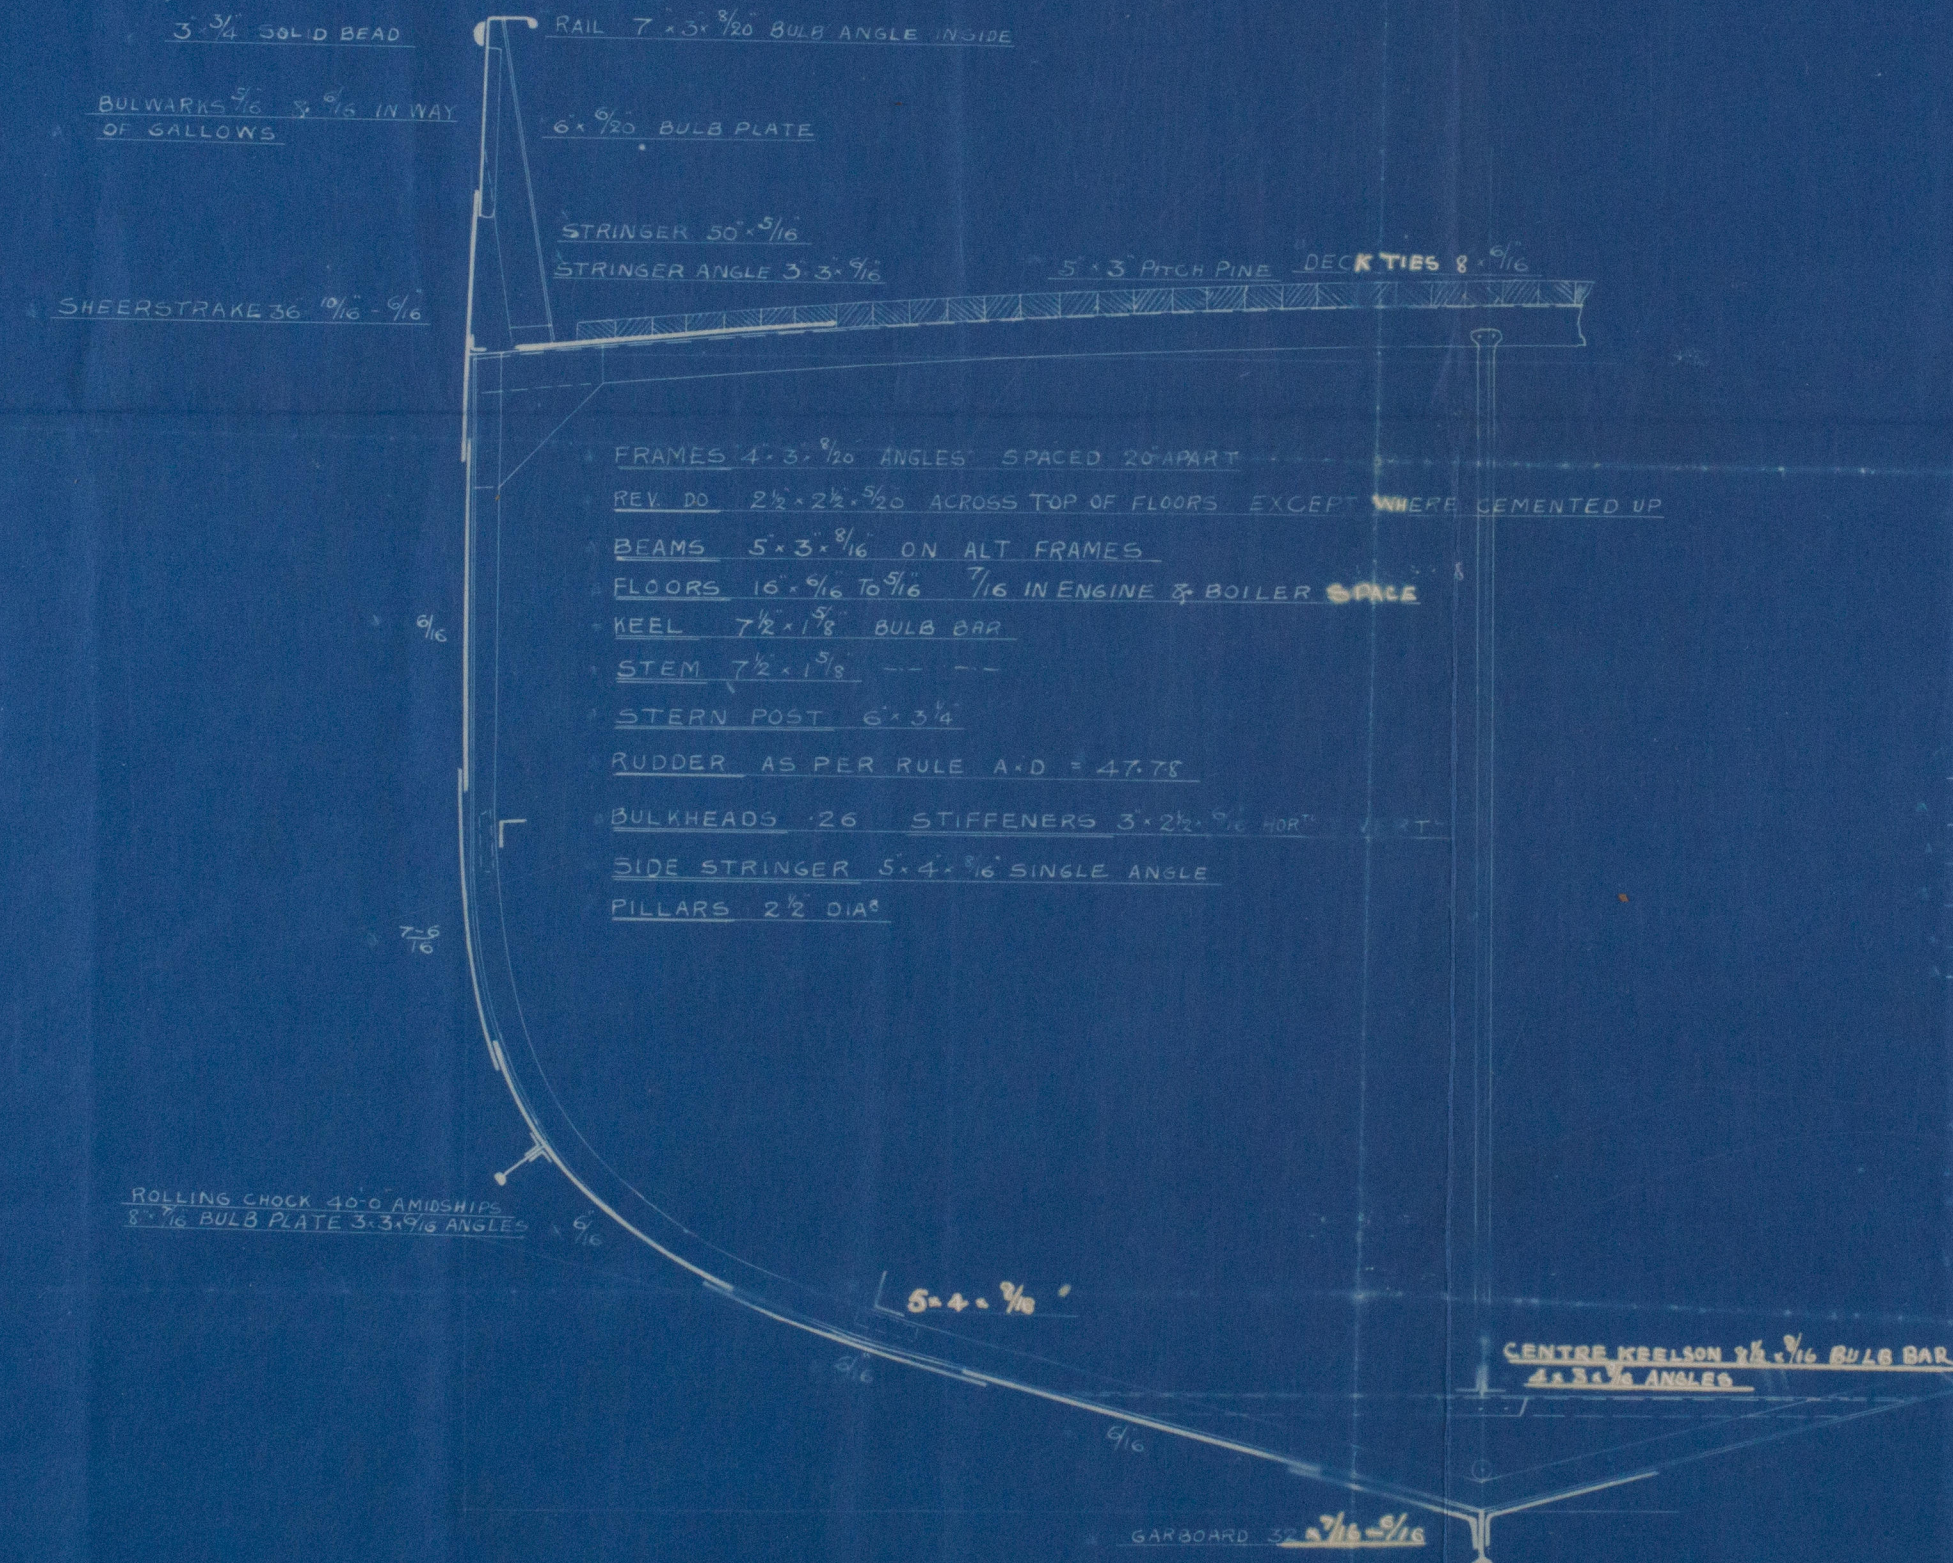

NUMERALS

B+D = 35.63
 L(B+D) = 4750.55

PROPORTIONS

L/D = 10.45
 L/B = 5.85

EQUIPMENT

1 ST BOWER ANCHOR	5 3/4 CWTs EX STOCK
2 ND ---	5 1/4 ---
KEDGE ---	3 ---
105 FATHOMS	1 1/2 CABLE
60 ---	6 HAWSER
60 ---	5 WARP

RIVETING

BUTTS OF SHELL PLATING LAPPED & DOUBLE RIVETED
 EXCEPT GARBOARD & SHEERSTRAKE WHICH ARE TO BE
 STRAPPED & DOUBLE RIVETED. LANDINGS DOUBLE RIVETED
 BULKHEADS SINGLE RIVETED.

Vertical handwritten notes on the right margin, including '25.5', '23.0', '20.0', and other measurements, along with a signature 'C.B.' and date '20.1.12'.



RELAN

Cochrane & Oms
Nos 524. 59. 530 5-6.
Duplicate
Midship Section.

4 Balfour	Shill	Hft	No: 25162
• Bonar Law	"	"	25163
• Andrew Manuel	"	"	
• Ross Lister	"	"	

W958-6103



© 2021

Lloyd's Register
Foundation