


GIRDER UNDER SHELTER DECK				
SPAN	OF	ANGLES	THICKNESS	RIDER
23-2	6	4 x 1 1/2	9/20	13/20
27-1	"	"	"	19/20
25-0	"	"	9/20	No Rider
20-10	6	4 x 1 1/2	9/20	"
18-9	6	4 x 1 1/2	7/20	"
16-8	6	4 x 1 1/2	"	"
14-7	6	4 x 1 1/2	"	"

GIRDER UNDER UPPER DECK				
SPAN	OF	ANGLES	THICKNESS	RIDER
23-2	6	4 x 1 1/2	19/20	13/20
27-1	"	"	"	19/20
25-0	"	"	9/20	No Rider
20-10	6	4 x 1 1/2	9/20	"
18-9	6	4 x 1 1/2	9/20	"
16-8	6	4 x 1 1/2	"	"
14-7	6	4 x 1 1/2	"	"
10-5	6	4 x 1 1/2	"	"

GIRDER UNDER MIDDLE DECK				
SPAN	OF	ANGLES	THICKNESS	RIDER
23-2	6	4 x 1 1/2	19/20	13/20
27-1	"	"	"	19/20
25-0	"	"	9/20	No Rider
20-10	6	4 x 1 1/2	9/20	"
18-9	6	4 x 1 1/2	9/20	"
16-8	6	4 x 1 1/2	"	"
14-7	6	4 x 1 1/2	"	"
10-5	6	4 x 1 1/2	"	"

S.S. No 213  
 PROFILE, STRINGER & DECK PLANS.  
 SCALE 1/8" = 1 FT.  
 DIMENSIONS 380'-0" B.P. x 50'-6" EX. x 28'-0 3/4" TO UPPER DECK.

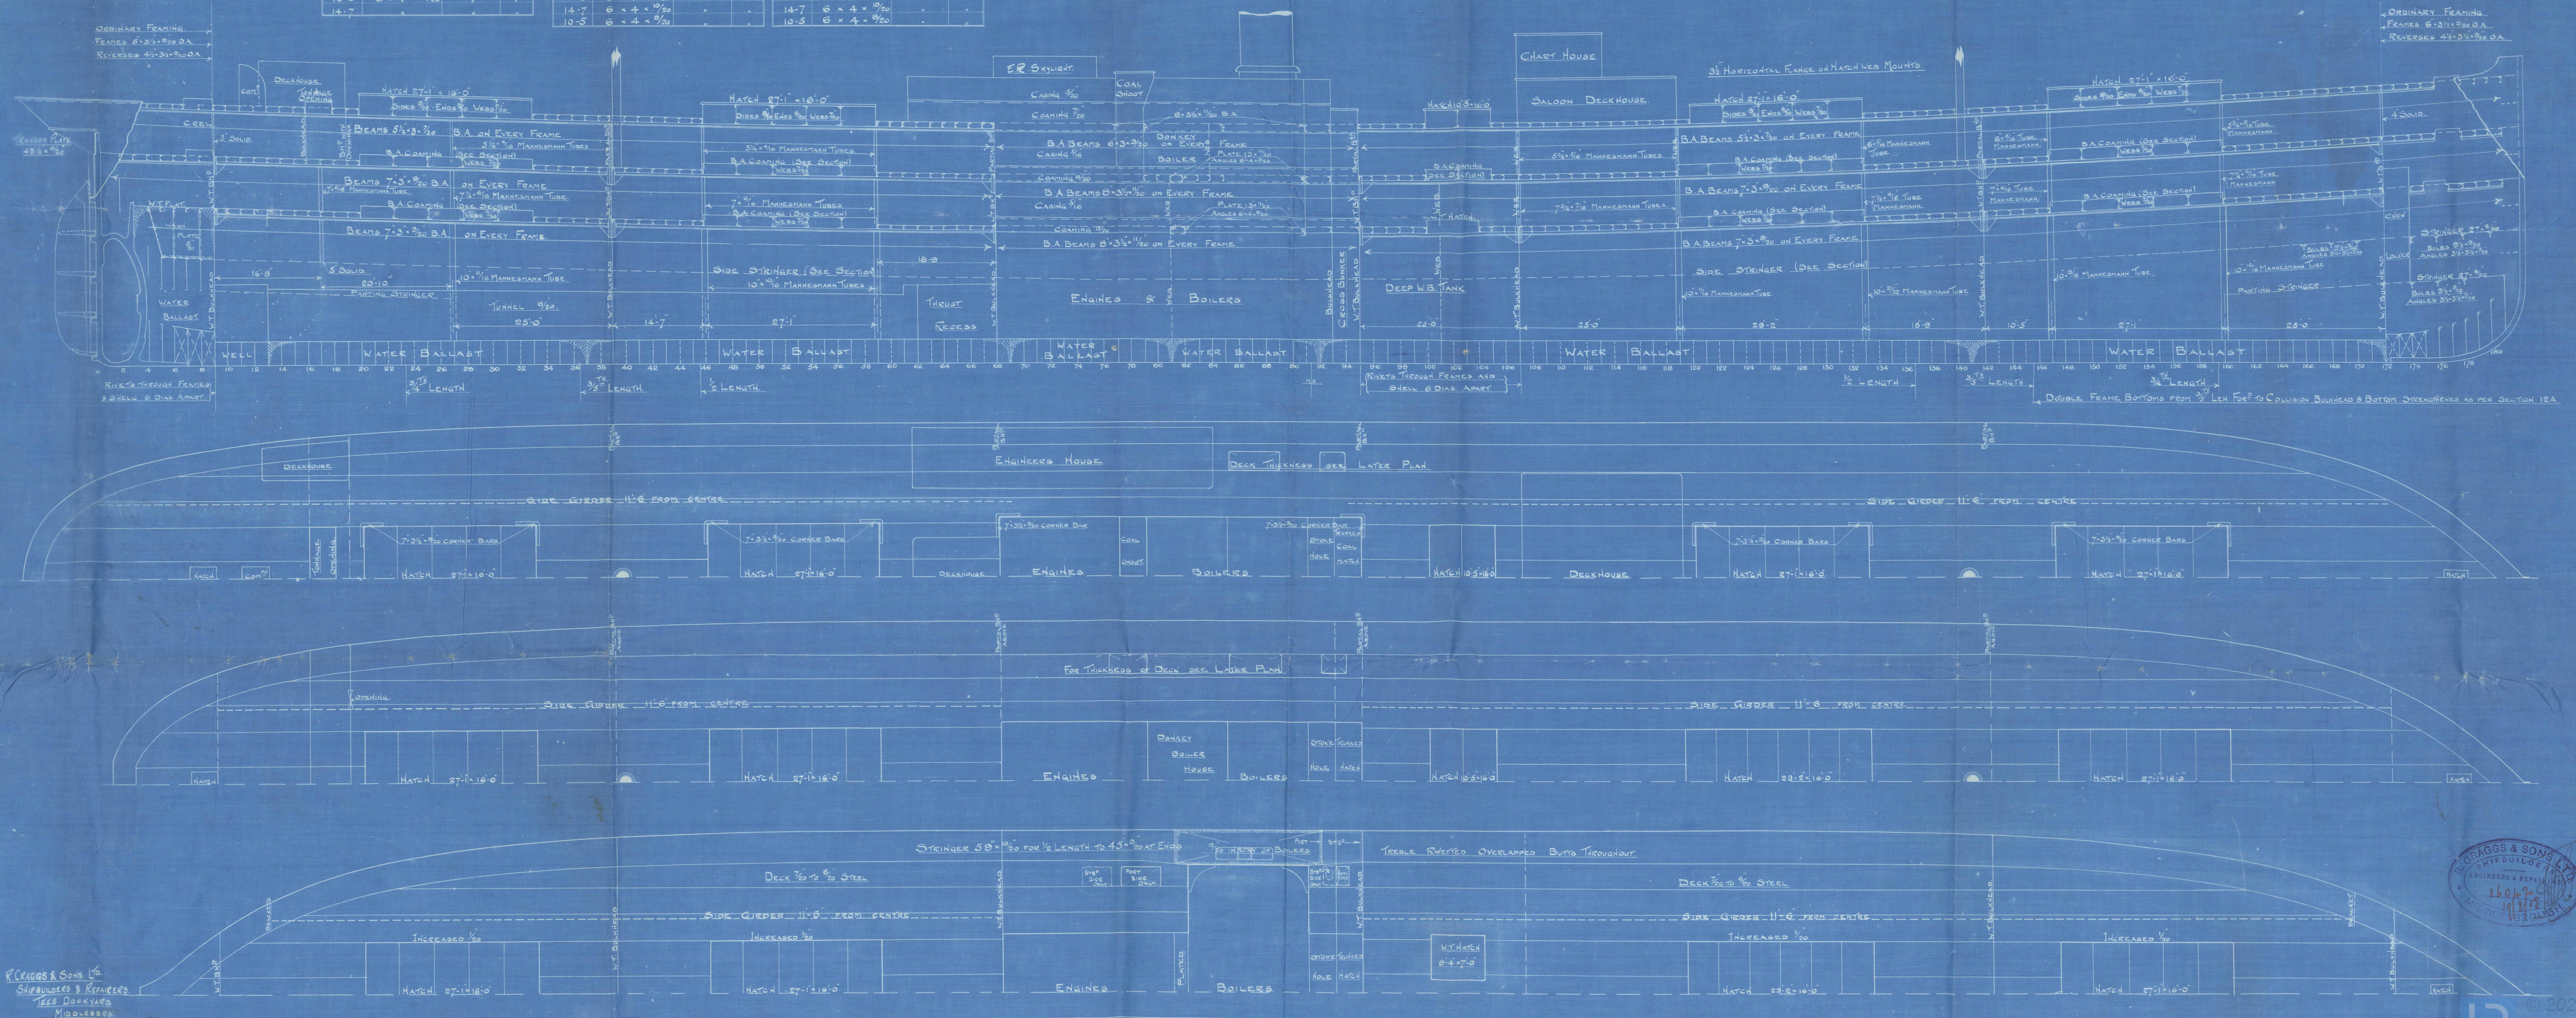

R. CRAGGS & SONS LTD  
 SHIPBUILDERS & REPAIRERS  

R. CRAGGS & SONS LTD  
 SHIPBUILDERS & REPAIRERS  



R. Cragg & Sons

S. S. No. 213

Profile of Vessel  
(As built.)

S.S. "Daer Castle"

Mod. App. No. 5383

RETAIN

RETAIN

W959-0077



© 2020

Lloyd's Register  
Foundation