



Received at GREENOCK Office, 24 DEC. 06 1896

Lloyd's Register of British & Foreign Shipping.

(Report on Vessel No. 15173 Port GREENOCK)

A. S. Mackenzie

No. 1416 SHIP FORGINGS OR CASTINGS.

The words FORGINGS or CASTINGS, IRON or STEEL, should be struck out as may be required.

I have to report that the undermentioned Iron or ~~Steel~~ Forgings or ~~Castings~~, manufactured by *The Portland Forge Coy* of *Kilmarnock* for the Vessel No. *1957*, being built by *Messrs Tom Hamilton & Co* Port *Glasgow* have been inspected by me as set forth below and found to be, so far as can be seen, *Sound & efficient*


Mark on Forgings.

Lloyd's
No. *1416*
WH

William Hamilton
Glasgow 8/12/06

	STERN FRAME.	RUDDER FRAME.	STEM.
Material*	<i>Scrap iron</i>		
How made	<i>Forged</i>		
Dimensions	<i>11 x 6 3/4</i>		
Progress on Inspection	<i>Forging & smithing</i>		
Date when Inspected	<i>18/6/06 to 7/12/06</i>		

SKETCHES OF FRAMES SHOWING POSITION AND DESCRIPTION OF WELDS OF FORGINGS, OR PARTICULARS OF TESTS APPLIED TO CASTINGS.

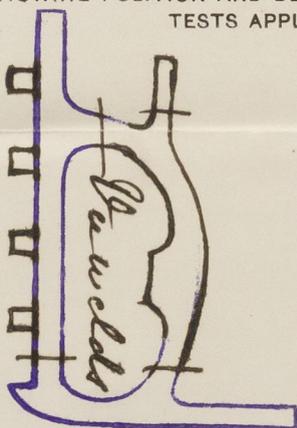

Fee (if any chargeable) £ : :

To be paid at _____



* If of Iron, state whether scrap or puddled Iron.

Theraprame.

Hamilton & Co. No 195.

22/12/06.

[Faint, illegible handwritten text, possibly bleed-through from the reverse side of the page]

[Faint, illegible handwritten text, possibly bleed-through from the reverse side of the page]

[Faint, illegible handwritten text, possibly bleed-through from the reverse side of the page]



© 2020

Lloyd's Register
Foundation