

AMENDED MIDSHIP SECTION.

SCALE 1 : 24.-



BRIDGE SH
PIER

41" x .46 FRS
(41" x .46 + 0.4)
DOUBLED FRS

BUTTS LAPPE
DOUBLE RIVET
 $\frac{3}{4}$ " PLATE



3 3/2 DIA^E
TIGHTENED AS PER RULE.

100



frontispiece


157

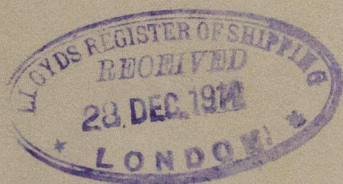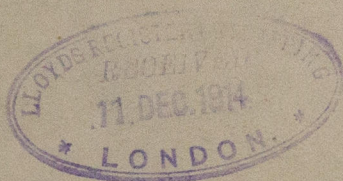

S. S. Foasterland

Rotterdam report no. 9609

*Plan of midship
Section.*

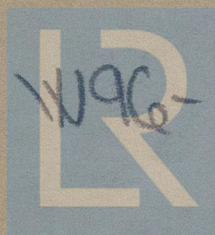

© 2020

Lloyd's Register
Foundation