
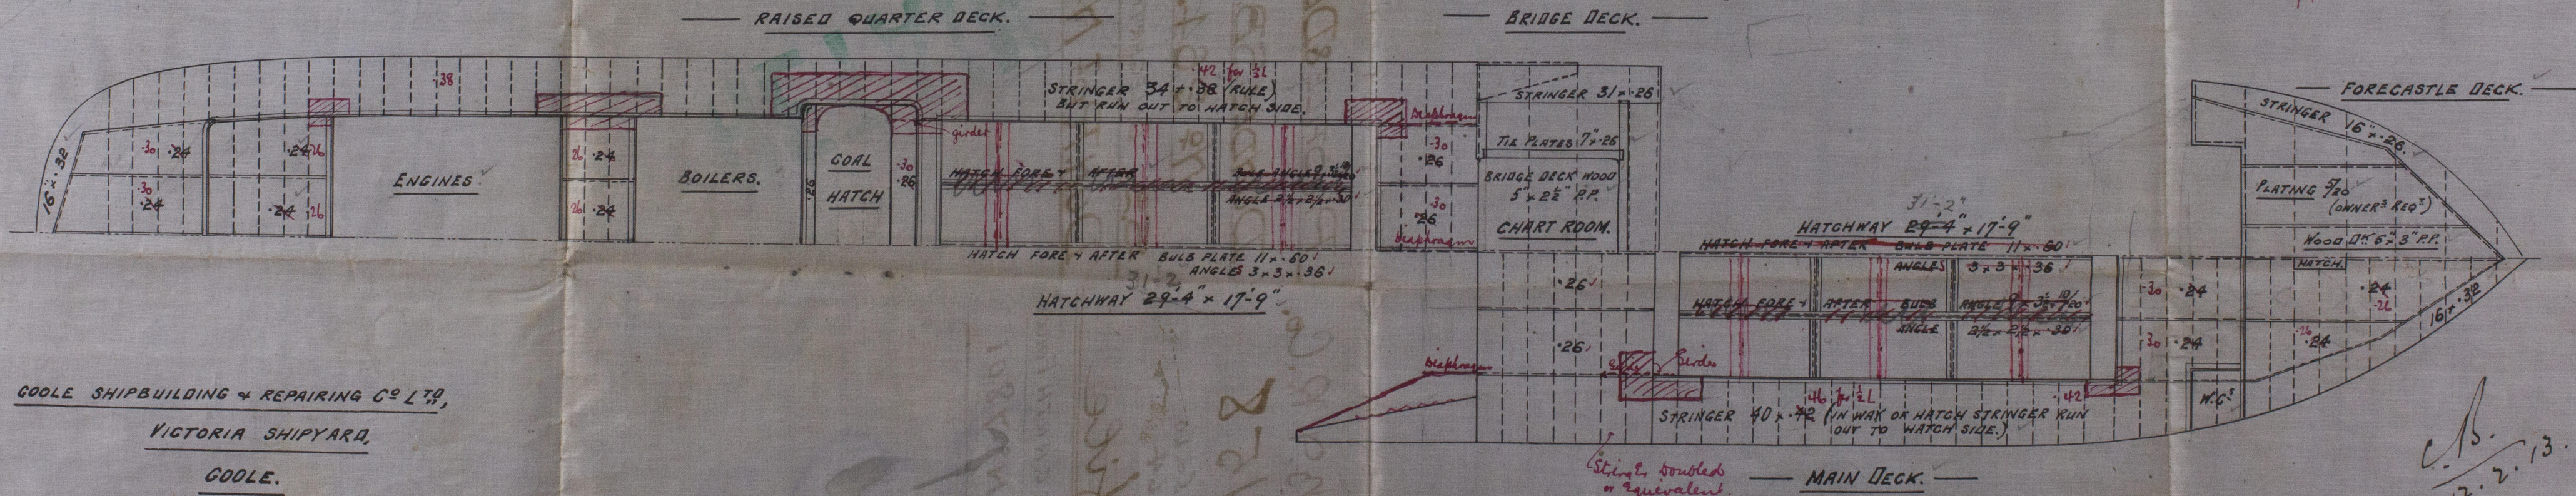


12.2.13
15.4.13

No 158.
ELEVATION.
DIMENSIONS 175'-0" B.P. x 28'-0" EX x 13'-6" M.M.D.K.
SCALE 1/8" = 1 FT.

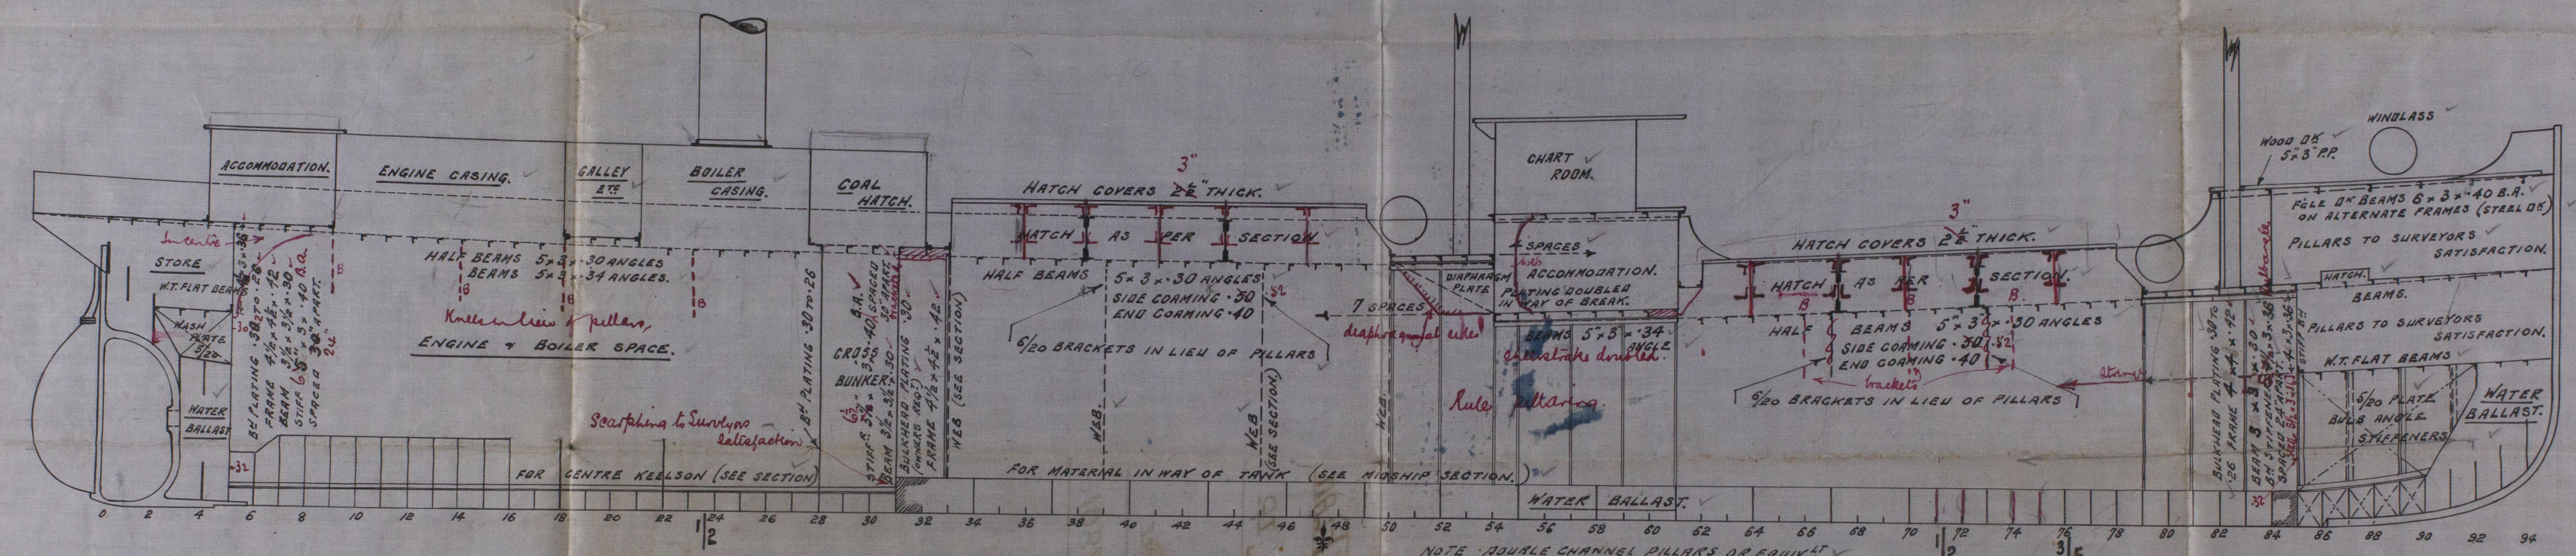

GOOLE SHIPBUILDING & REPAIRING CO. LTD.,
VICTORIA SHIPYARD,
GOOLE.

Goole S.B. & R. Co.

No. 158

DUNDEE S.B. Co. Ltd
No 264

Profile

S.S. "DALEGARTH FORCE"

DUN. RPT No 7801

W960-0102

PROFILE & DECK PLAN

DUNDEE S.B. Co. Ltd

No 264.

S.S. DALEGARTH FORCE

DUN. RPT No 7801.



© 2020

Lloyd's Register
Foundation