

MIDSHIP SECTION

- OF -

STEEL SCREW TRAWLERS. N^o 398


CLASS 100 AI AT LLOYDS.

SCALE $\frac{3}{4}'' = 1 \text{ FOOT.}$

EQUIPMENT

1 ST	ANCHOR	7½	CWTS	STOCKLESS	✓
2 ND	"	7	"	"	✓
3 RD	"	3	"	EX STOCK	✓
120	FATHOMS	1¼		STUDLINK CHAIN	✓
60	"	6		HAWSER	✓
60	"	5		WARP	✓

SCANTLINGS		
25 6.13	LENGTH BETWEEN PERPENDICULARS	130' 0"
25 11.13	BREADTH - MOULDED	23' 5"
	DEPTH -	14' 0"
"	"	12' 6"
1 ST N ^O	(B+D)	37' 5"
2 ND N ^O	L(B+D)	4875' 0"
PROPORTION	$\frac{L}{B}$	9.3 ✓

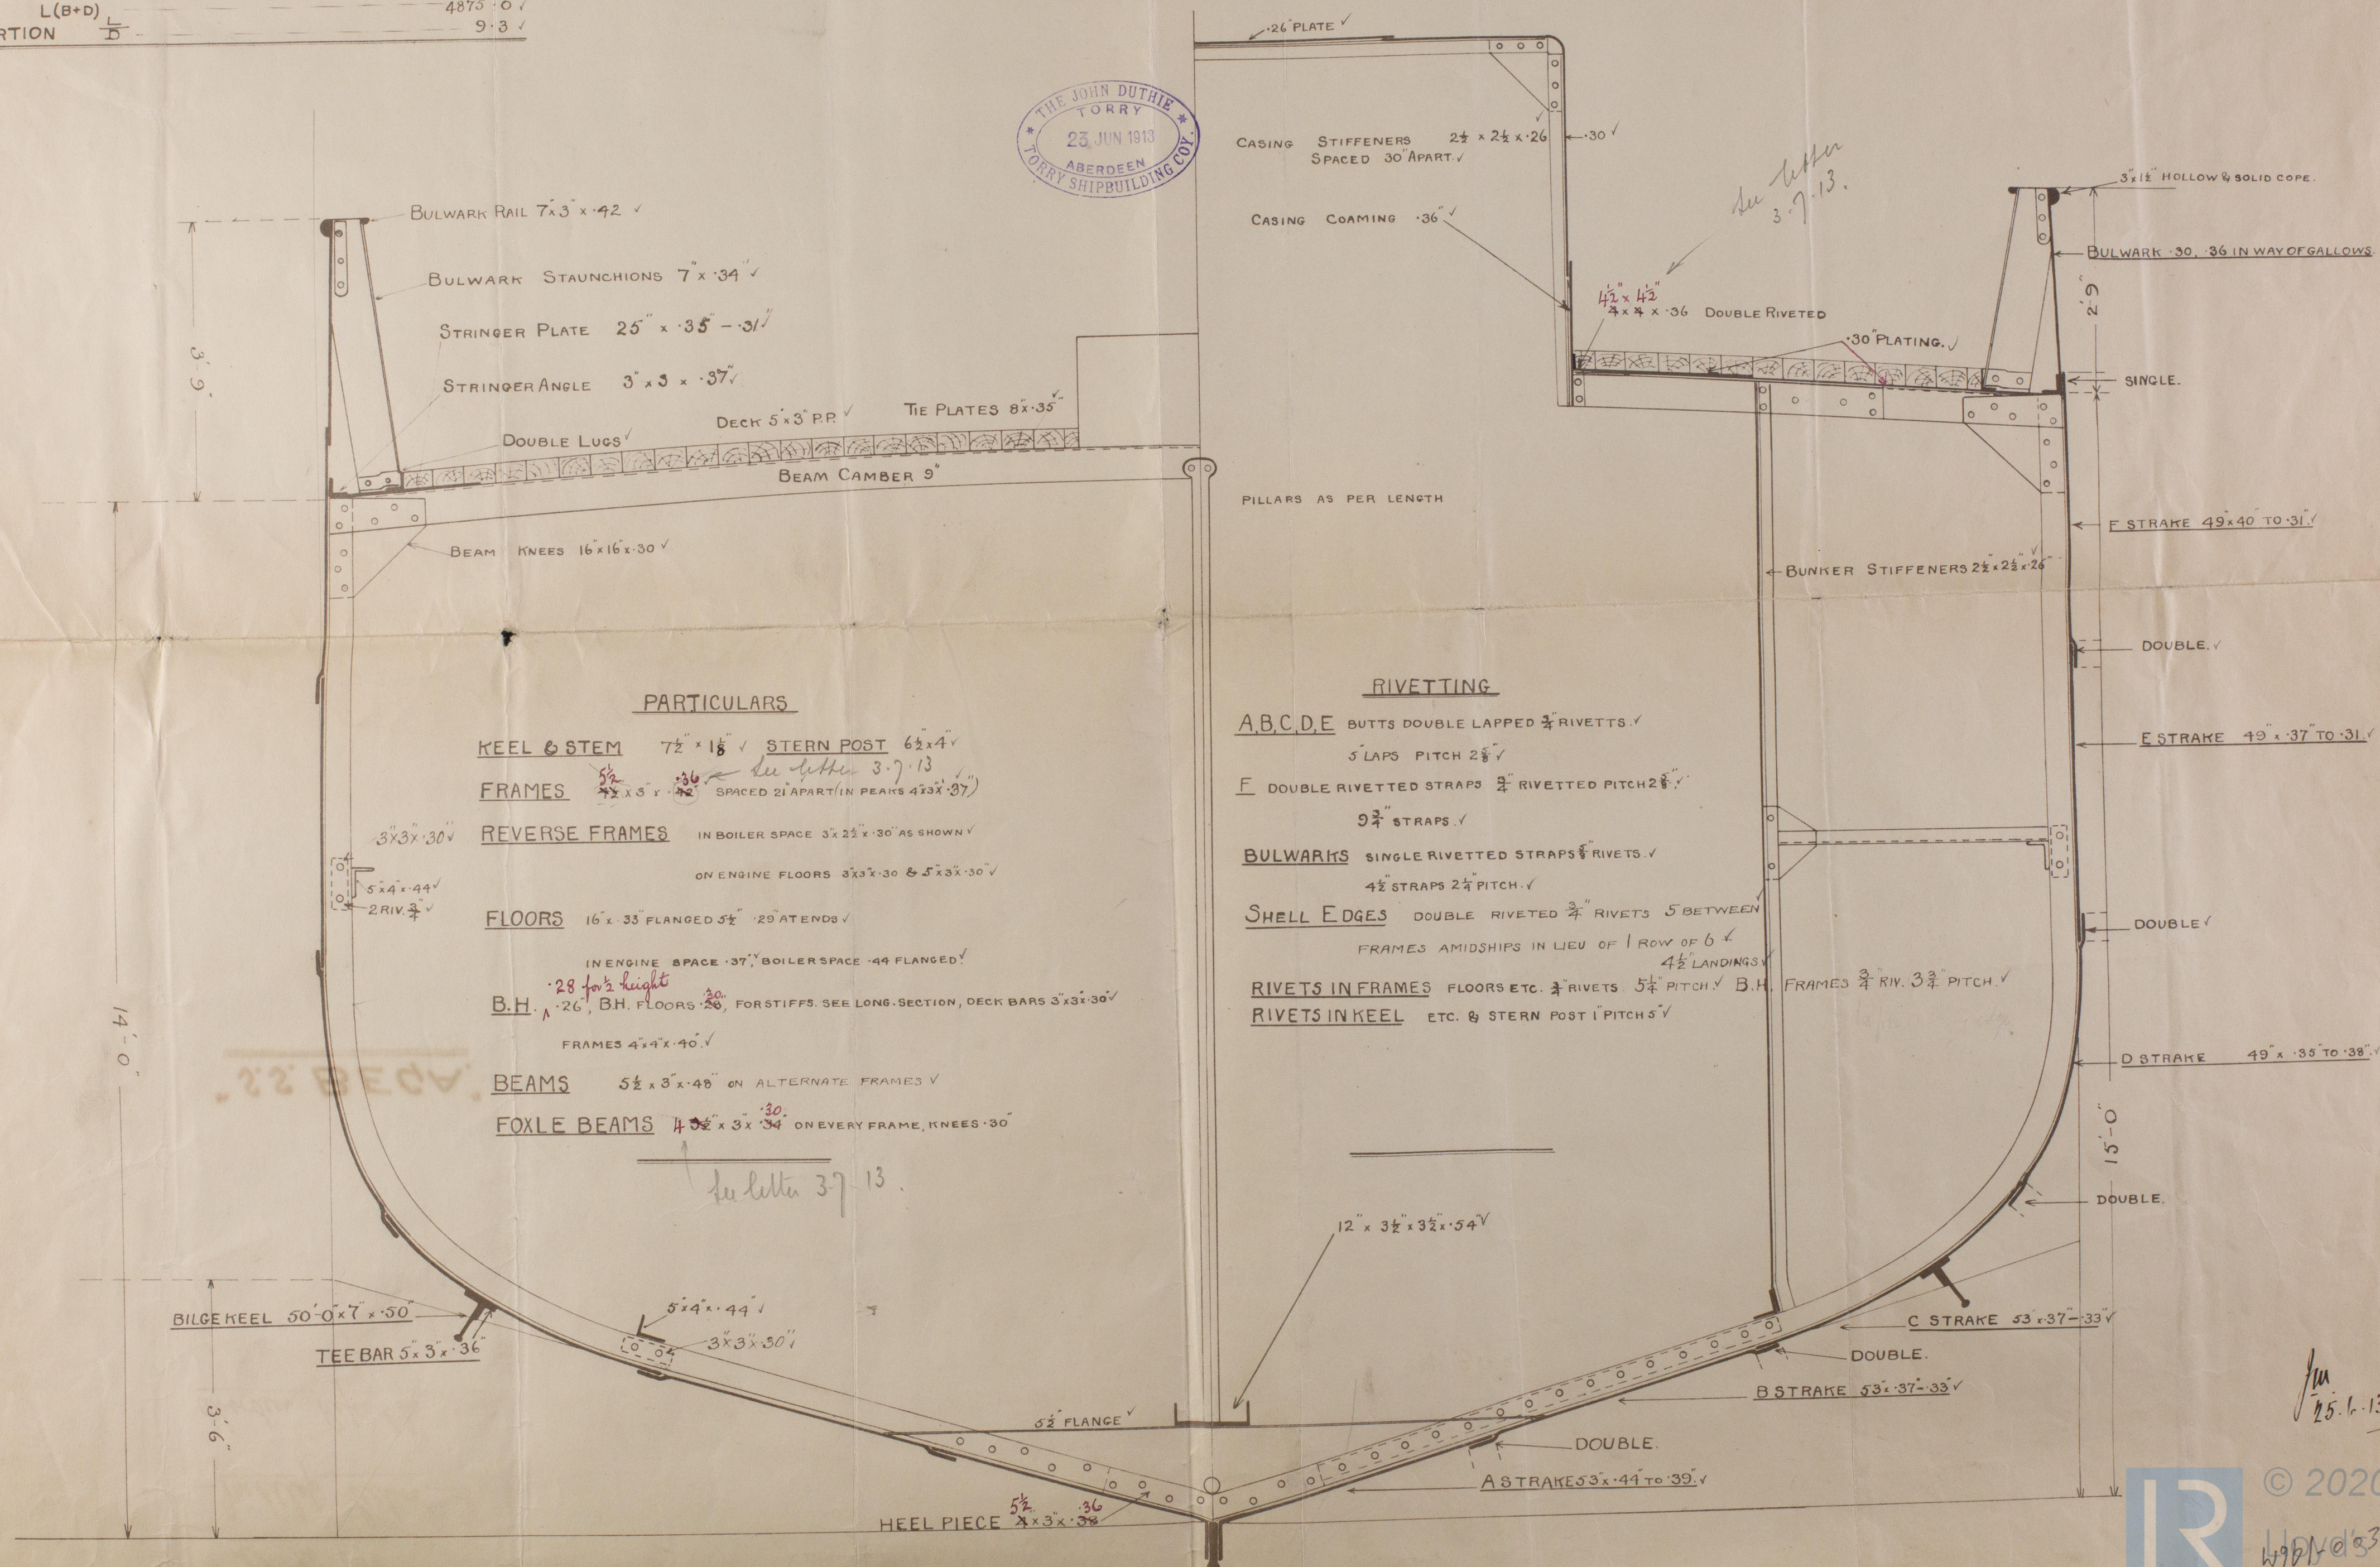

Jun
25.6.13


J. Guthrie Lorry S.B.Co

S.S. No 398

Midship Section.

aberdien Report No 11386.

RETAIR

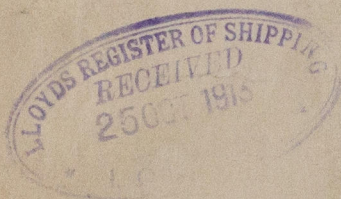

"S.S. BEGA."



© 2020

Lloyd's Register
Foundation