

**No 91. 92** *act.*  
**PROFILE** *29-12-04*

Returned 21-12-04

2/2 2110 2/2



ENCLOSURE

From ROBERT STEPHENSON & Co., Ltd.,




for

Lloyd's Register  
Foundation

W961-0112 1/2



J. Stephenson & Co. Ltd.  
5/5 No. 92  
Profile

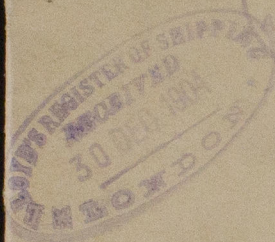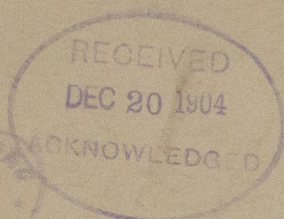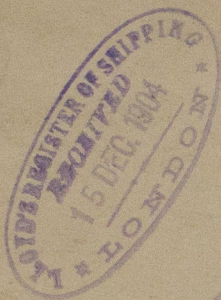

J. F. Lindalehall

Newcastle Report

No 49926



RETAIN

W961-0112



© 2020

Lloyd's Register  
Foundation