


FREEBOARD PARTICULARS.	
LENGTH OF LOID LINE	350 - 1'
Moulded Depth to Spar DL	29 - 0 1/2'
Tonnage Coefficient (Uncorrected)	17/95
Length of Erections	29 - 0
POOP	11 - 0
ORRIZE	37 - 0
FILE	179 - 0
MEAN SHEER OVER TOTAL LENGTH	1/2
SHEER FORWARD	05
AFT	45
AT 1/8 LENGTH FROM STERN	50 1/4
STERN	24 3/4
MEAN SHEER = 1/8 LENGTH.	33 3/5

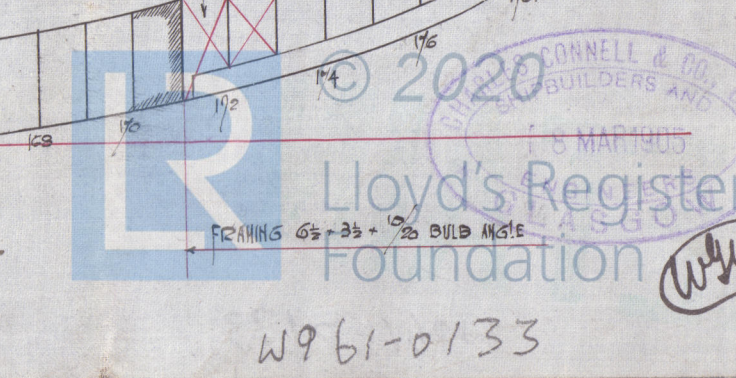

(30E) 2020

