
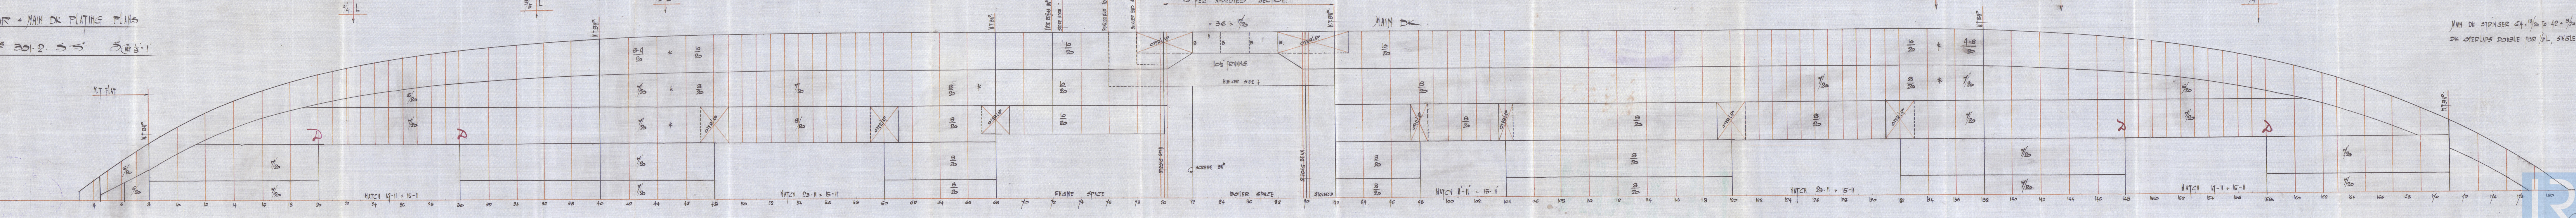


29.3.05

SPAR + MAIN DECK PLATING PLANS
 1/2 301.2.55. 5/16 3/4

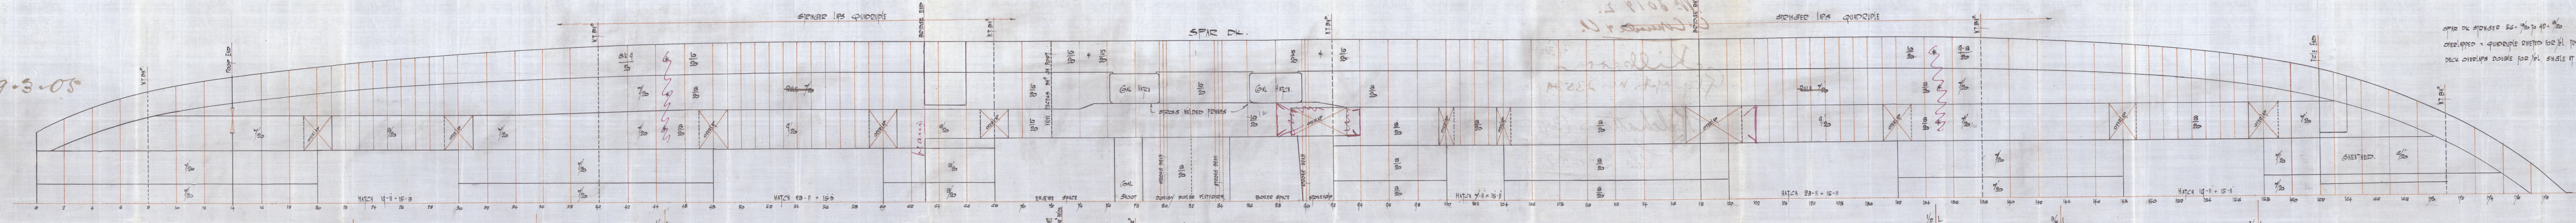

SPAR DECK STIMMER 56" x 10" to 40" x 8"
 OVERLAPPED + QUADRUPLE RIVETED FOR 1/2. TREBLE AT ENDS. TREBLE IN WAY OF BRIDGE.
 DECK OVERLAPS DOUBLE FOR 1/2, SINGLE AT ENDS.

MAIN DECK STIMMER 64" x 10" to 40" x 8" TREBLE RIVETED.
 DECK OVERLAPS DOUBLE FOR 1/2, SINGLE AT ENDS.

Deck plans.

No 8019 L.

C. C. Munde & Co.

Kilberran (302)
Gls. rpt. No. 23529.

Kilchattan (301)

Gls 23459.



© 2020

Lloyd's Register
Foundation
W 961 073