

13.5.12  
11.10.12


LONGITUDINAL ARRANGEMENT SCALE 1:96.

48' 4" OUTS SS. x 62' 5 1/2" x 32' 1" DEPTH MLD U.D.K.


N° 332

NOTE: IN ORDER TO SIMPLIFY WORK BULBANGLE FOR PILLAR GIRDER ARE AS FAR AS POSSIBLE TAKEN OF SIMILAR SECTION IN THE RESPECTIVE HOLDS!

N° 332

 

PROJECT  
N° 332  
13.5.12

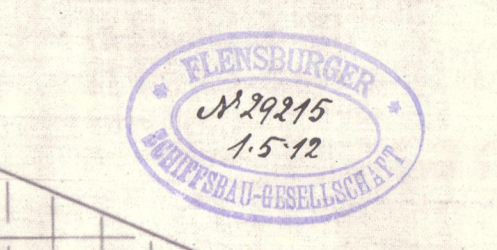



RETURN

Longitudinal & Deck plans




332

Hamburg ~~226/11~~

Hamburg letter

9/5/12

20-7-12

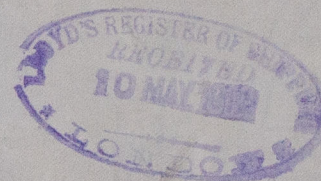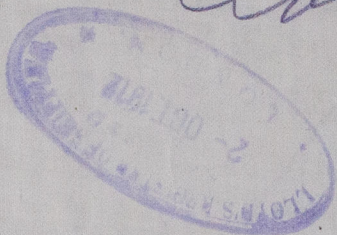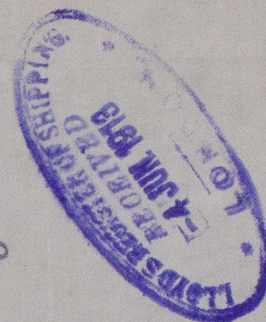

HAMBURG Report Not ~~2482~~  
13482



© 2020

Lloyd's Register  
Foundation

W963-0028