

2.2 "Redgarret" No 2214228

CLASS LLOYDS' + 100 A.I.



Midship Section
(as built)

S. S. "Ardgantock"

Messrs Ferguson Bros Ltd

No 273

Grk. Report No 17225.

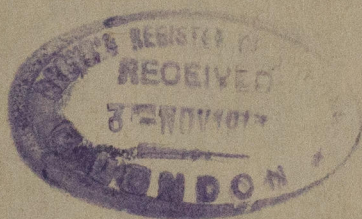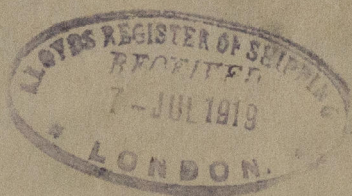

Lloyd's Register
Foundation

W 968-0083