
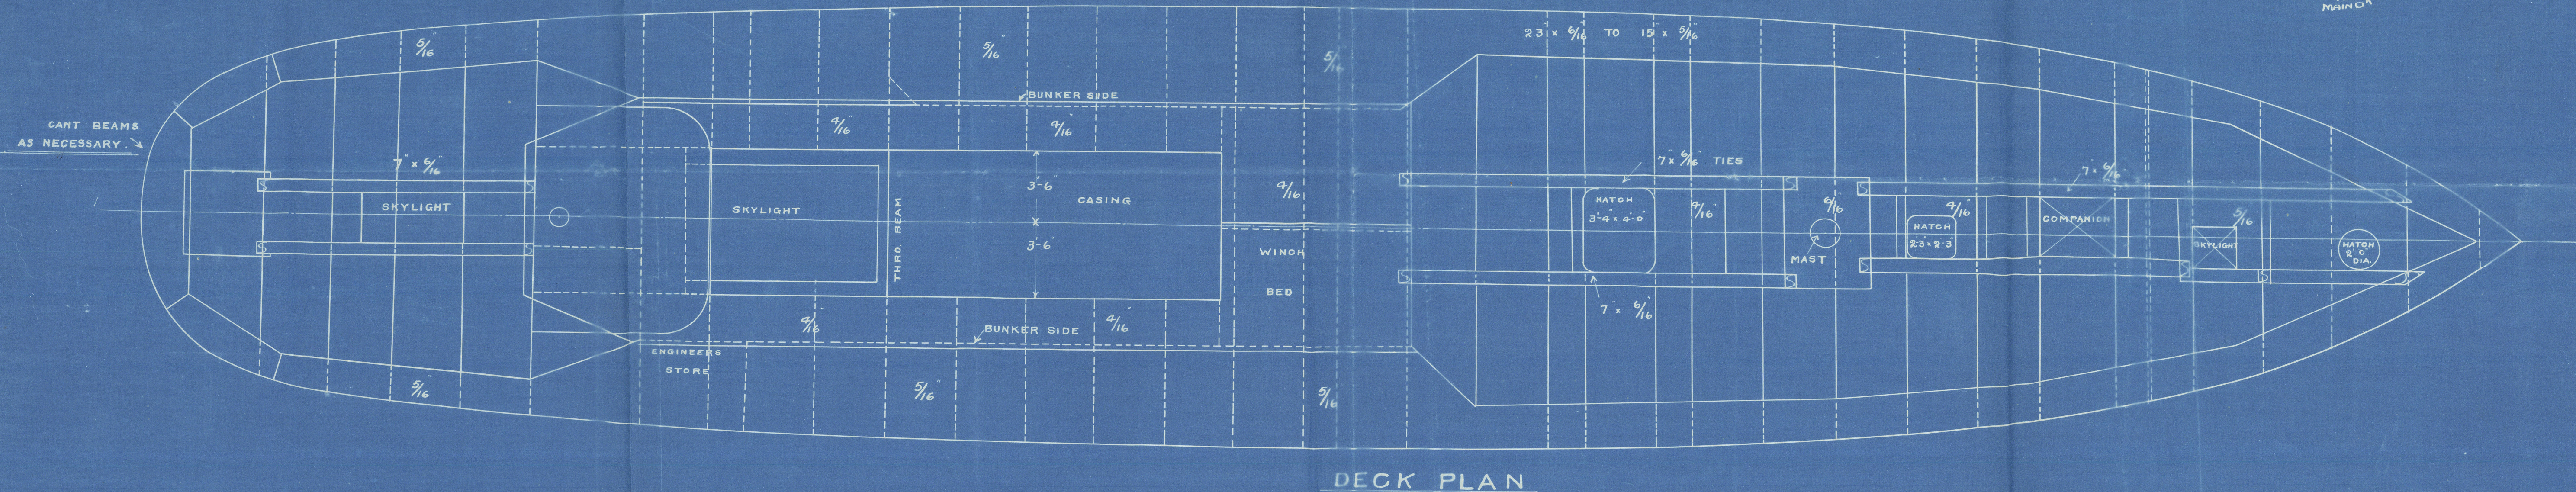


N^{os} 498 TO 502
PROFILE & DECK PLAN
DIMENSIONS 108'-4" B.P. x 21'-6" ex. x 11'-6" HoLD.
SCALE 1/4" = 1 FOOT.
TO CLASS 100 A.I. FOR FISHING PURPOSES

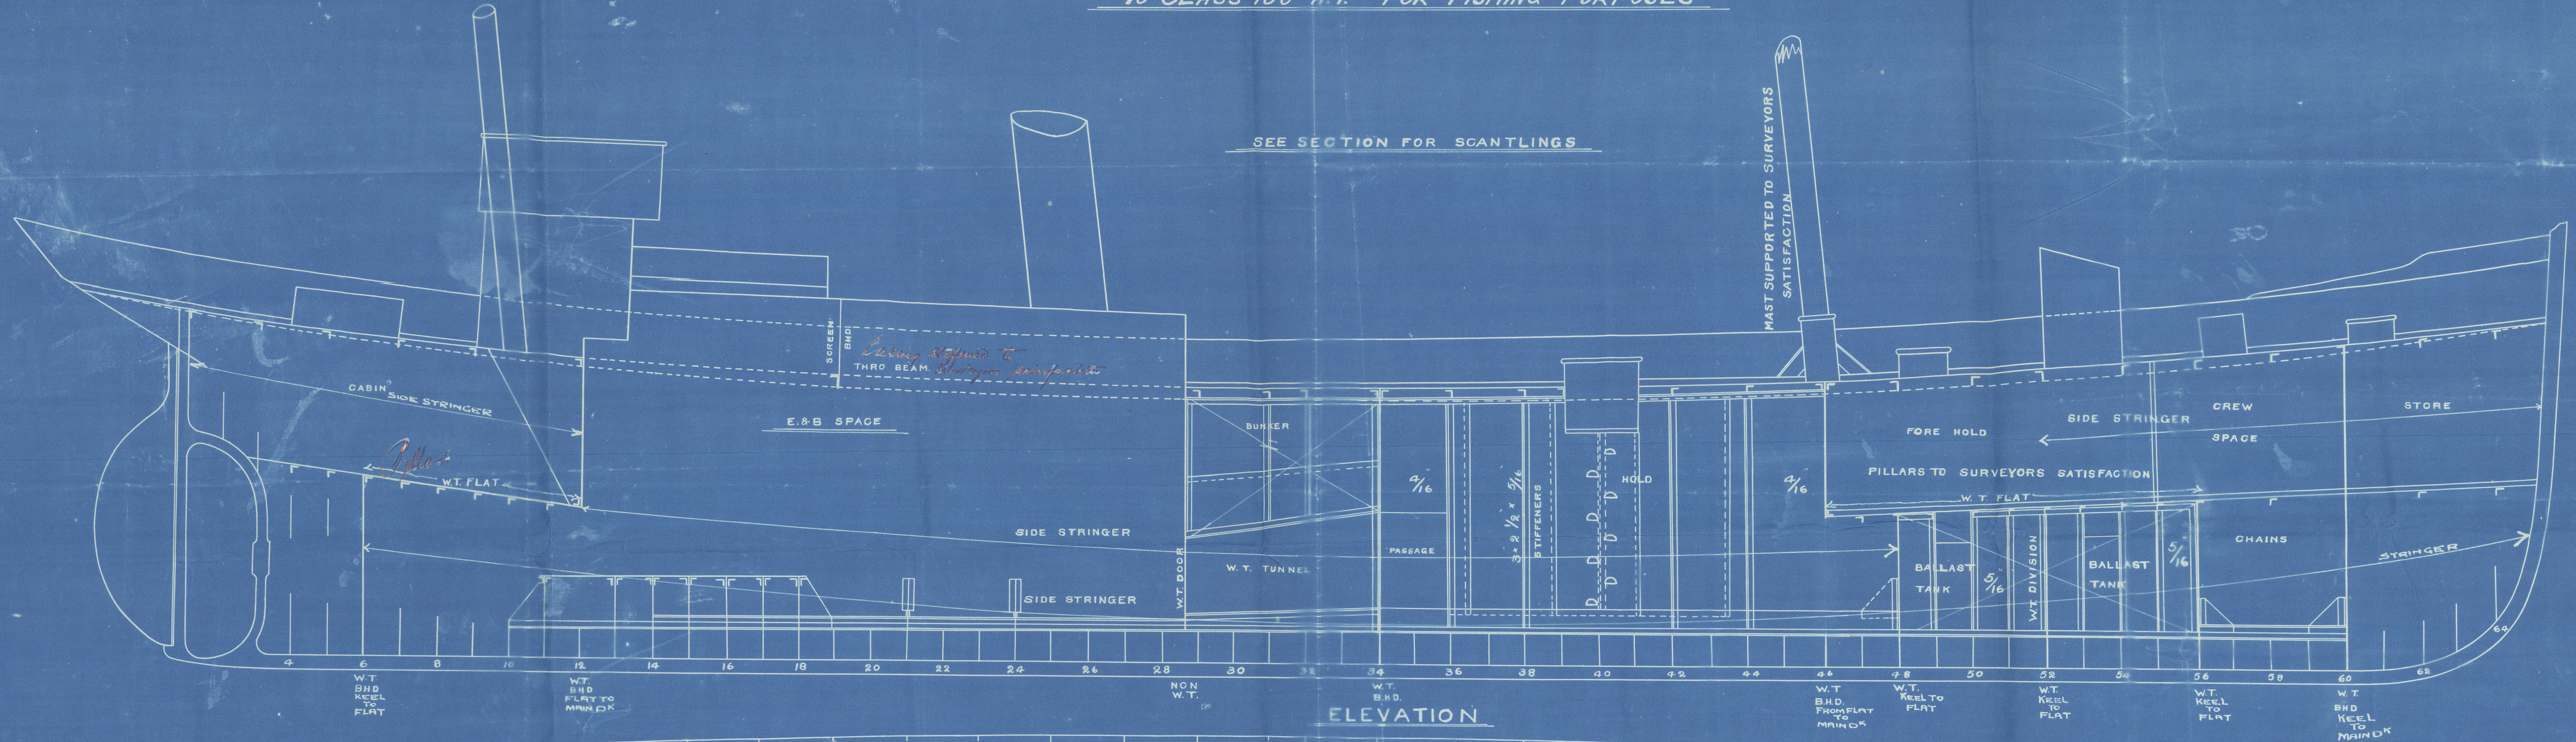

Charles S. & E. C.

Nº 4985502

Duplicate,

Profile & Deck.

Nº 499. "Arran."

Hull Report No 17036

W969-0007

RETAIN



© 2020

Lloyd's Register

Foundation