



13.2.12

LONGITUDINAL AND DECK PLAN

S.S. N°19

DIMENSIONS 240'-9" x 35'-10" x 18'-10" MLD

Scale $\frac{1}{8}$ in = 1 ft

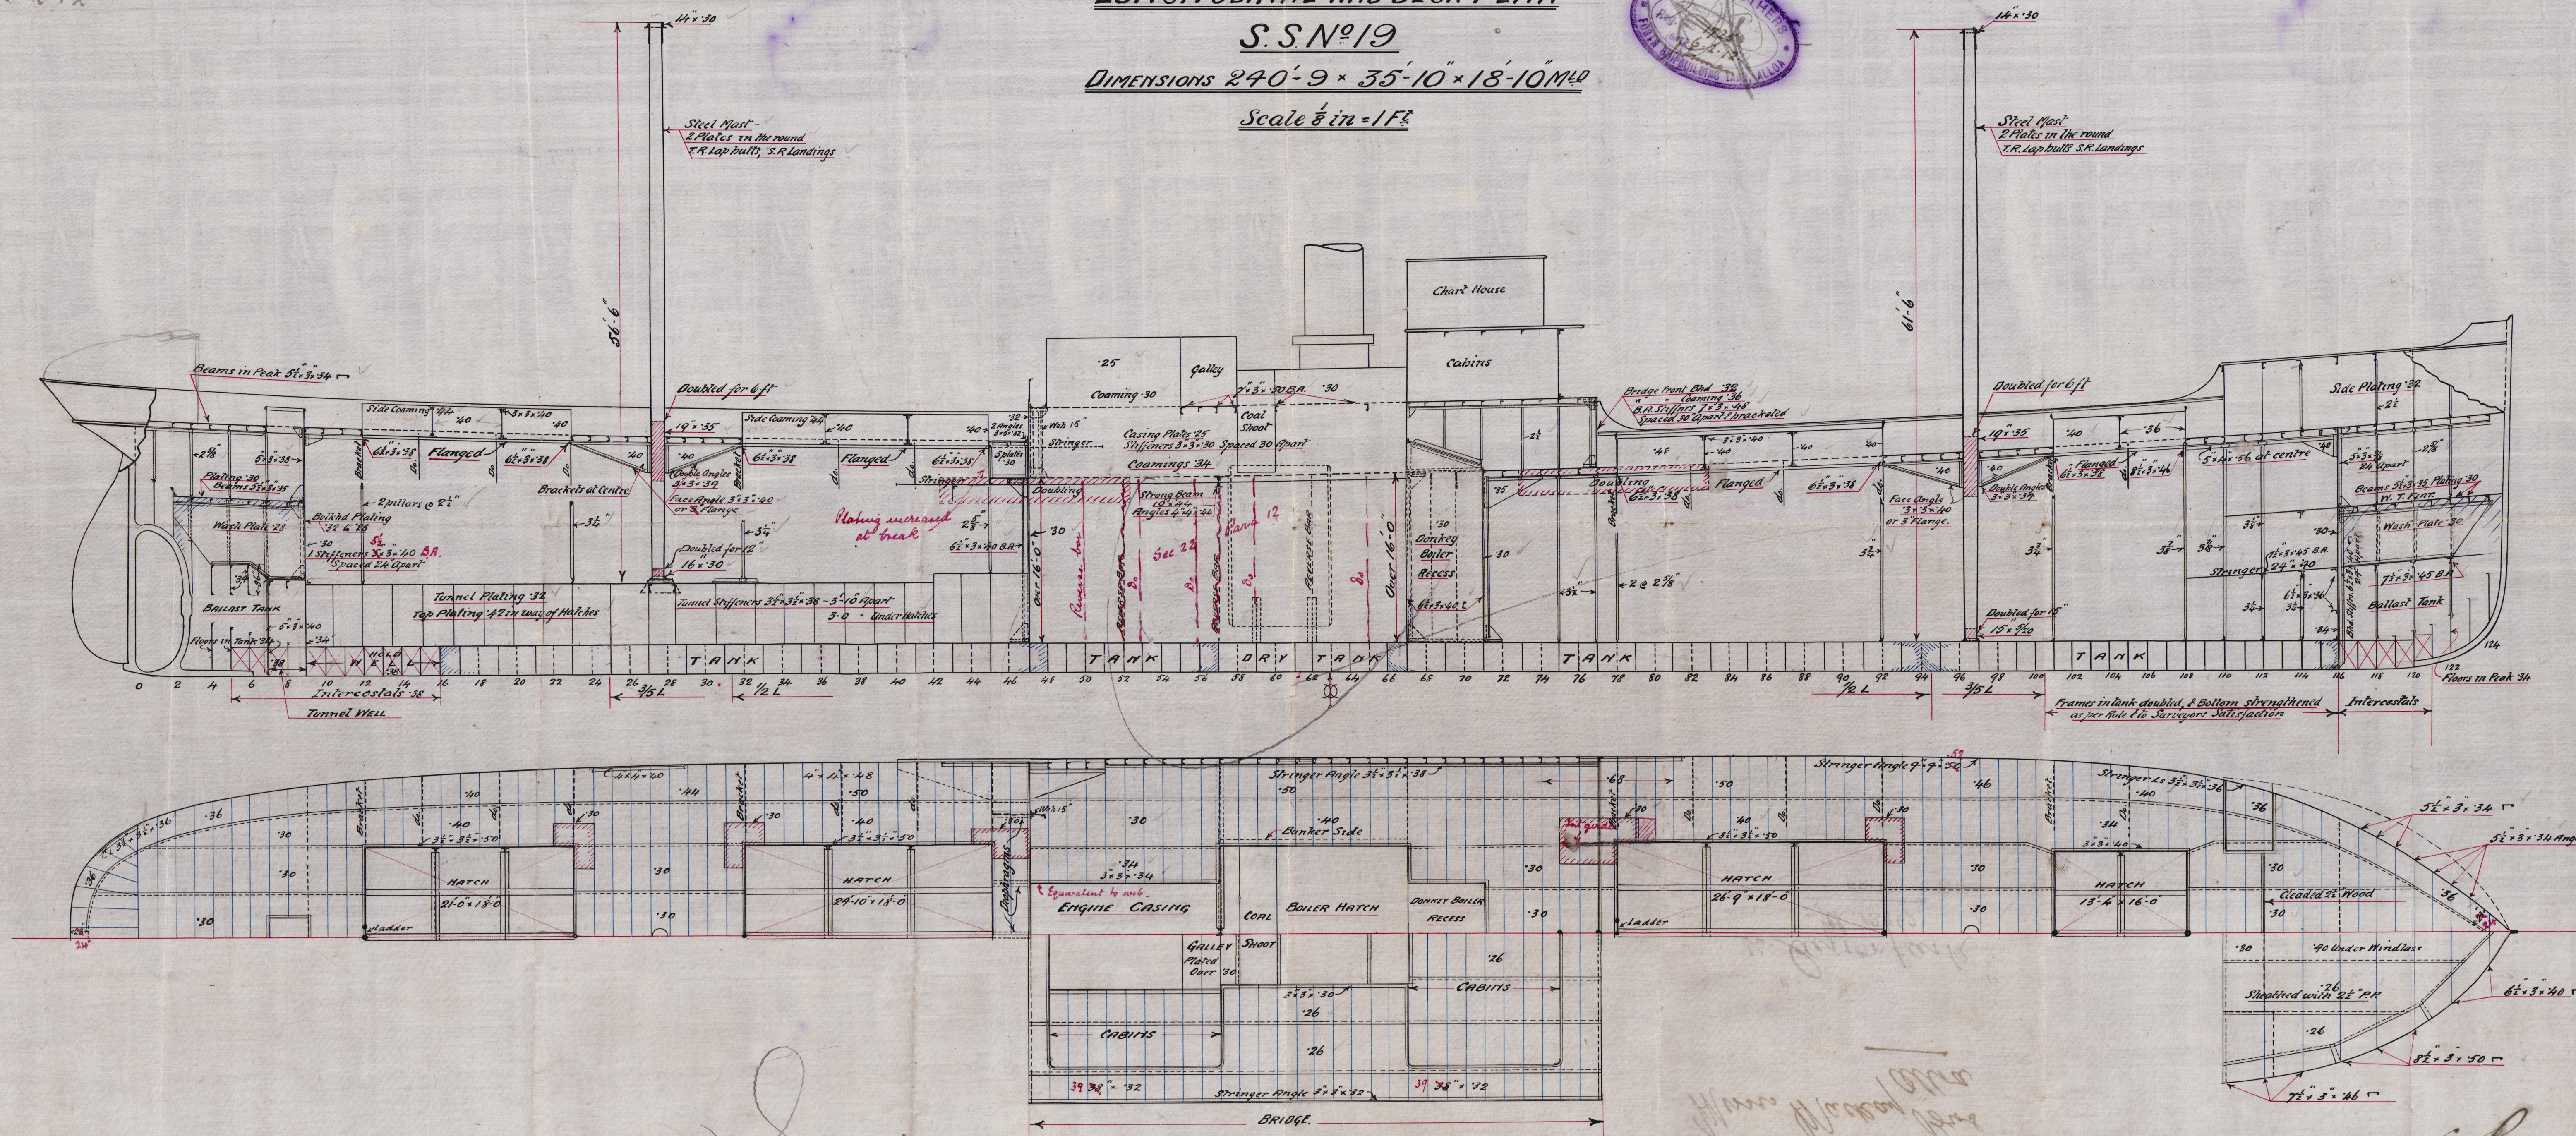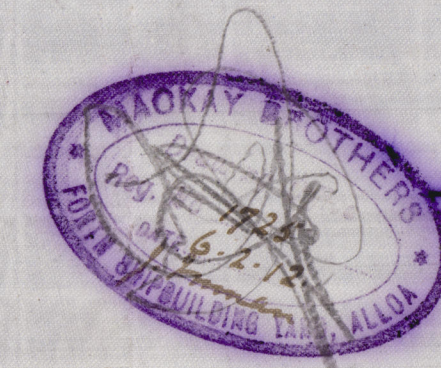

SS. N° 19 LONGITUDINAL AND DECK PLAN

S. S. N° 19

Profile Plan

Messrs Mackay Bros
Alloa

"Carronpark"
Stk. 13862

FRI. NOV. - 8. 1912

Wm Fozman

W97-0023



© 2019

Lloyd's Register
Foundation