

13.2.12

## - EQUIPMENT -



1 <sup>st</sup>	Bower Anchor	30½ cwt Stockless
2 <sup>nd</sup>	"	30½ "
3 <sup>rd</sup>	"	26 "
1	Stream "	7½ " Ex Stock
1	Kedge "	4½ "
240	Fathoms 1½	Stud Chain Cable
75	"	¾ Steel wire (for stream chain)
75	"	¾ " " 815 fathoms Hemp Spring
2 of 90	"	2½ " " } Steel wire with
2 of 90	"	2 " " } Owner's consent

## MIDSHIP SECTION

S.S. N°19

DIMENSIONS 240'-9" x 35'-10" x 18'-10" MOULDED.

SCALE ½ IN = 1 FT

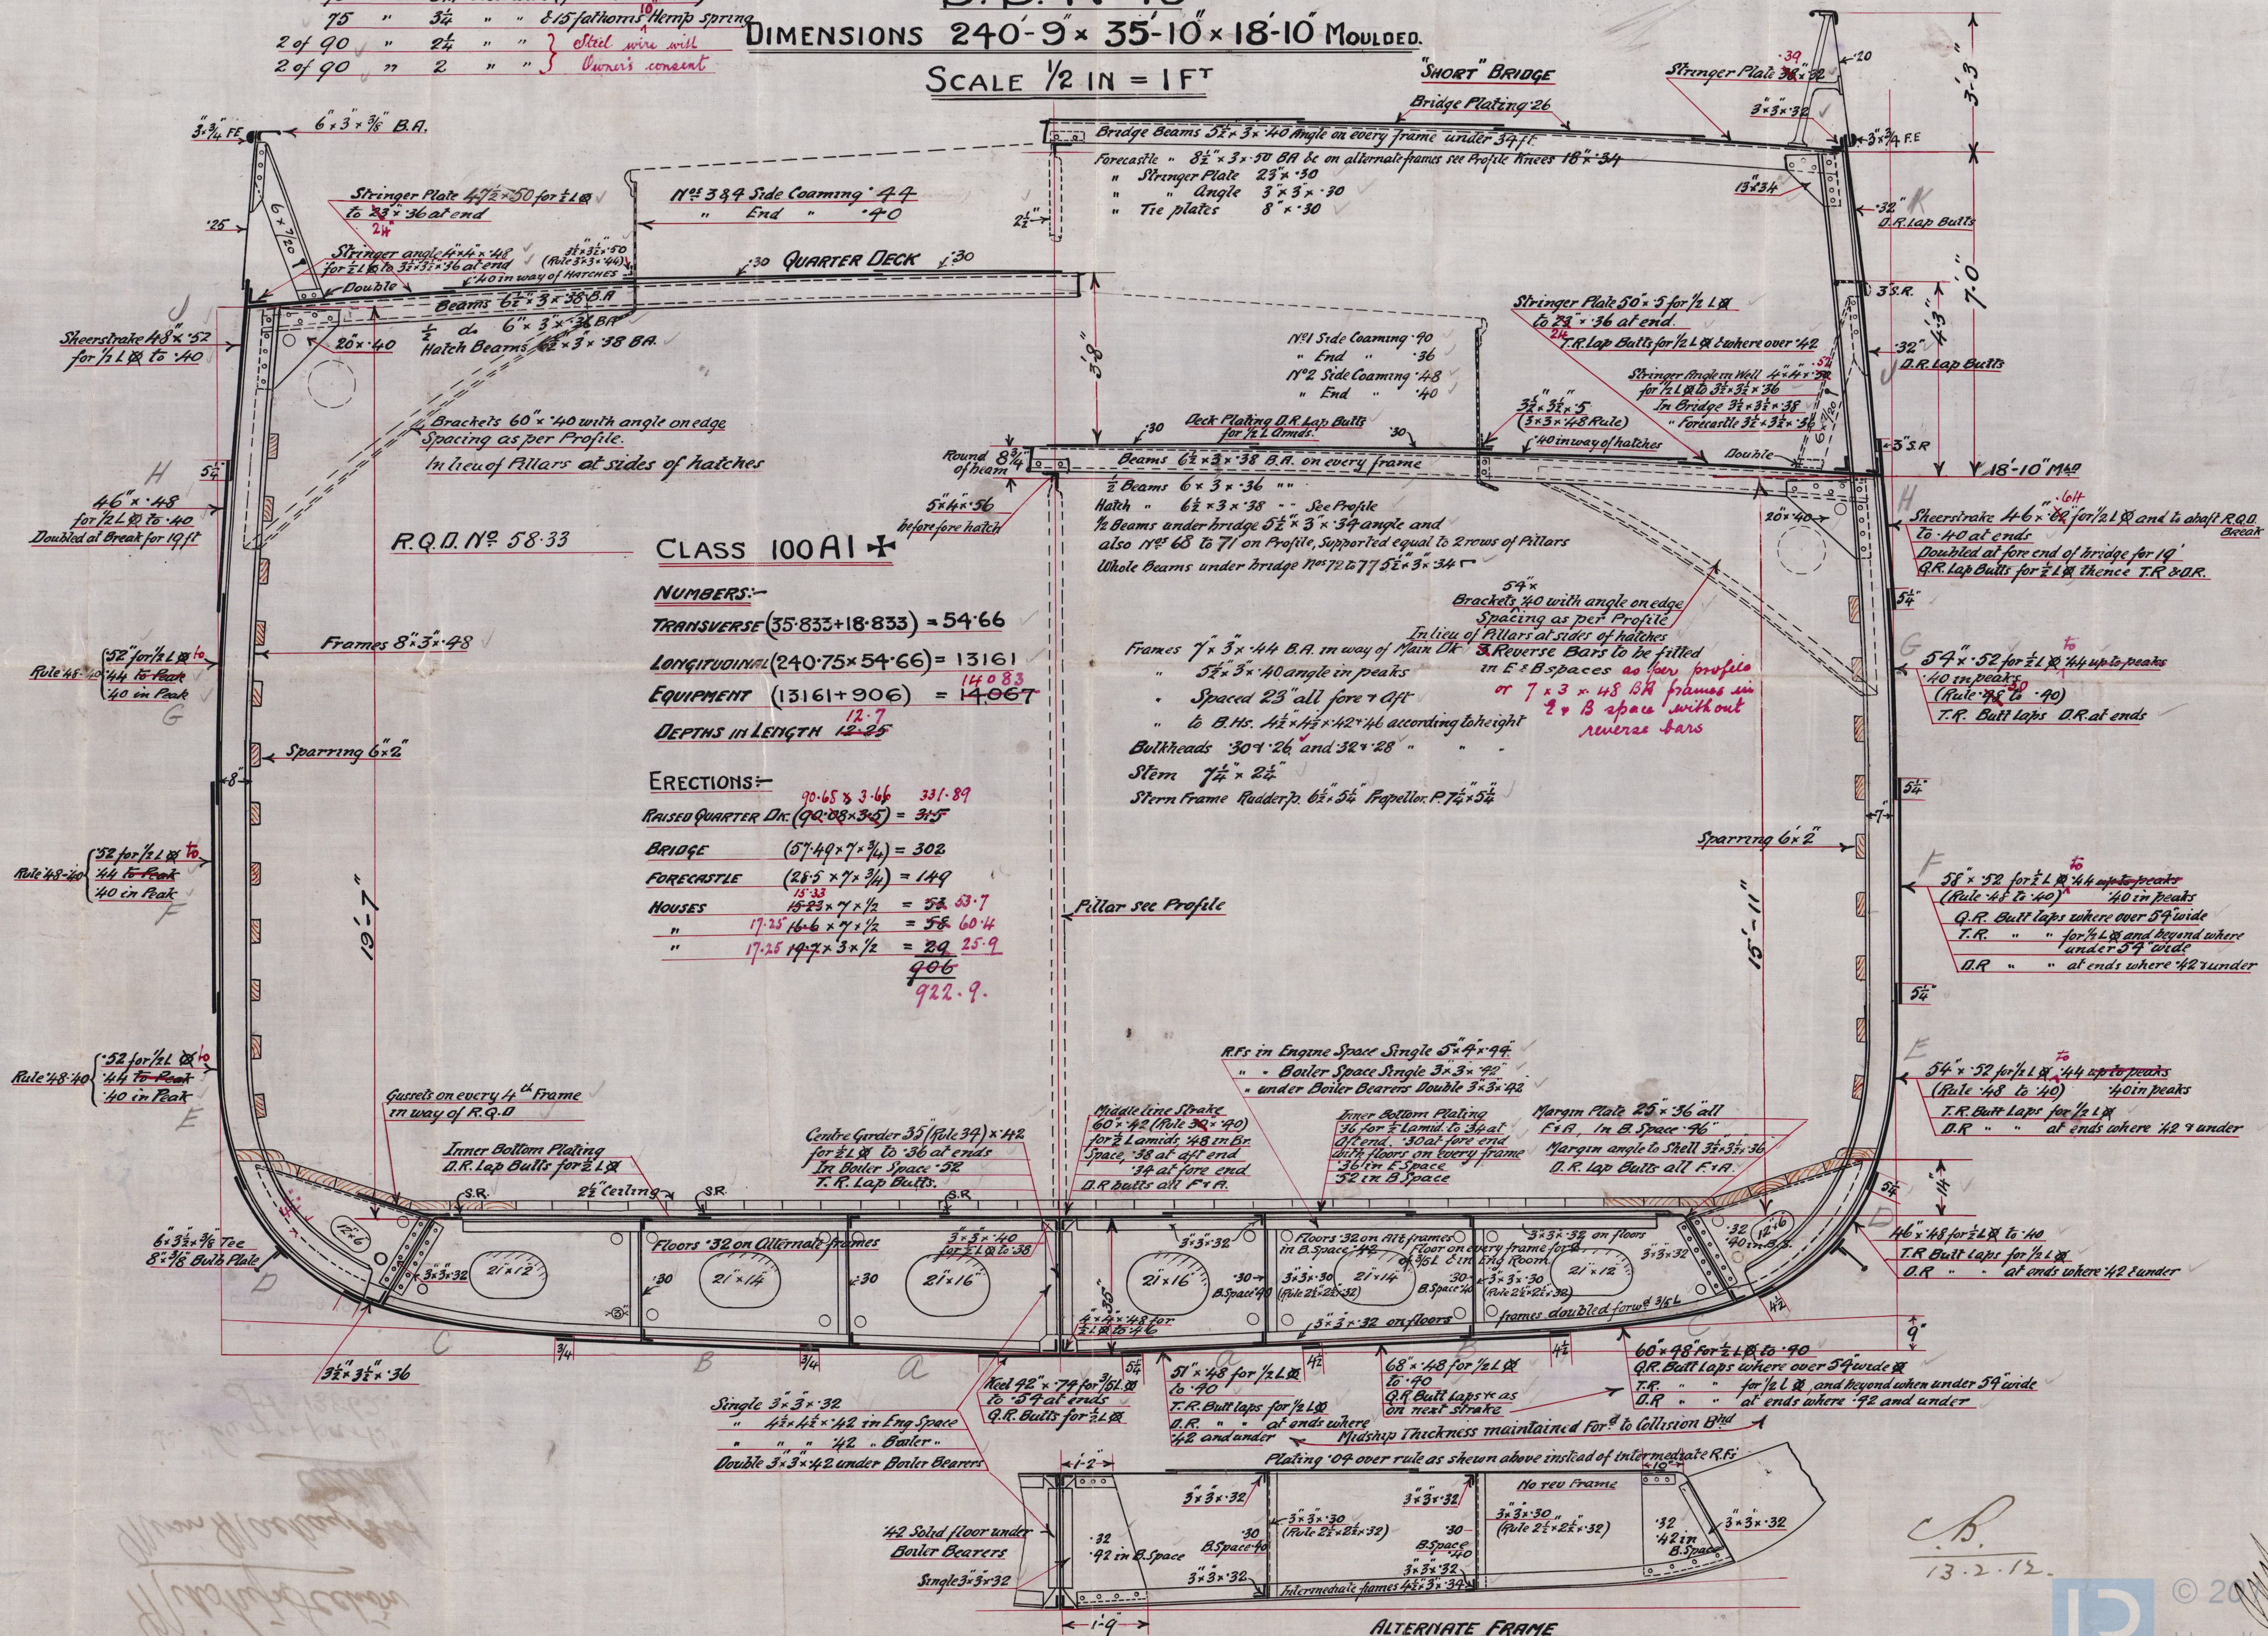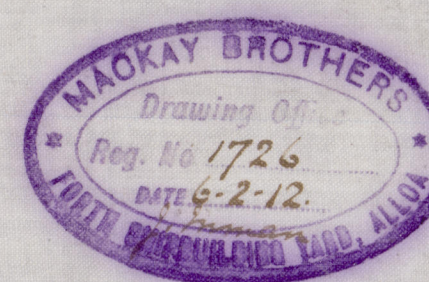




S.S. N° 19  
Midship Section  
Mess Mackay Bros  
Calcutta  
S.S. "Carronpark"  

FRI NOV - 8. 1912

W 97-0024

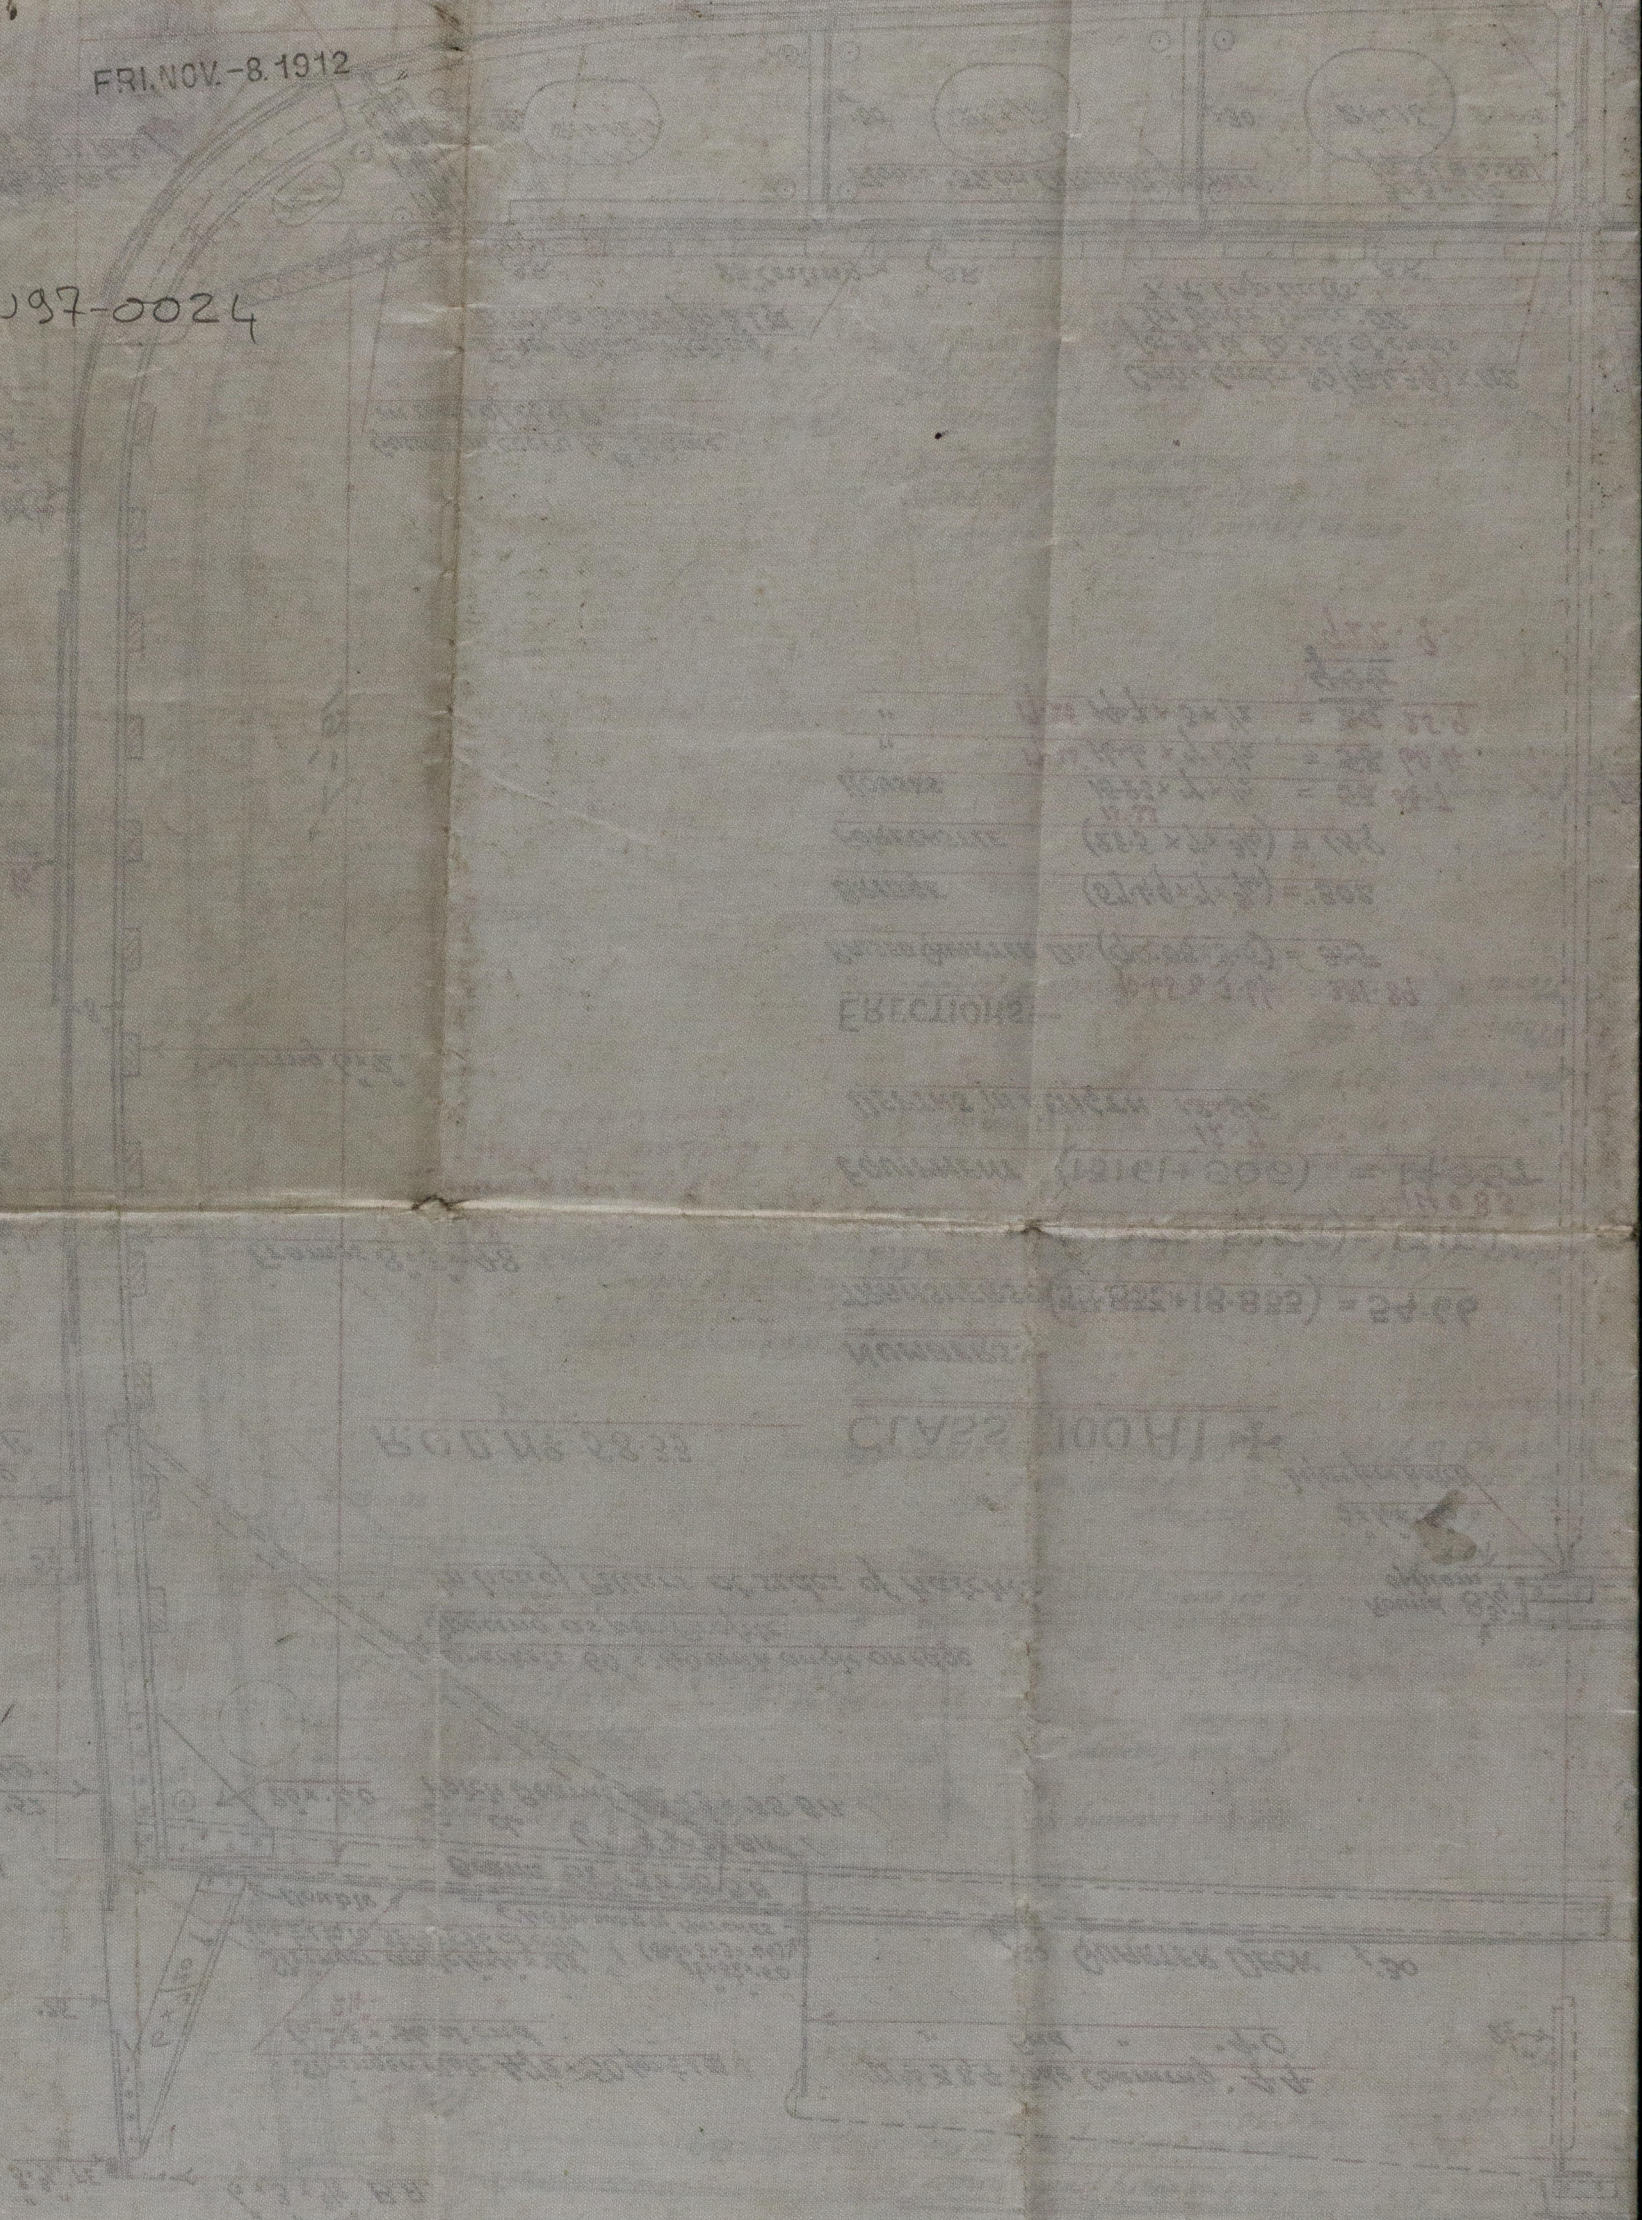

SCALE 1/2"  
 2.21  
 MIDSHIP SECTION

S.S. N° 19 MIDSHIP SECTION

