


SCALE 1/2" = 1 FOOT
CLASS 100 ALLLOYDS
356.0" x 44.2 MLD x 26.6" MLD

CLASS 100 AI LLOYDS

$$356'-0'' \times 44'-2 \text{ MLD} \times 26'-6'' \text{ MLD}$$

EQUIPMENT NO.

LONGITUDINAL NO		25866.00
POOP & FORECASTLE	$72 \times 17 \times 25 = 2475$	2475
BRIDGE	$128 \times 62 \times 75 = 59680$	59680
DECKHOUSES	$115 \times 0.0 \times 7.50 \times .50 = 431.25$	431.25
		27445.59
		27445.59

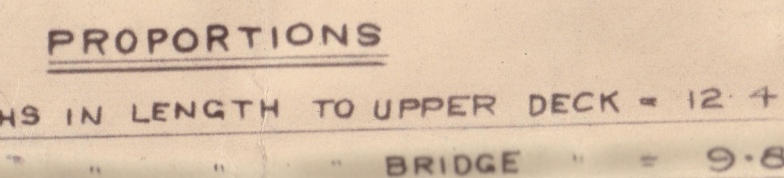

PILLARS

16 TO 18 FEET AS SHOWN =	4 1/4 DIA
18 " 20 " " " " "	5 1/4 "
20 " 22 " " " " "	5 3/4 "
22 " 24 " " " " "	5 5/8 "

UNDER ACCOMMODATION REDUCED $\frac{1}{2}$ DIA

PILLARS IN WAY OF TUNNEL

10 TO 12 FEET AS SHOWN	= $4\frac{3}{8}$ DIA
12 " 14 " " "	= $4\frac{1}{2}$ "
14 " 16 " " "	= $4\frac{1}{2}$ "

RIVETING

[illegible]

NOTE: BUTTS OF ALL STRAKES OVERLAPPED

60
64
E

.58 FOR 1/2 LENGTH ✓
.44 AT ENDS ✓
+ .04 IN LIEU OF STRINGERS
FOR 1/2 LENGTH = .62 ✓

.58 FOR $\frac{1}{2}$ LENGTH
.44 AT ENDS

C.7.
11/4/10

B 574/10

W97-005

MID. SECTION

PROFILE

Sir J. LAINE & Sons

No 630

S. S. UMONH.

Rpt No 2 Ht 50.

W97-0053



© 2019

Lloyd's Register
Foundation