


SCALE $\frac{1}{8}'' = 1$ FOOT.

LONGITUDINAL N° 25866

" " " " BRIDGE " 9-8


[illegible]

TABLE GIVING DEPTHS OF BULKHEADS					
		NO. OF BULKHEAD			
		37	65	106	141
DEPTH FROM TANK TOP TO UPPER DEK		27'-2"	26'-4"	26'-5"	28'
"	" " " " 2 ND DEK	13'-2"	17'-4"	17'-5"	15'-

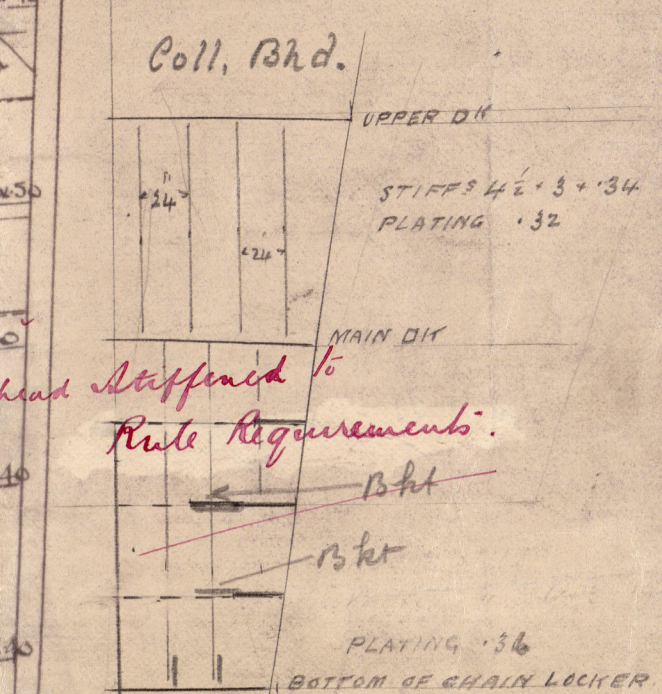

SIR JAMES LAING & SONS, LIMITED
 Date 28-3-10
 DRAWING OFFICE,
 No. 54
 DEPTFORD YARD, SHIRREDLAND.

© 2019
W97-0056
Lloyd's Register
Foundation


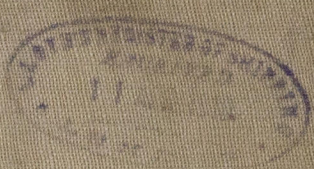


PROMISE

Sir J. Laing & Sons

No 630

S S "Umana"
SLO RPT 21030

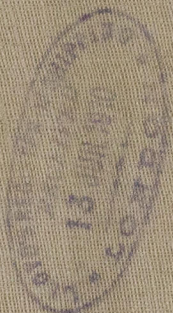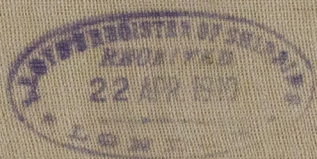

W97-0056



© 2019

Lloyd's Register
Foundation