


13.11.12  
18.12.12  
10.1.13  
21.1.13  
4.2.13.  
14.3.13.  
12.3.13.  
4.6.13.  
8.12.13.

N<sup>o</sup> 916-22  
PROFILE & DECK PLANS  
DIM<sup>ns</sup> 350' OBP x 47' OBP x 27' OBP  
TO CLASS LLOYDS 100 A1  
SCALE 1/8" = 1' 00"



N° 7762  
1<sup>st</sup> Nov. 1912.

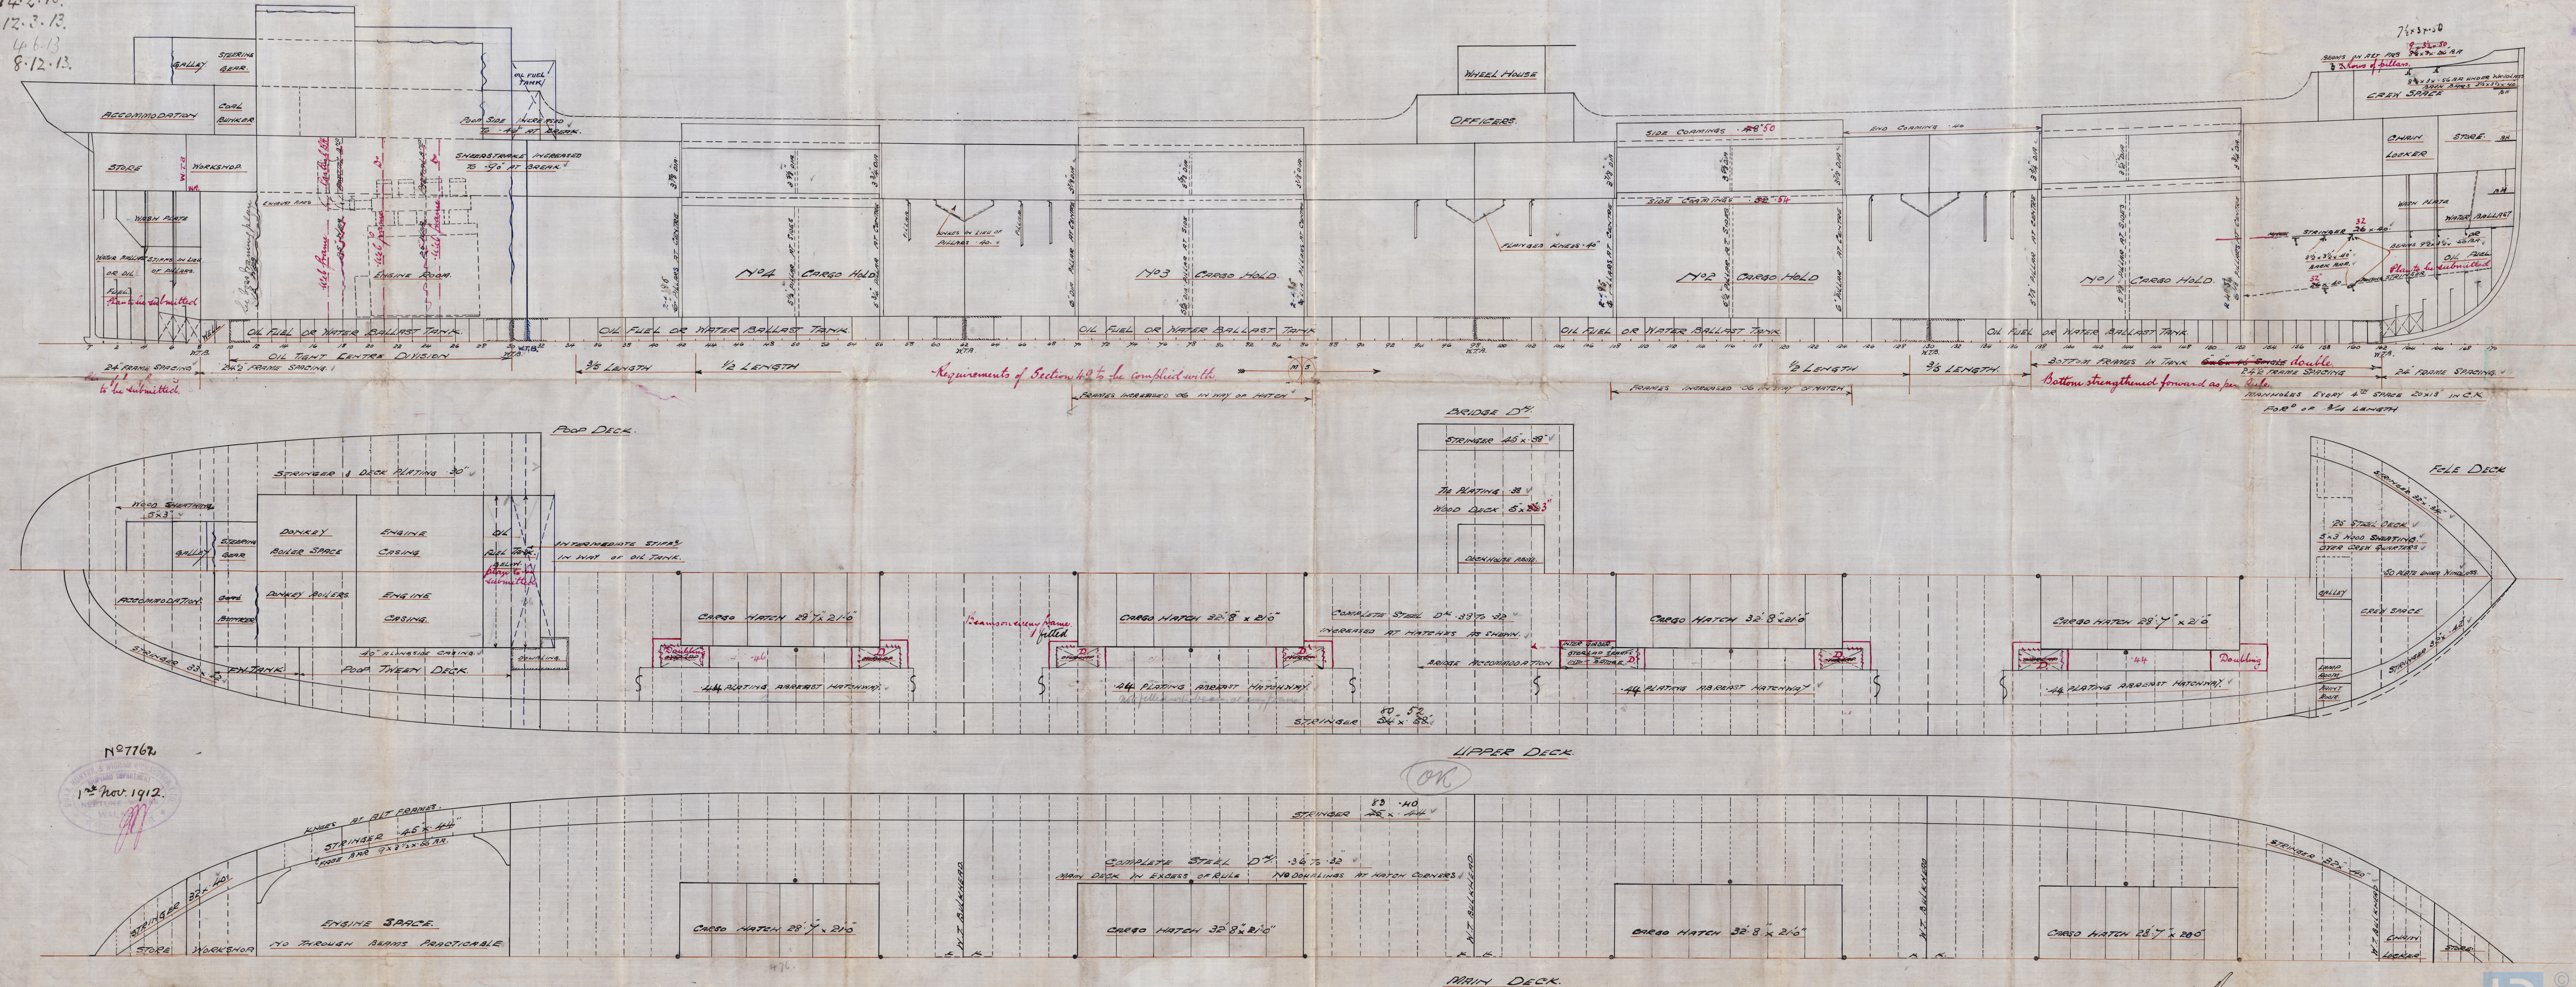

Swan Hunter &  
Cheyham Richardson

T.S.S. 916 - 922

Profile & Deck plan



W970-0064

see separate  
plans appd  
10/4/13

M.V. "ARUM"

NEWCASTLE-ON-TYNE

REPORT No. 66117

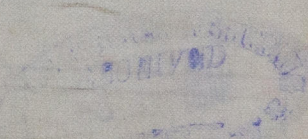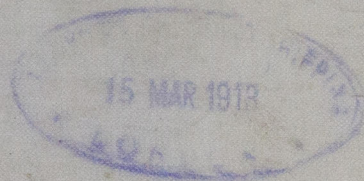

RETAIN



© 2020

Lloyd's Register  
Foundation